


MT BISCHOFF T. M. CO. REC.

CROSS LODGE

LONGITUDINAL SECTION

SCALE: 25 FT TO 1 INCH

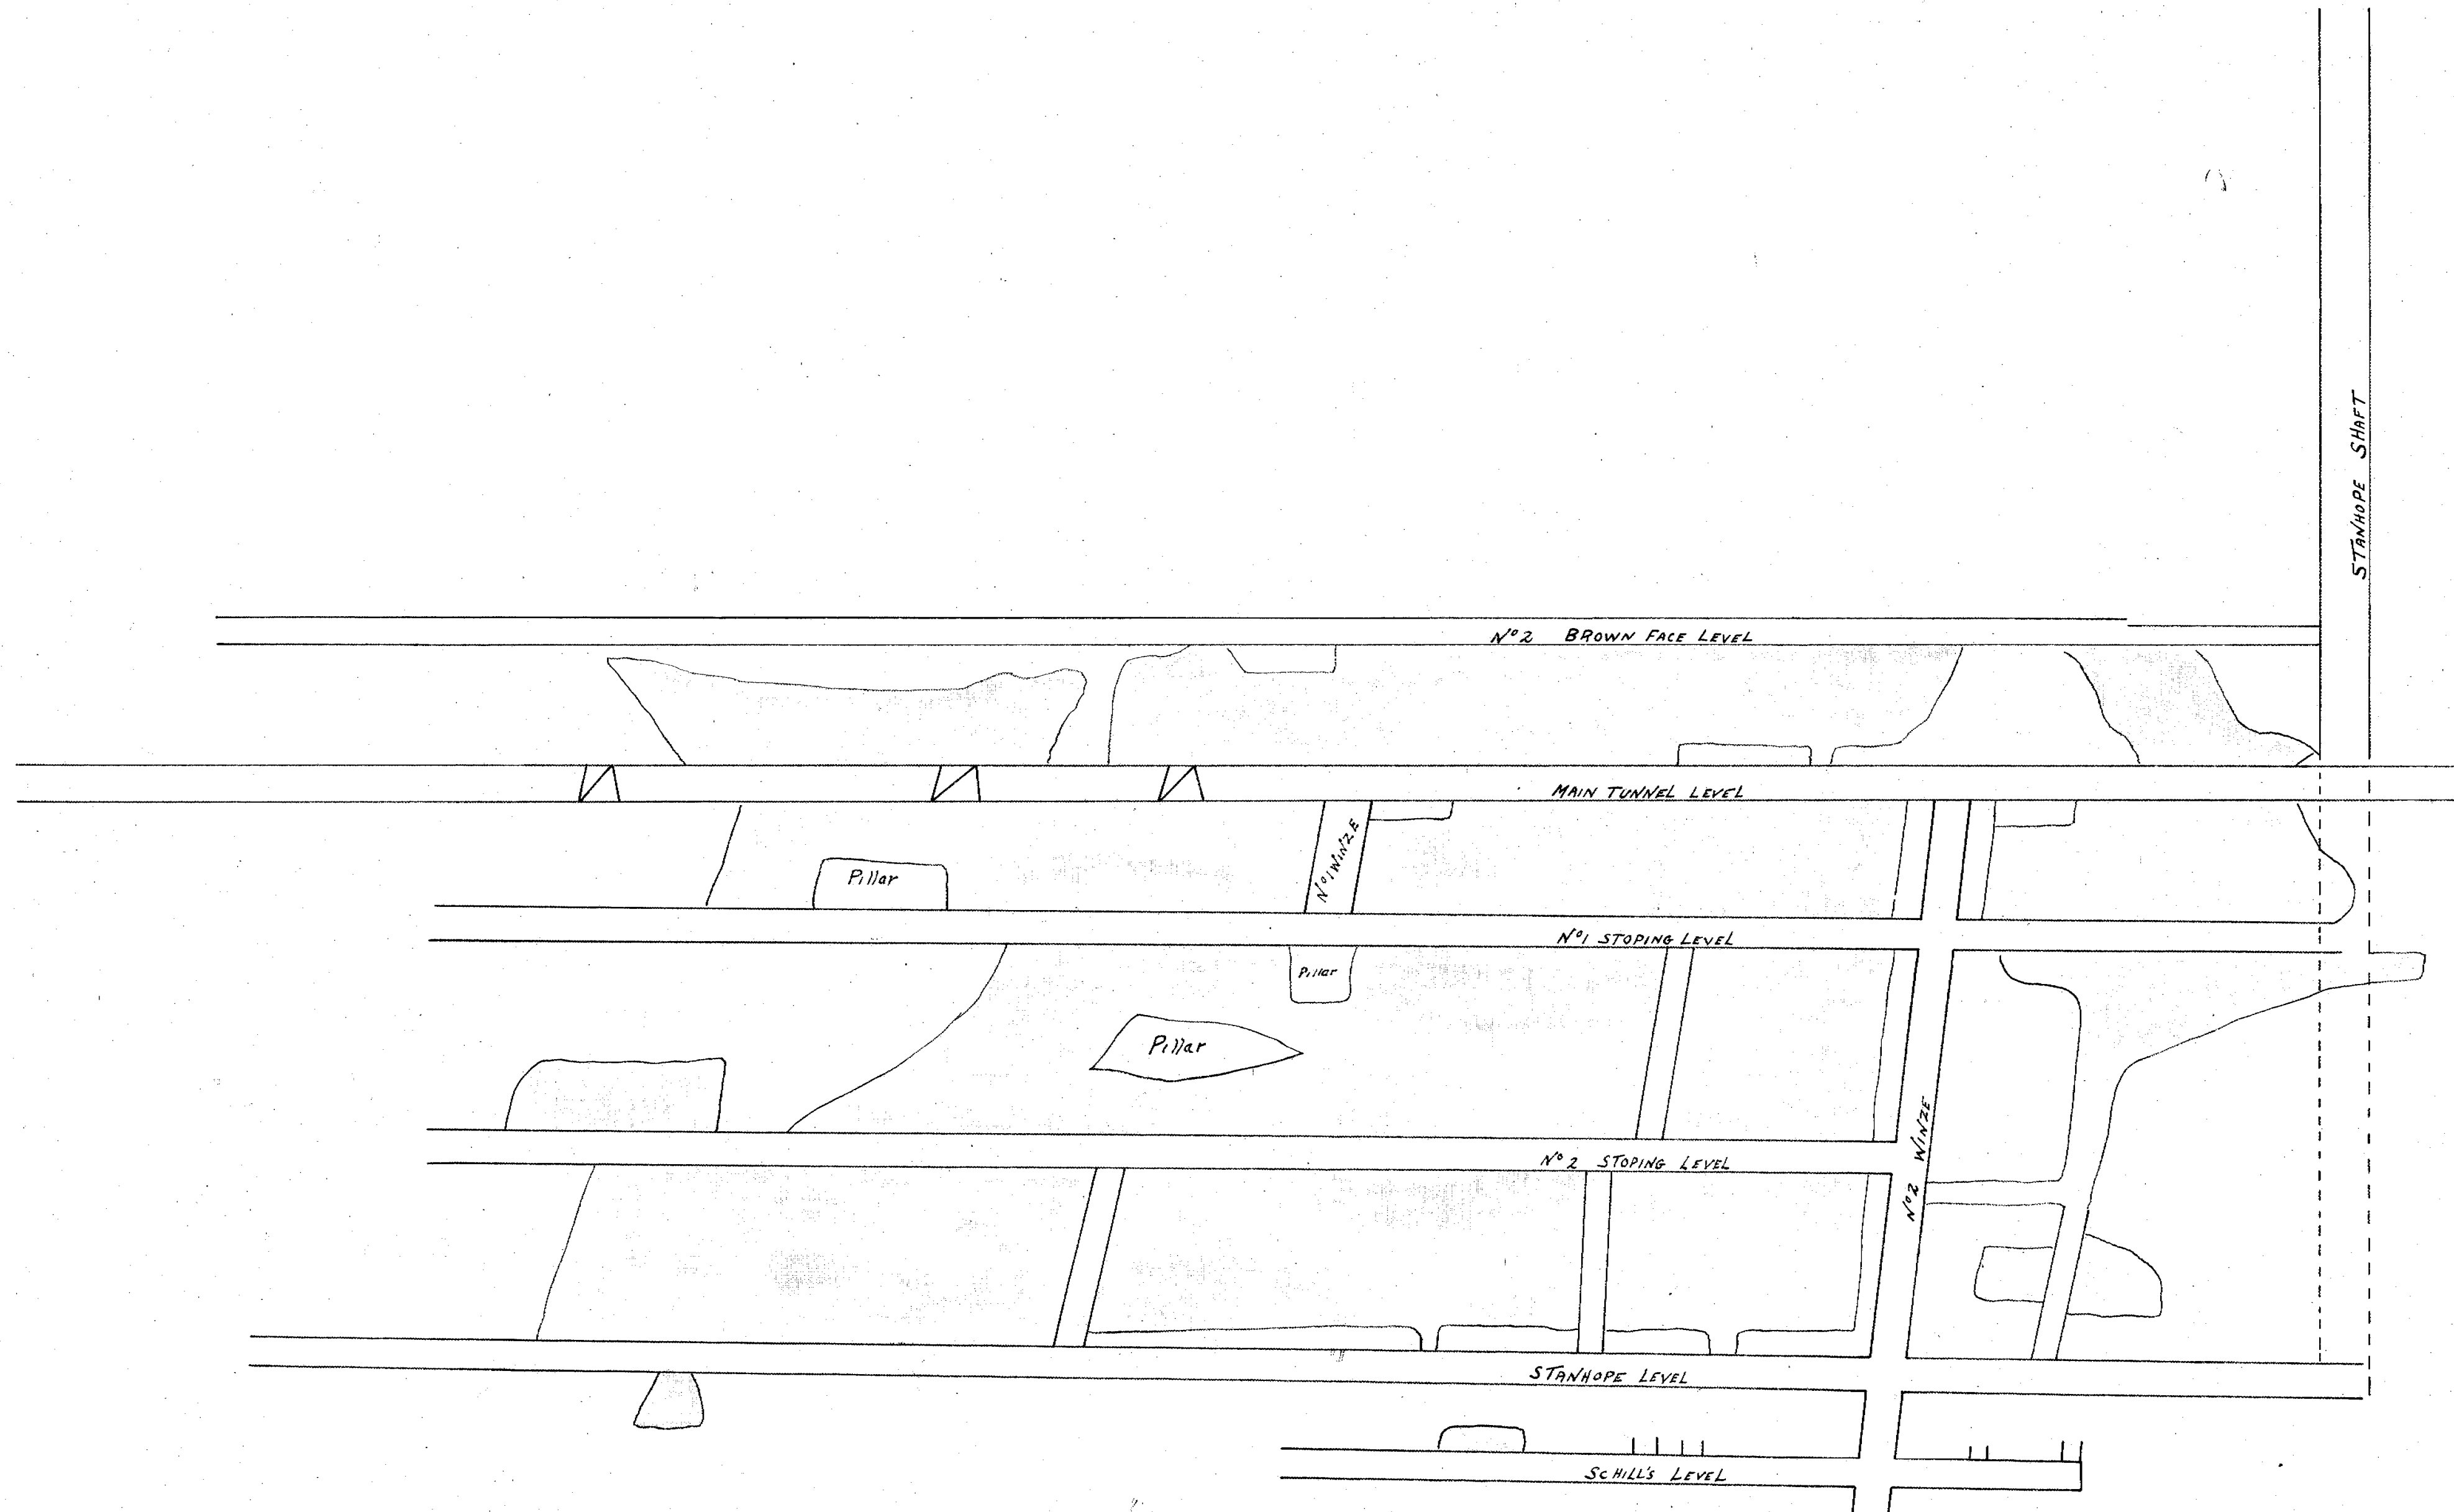

42-252

Work 1935-
Surveys W & D. Port.
not used 5" theodolite