


MT BISCHOFF T. M. CO. REC.

CROSS LODGE


TRANSVERSE SECTION

SCALE 25 FT TO 1 INCH

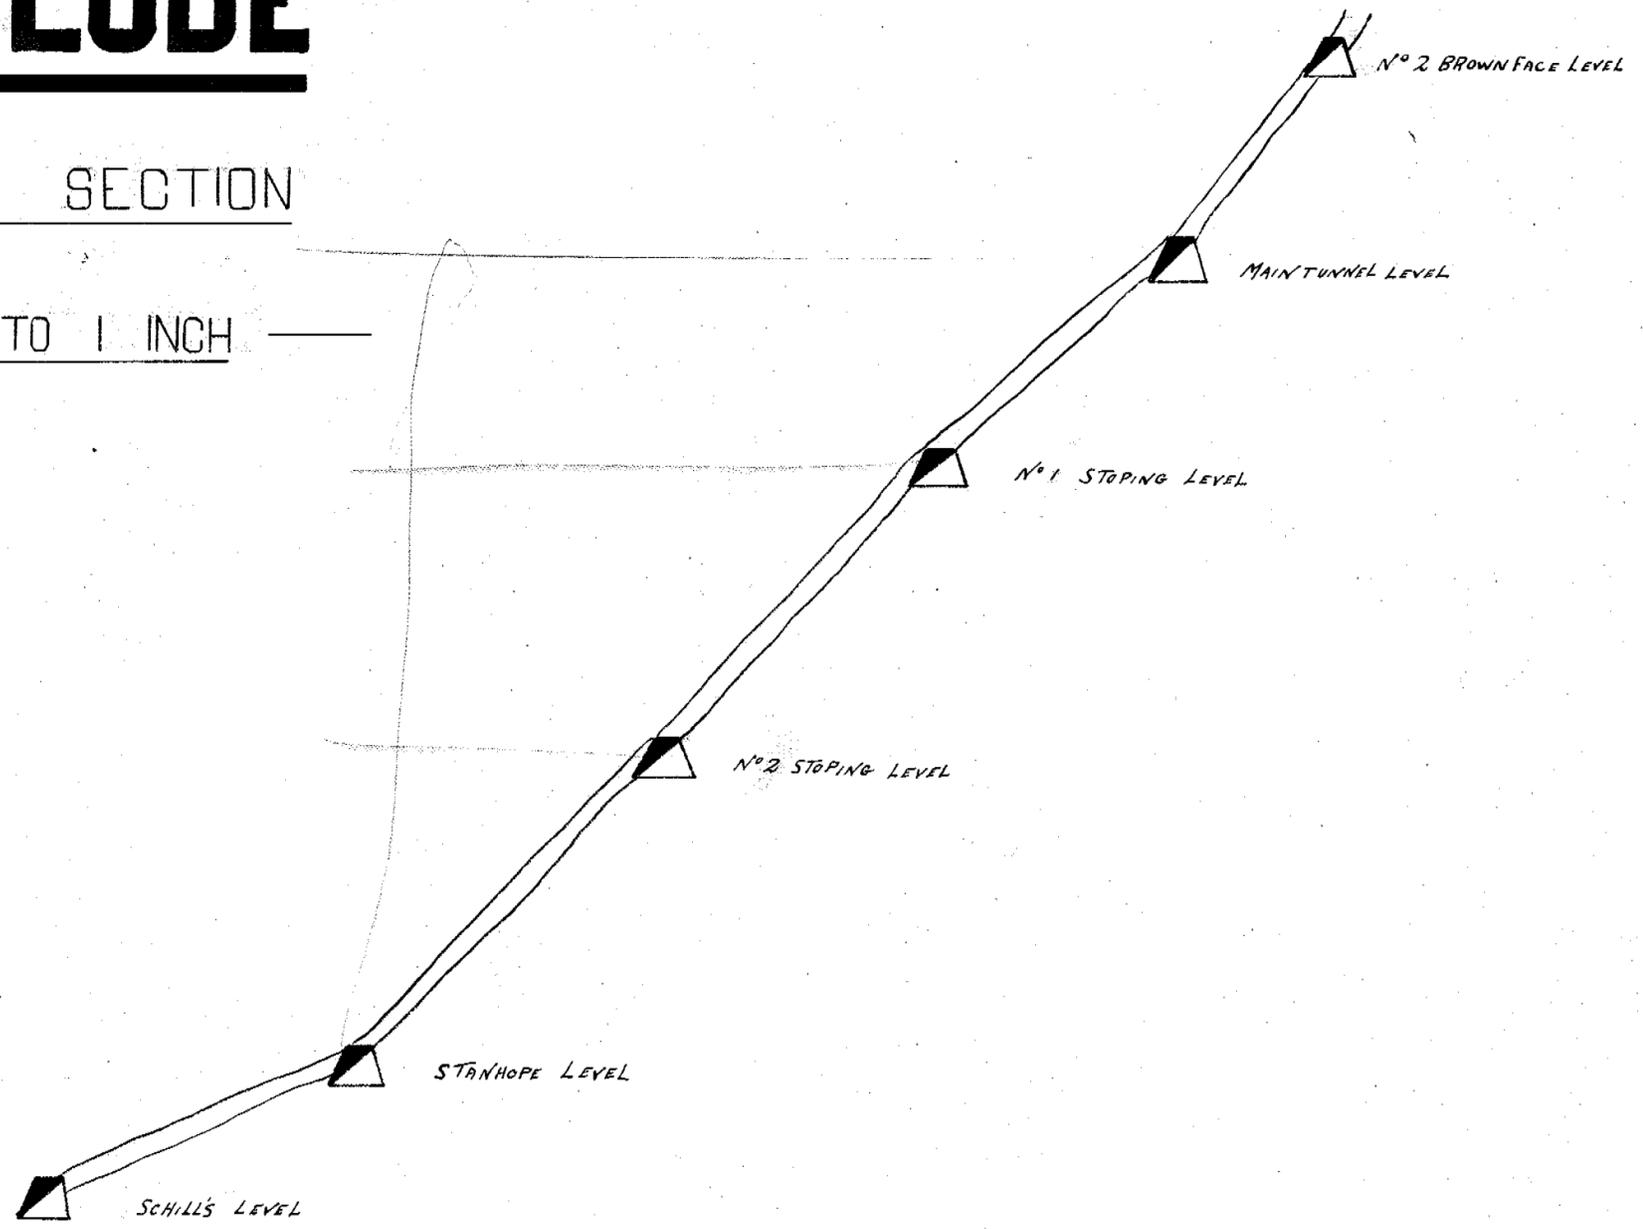

217-75

217-75

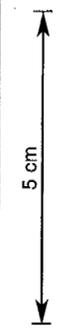

Work 1936
Survey M. H. D. etc.
with used 3" theodolite