


MT BISCHOFF T. M. CO. REC.

CROSS LODGE

TRANSVERSE SECTION

SCALE 25 FT TO 1 INCH

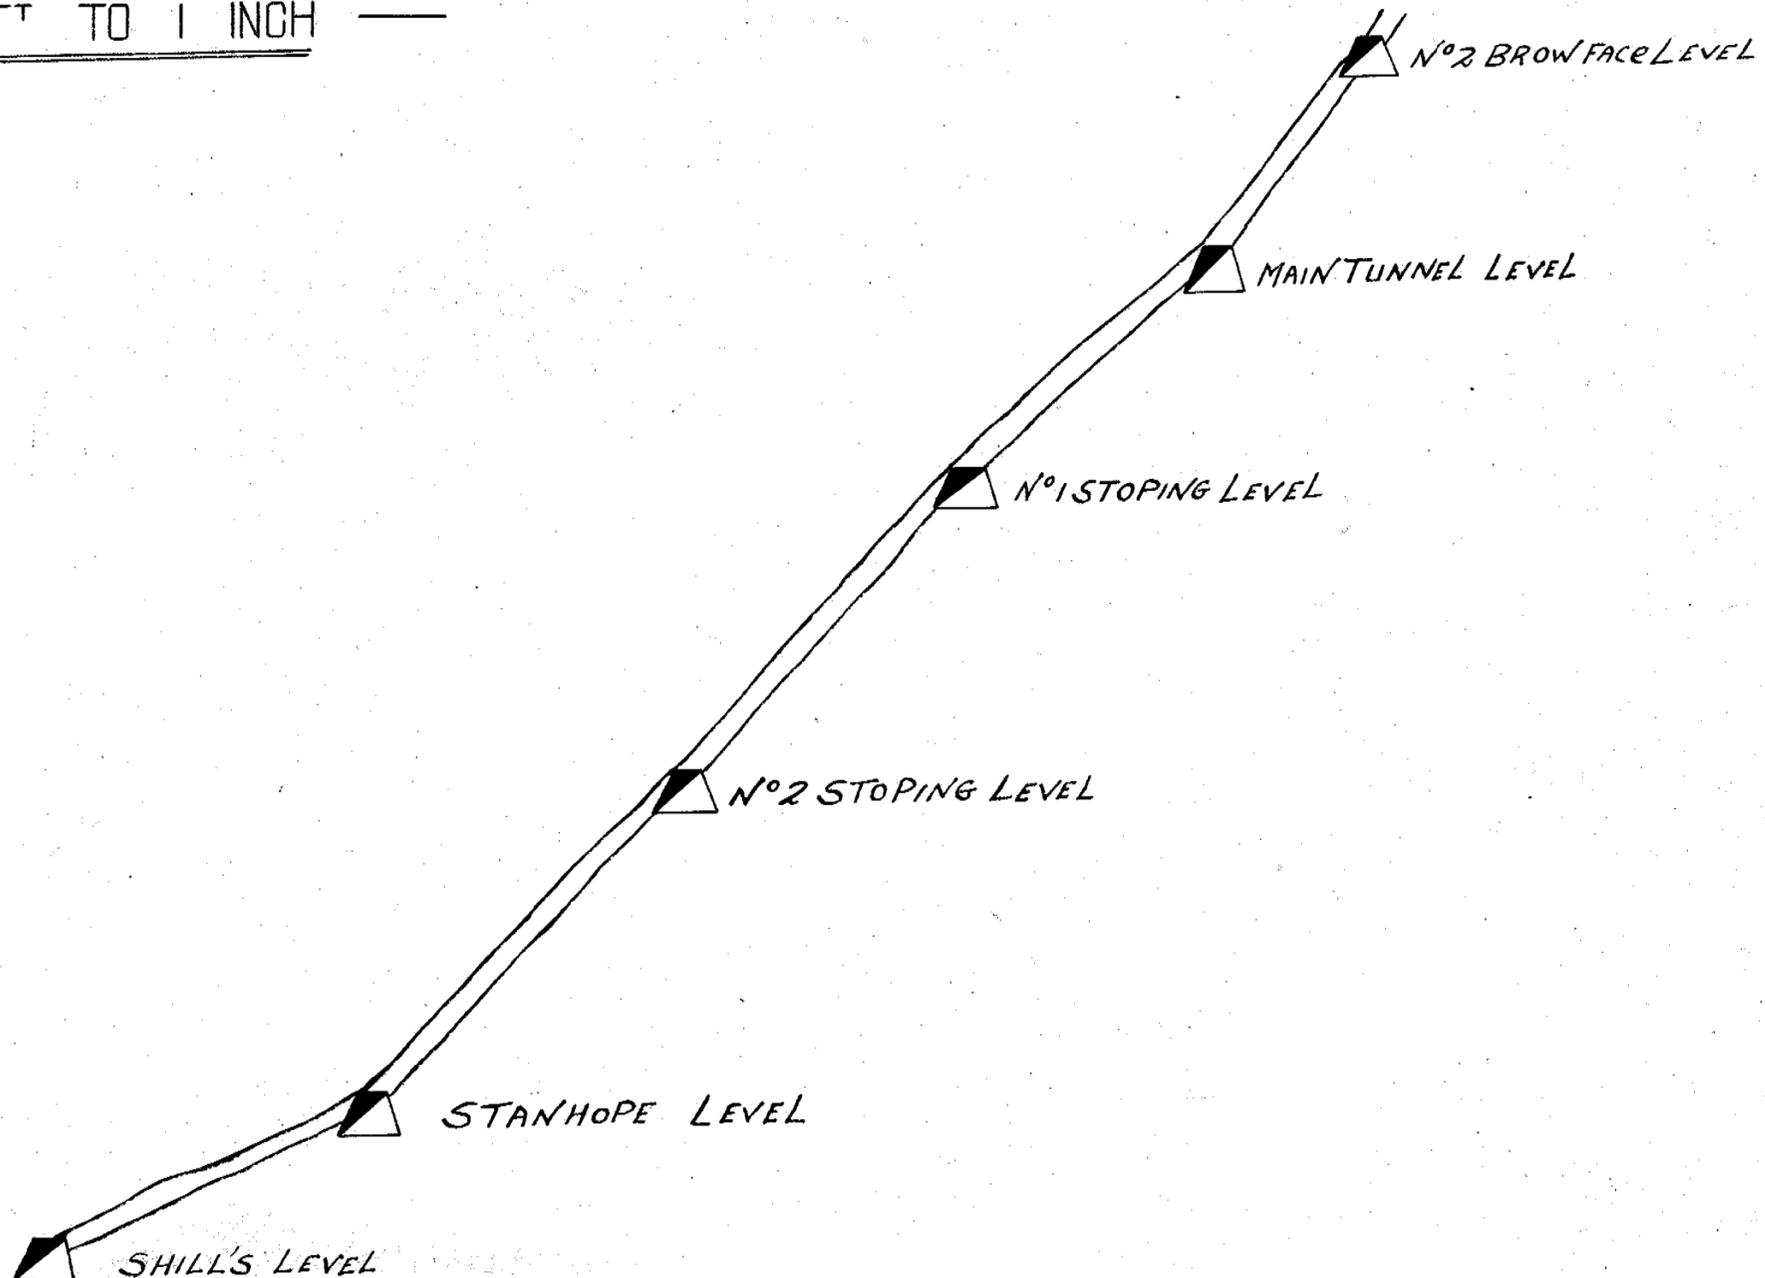

217-76



217-76

WORK 1936
INST. USED 5" THEODOLITE
SURVEYOR O. J. PATE
DATE 7th June 1937