


# MT BISCHOFF T. M. CO. REC.

## CROSS LODGE

SCALE: 25 FT TO 1 INCH

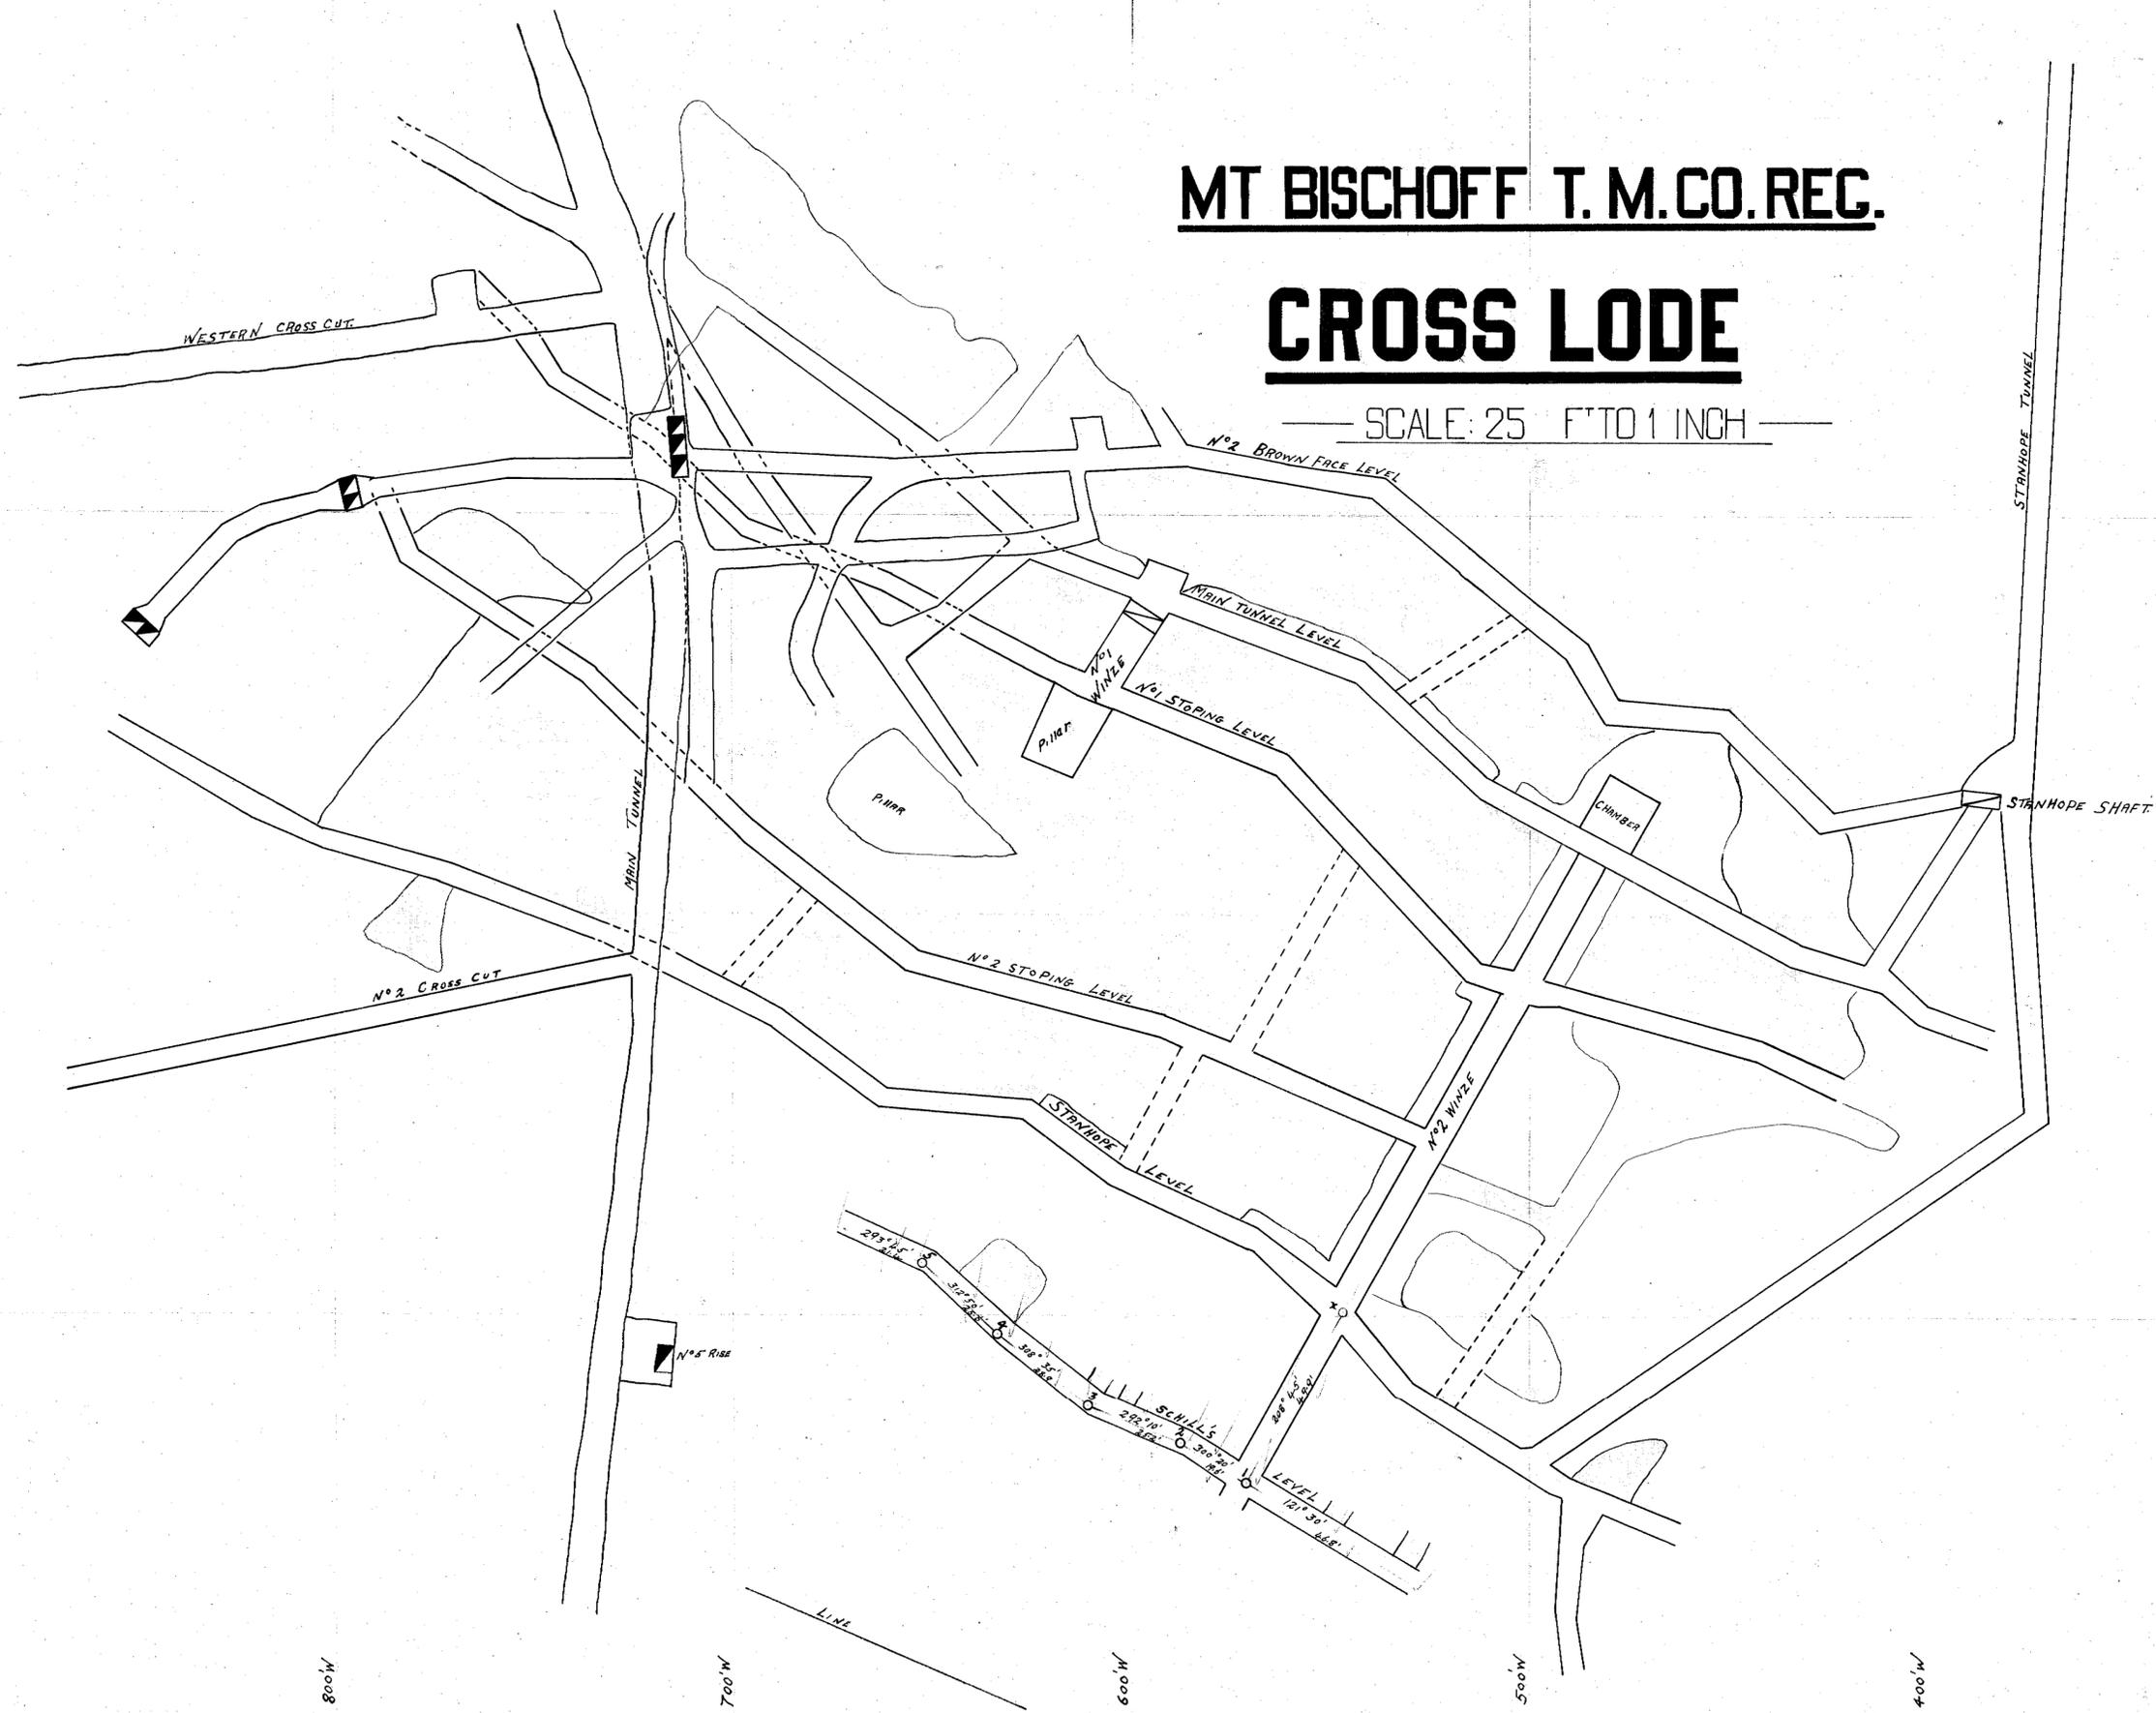

2200' N

2100' N


2000' N

1900' N

1800' N

21-77

21-77

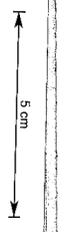

M.000'

M.008

M.008

M.009

M.009

M.004

M.004

*Workings  
Surveyor H. H. D. etc.  
but used 5" theodolite*