


217-78

Nº 4 & Nº 2 ADIT

NORTH VALLEY

217-78

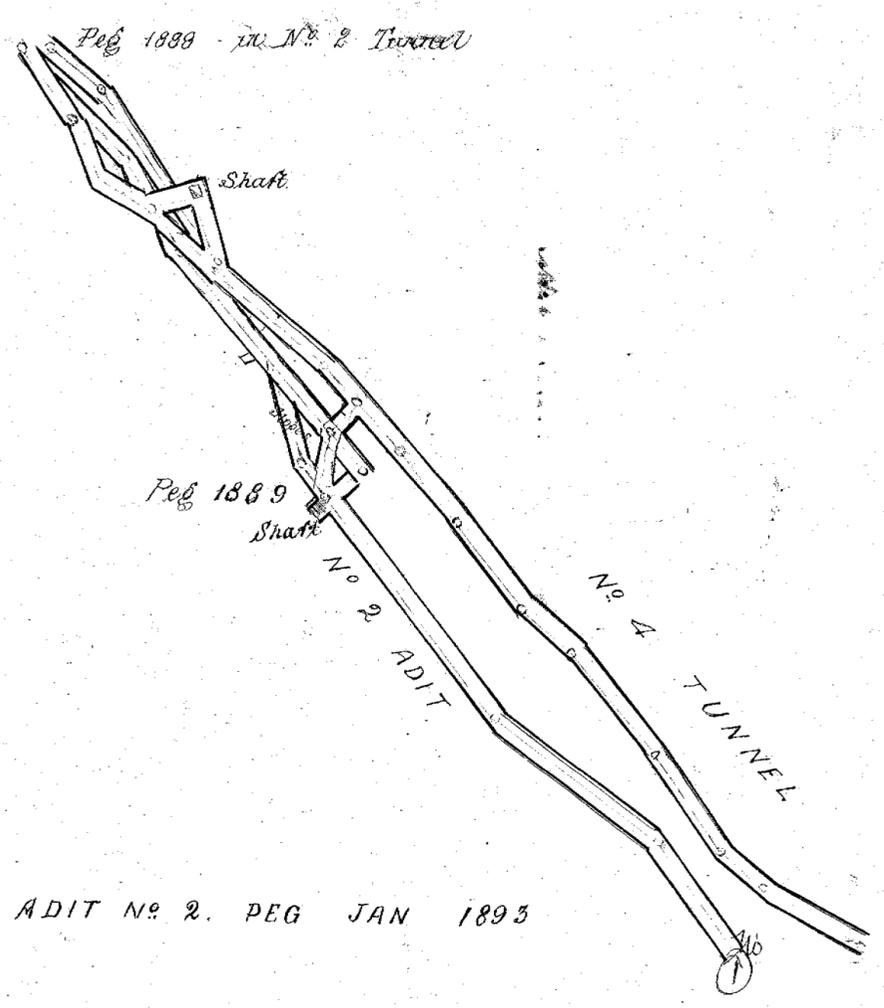

ADIT Nº 2. PEG JAN 1893

David Jones,
 District Surveyor
 Waratah, February 10th 1893.

217-78