


PLAN
OF
THE MOUNT BISCHOFF T. M. COMPANY'S
WEAL UNDERGROUND WORKS


Scale 50 Feet to one Inch



217-80

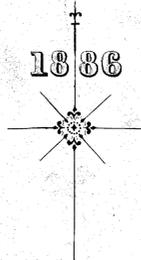

217-80

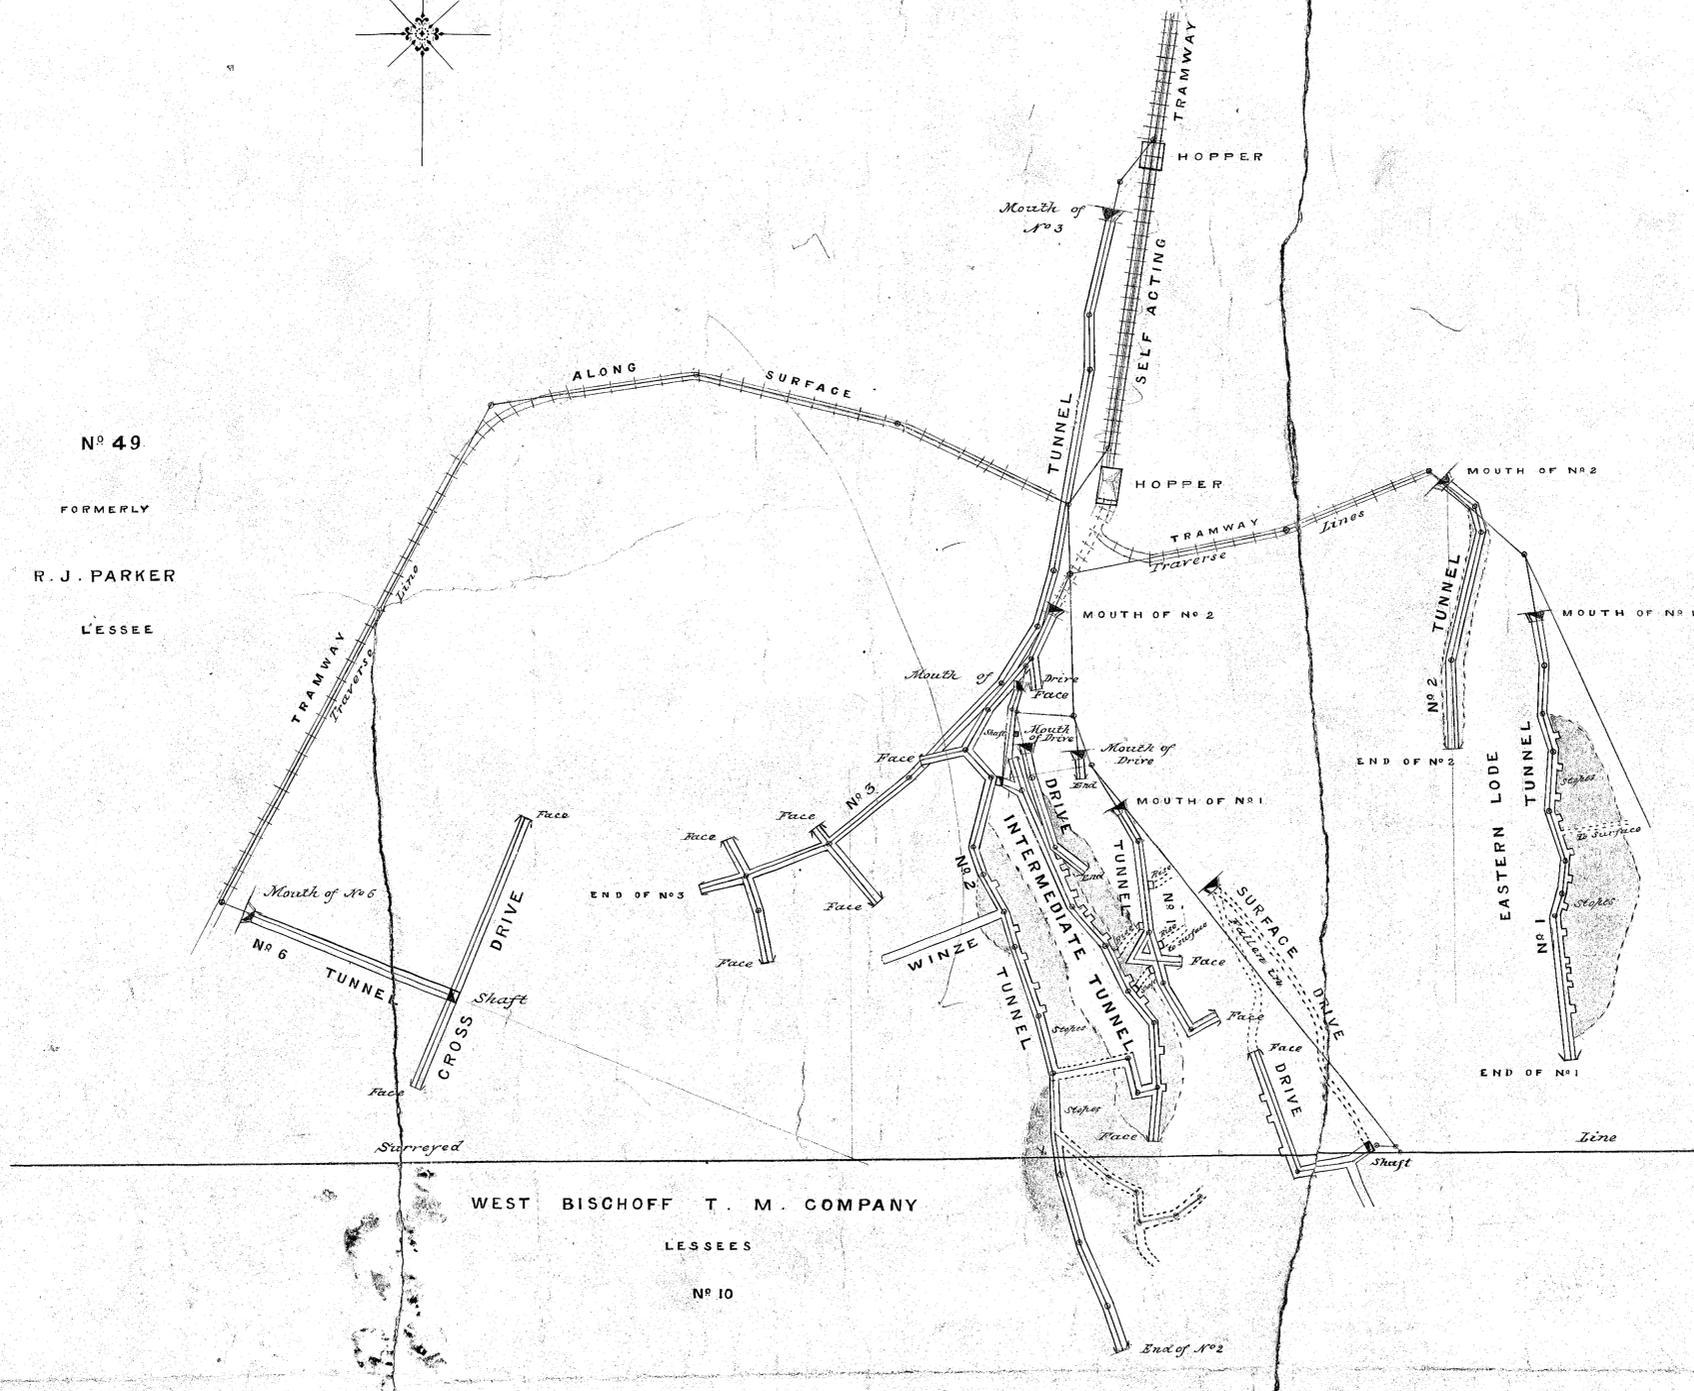

No 49
FORMERLY
R. J. PARKER
LESSEE

WEST BISCHOFF T. M. COMPANY
LESSEES
No 10

No 8
MT BISCHOFF T. M.
COMPANY
LESSEES

I, David Jones, Surveyor, Waratah, hereby certify that this plan is sufficiently correct for the purposes of the Regulation of Mines Act 1881 and 1884

David Jones
Mining Surveyor

February 23rd 1886

WHEAL WEAL