


217-84



— MT BISCHOFF T M CO REC — — BROWN FACE SOUTH LODE —

— SCALE 25 FT TO 1 INCH —

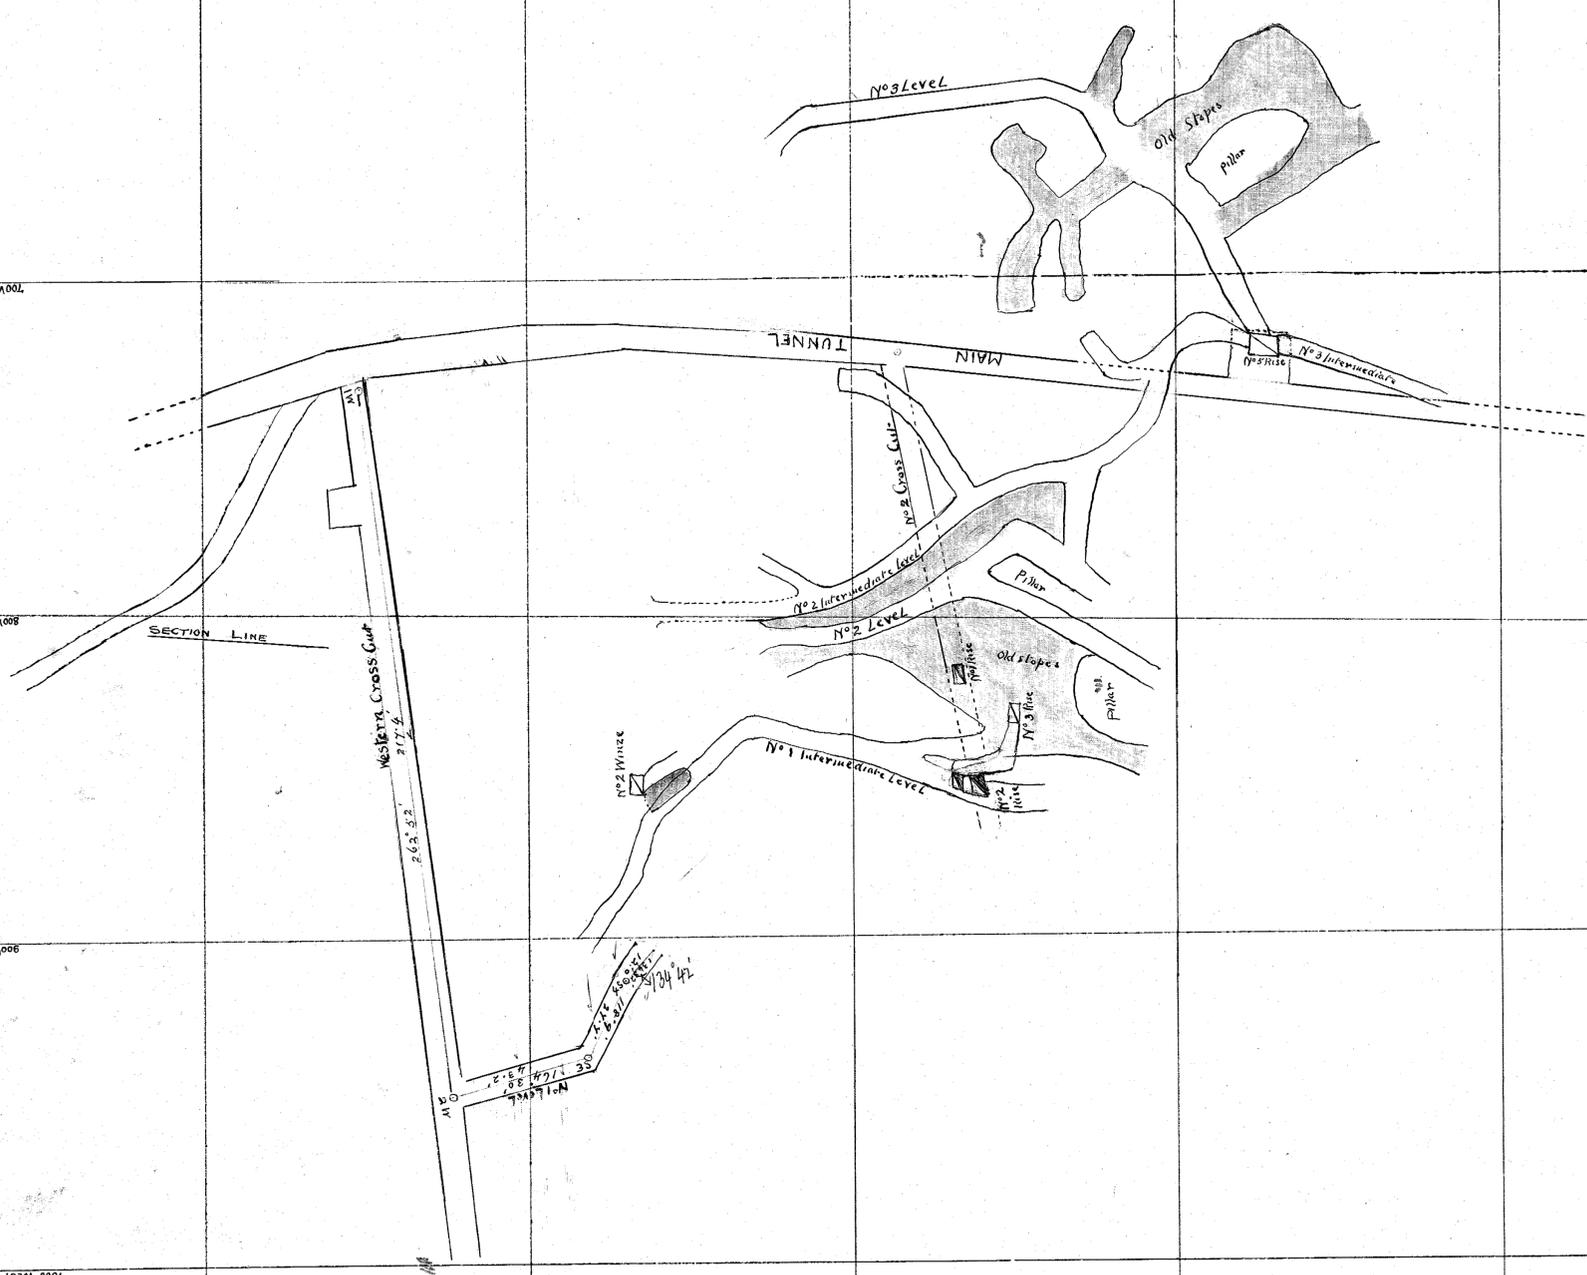

Work 1938
Survey of the Plot
and 5' horizontal

217-84
3/11/54