


MT BISCHOFF T.M. CO. REG.


QUEEN WORKINGS

217-85

SCALE 25 FT. = 1 IN.

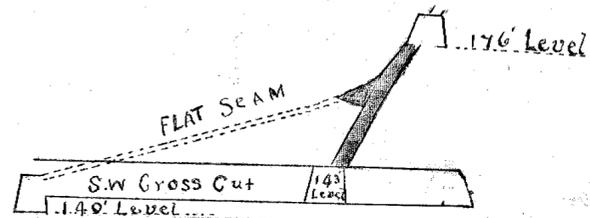

Transverse Section On Line C D

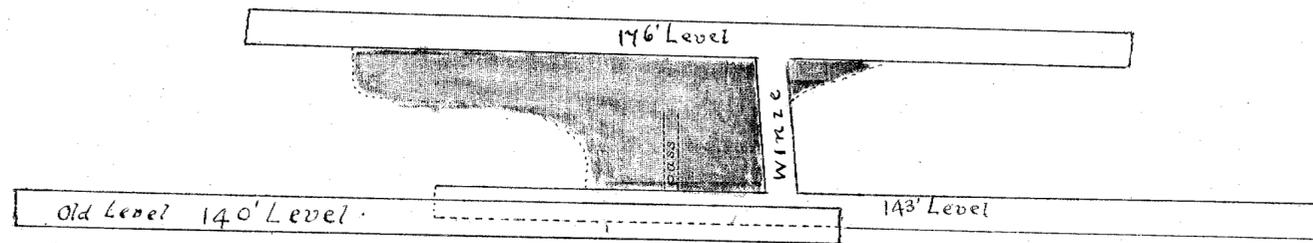

Longitudinal Section On Line A B

Surveyor W. P. ... Just used to the level



217-85

Handwritten initials or signature.