


MT. BISCHOFF T.M CO. REG.  
**QUEEN WORKINGS.**

SCALE 25 FT. = 1 IN.

Driving 1928 Coloured 

Stops 

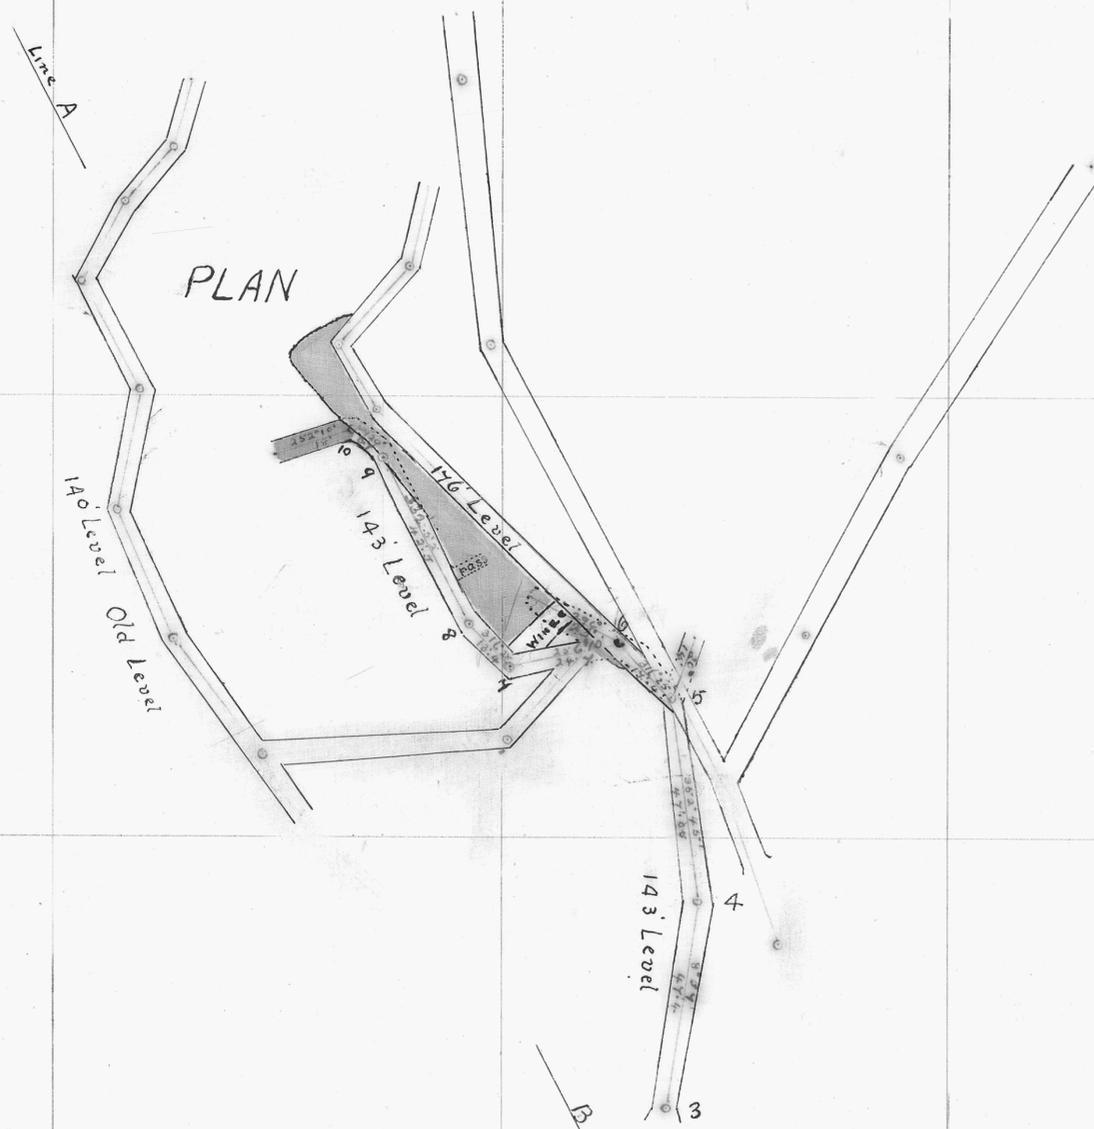

PLAN

140 Level Old Level

143 Level

176 Level

143 Level

800 West

700 W

600 W

500 W

400 W

300 W

200 West

2300 North

2400 N

2500 N

2600 North

Surveyor M. Porter Int used of theodolite

217-86

5 cm

217-86

25/1/21  
2000  
1900