



MT BISCHOFF T.M.CO.REG.
QUEEN LODGE DYKE

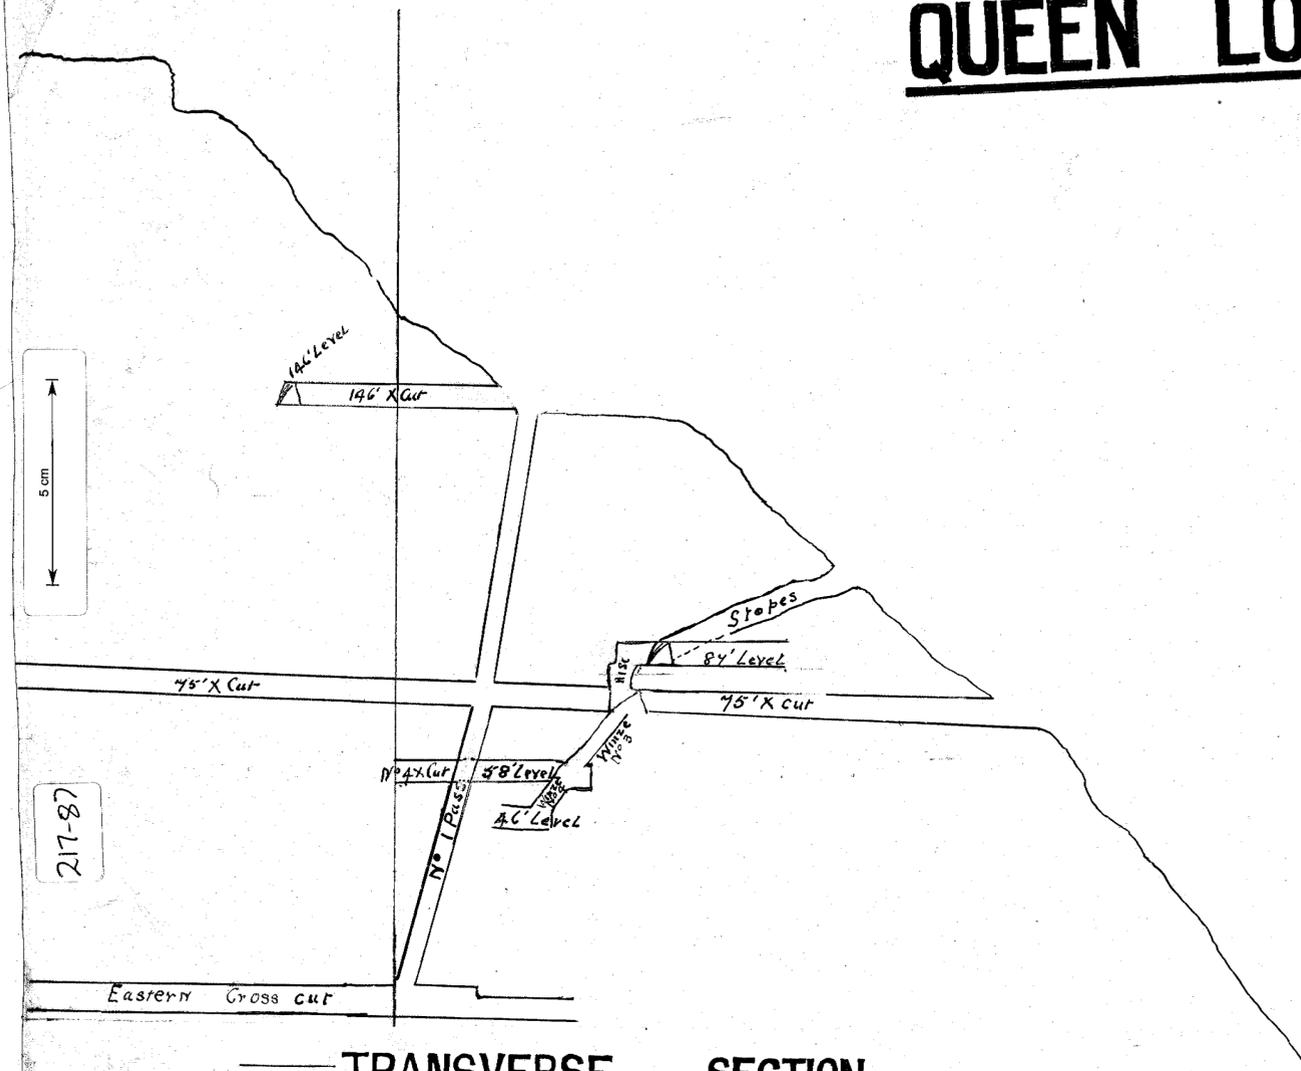

TRANSVERSE SECTION

SCALE 25 FEET TO 1 INCH

Work 1938
 Surveyed by H. D. ...
 but used 5" theodolite

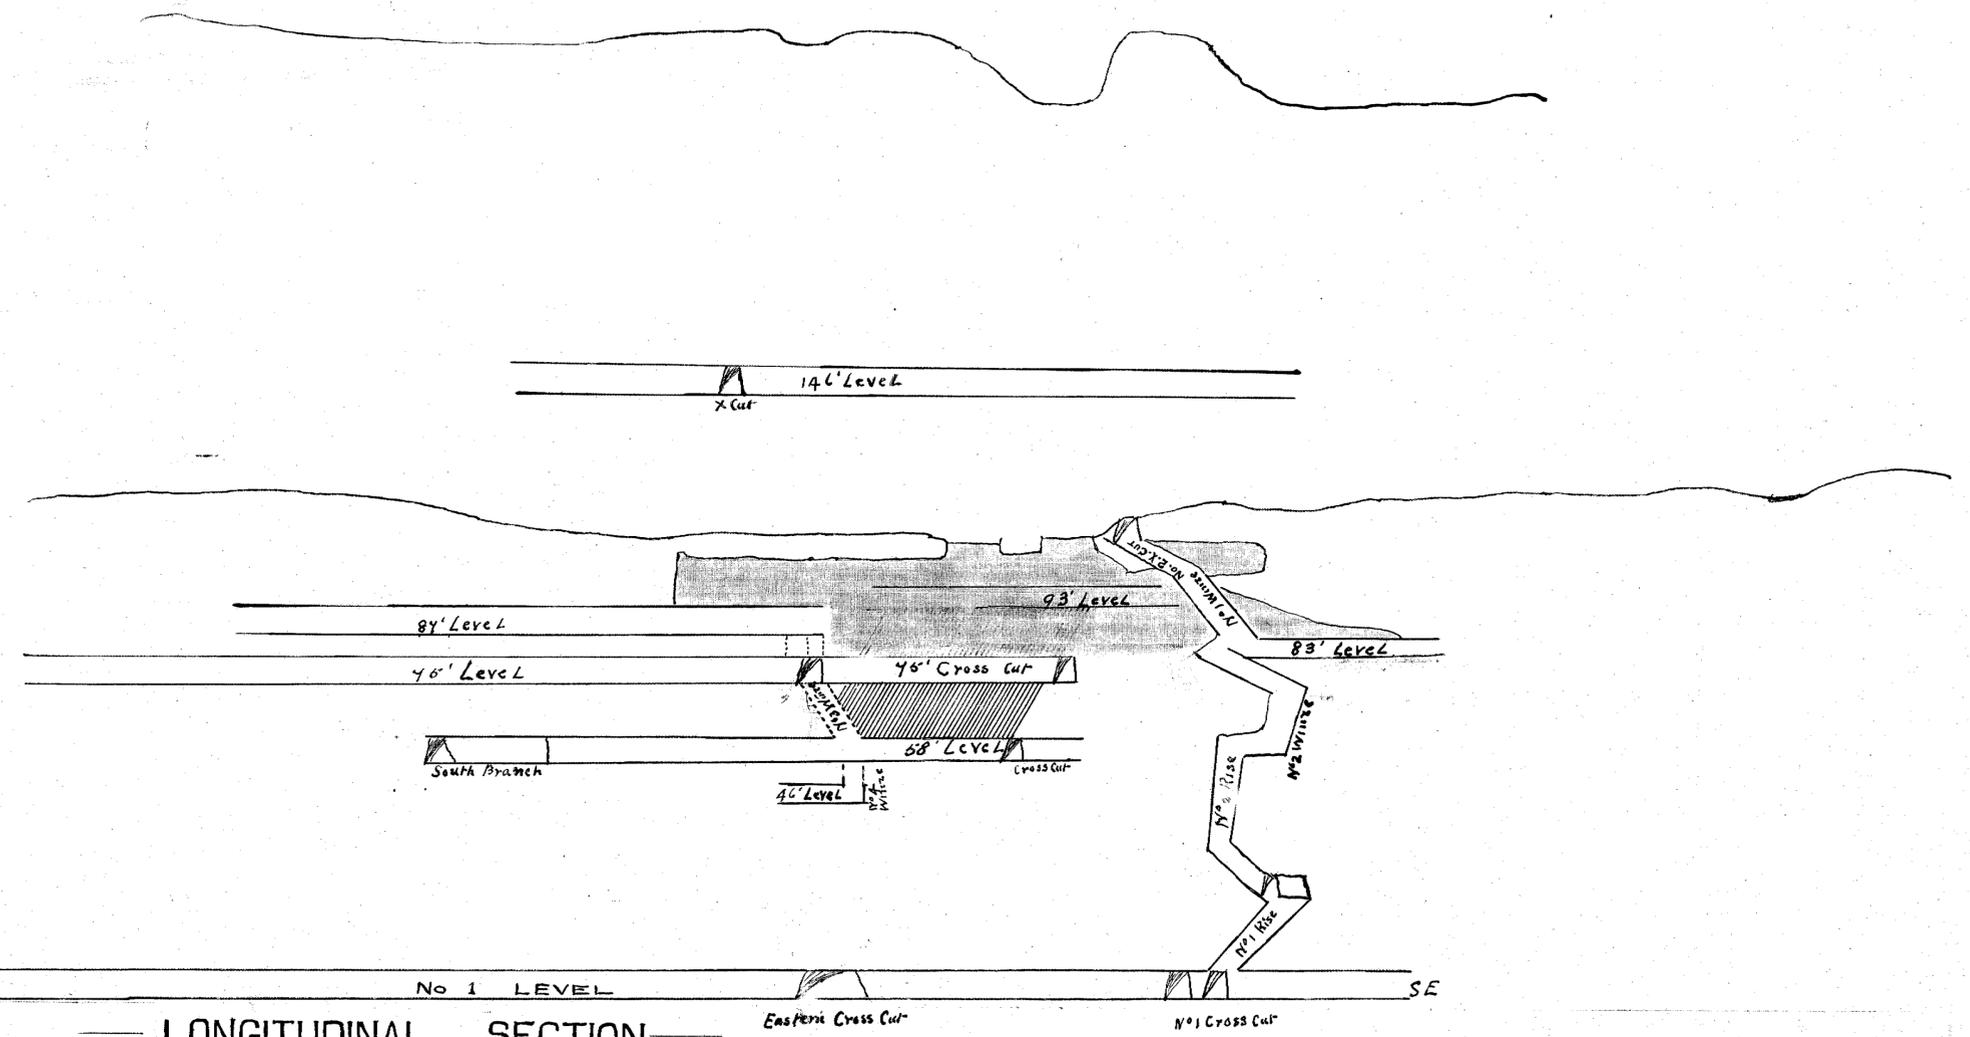

LONGITUDINAL SECTION

SCALE 25 FT TO 1 INCH