


MT BISCHOFF T.M. CO. REG.

QUEEN WORKINGS


SCALE 25 FT = 1 IN

217-89

5 cm

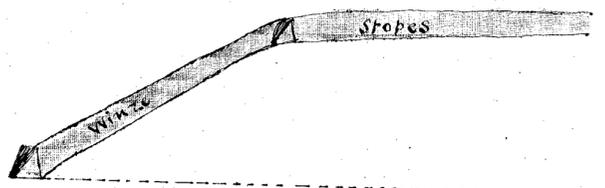

Transverse Section

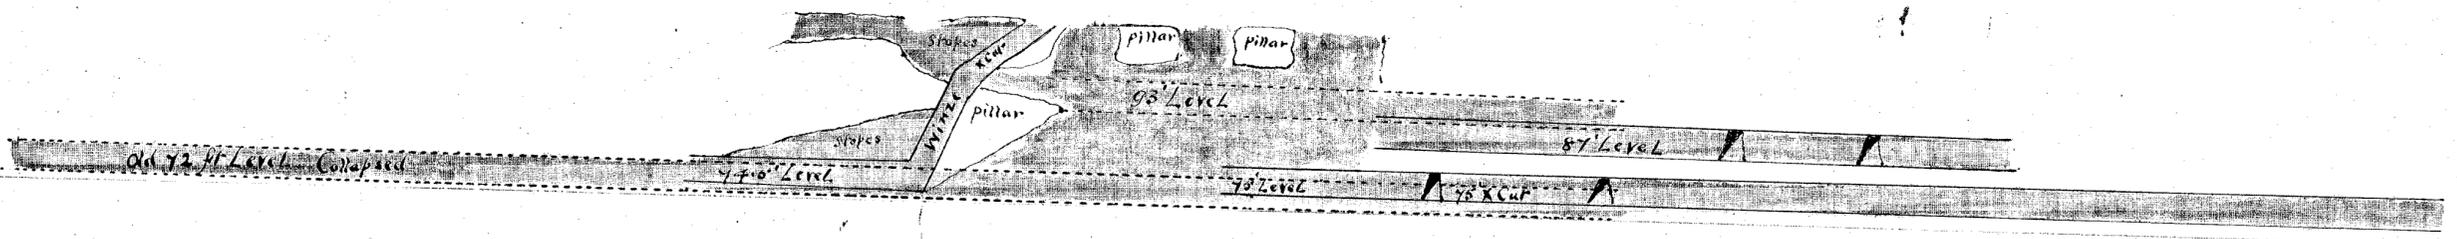

LONGITUDINAL SECTION

217-89

Work 1932
Surveyor W. Porter first used 4' hand Sturzak's Stopping
10/7/33

217-89