



122

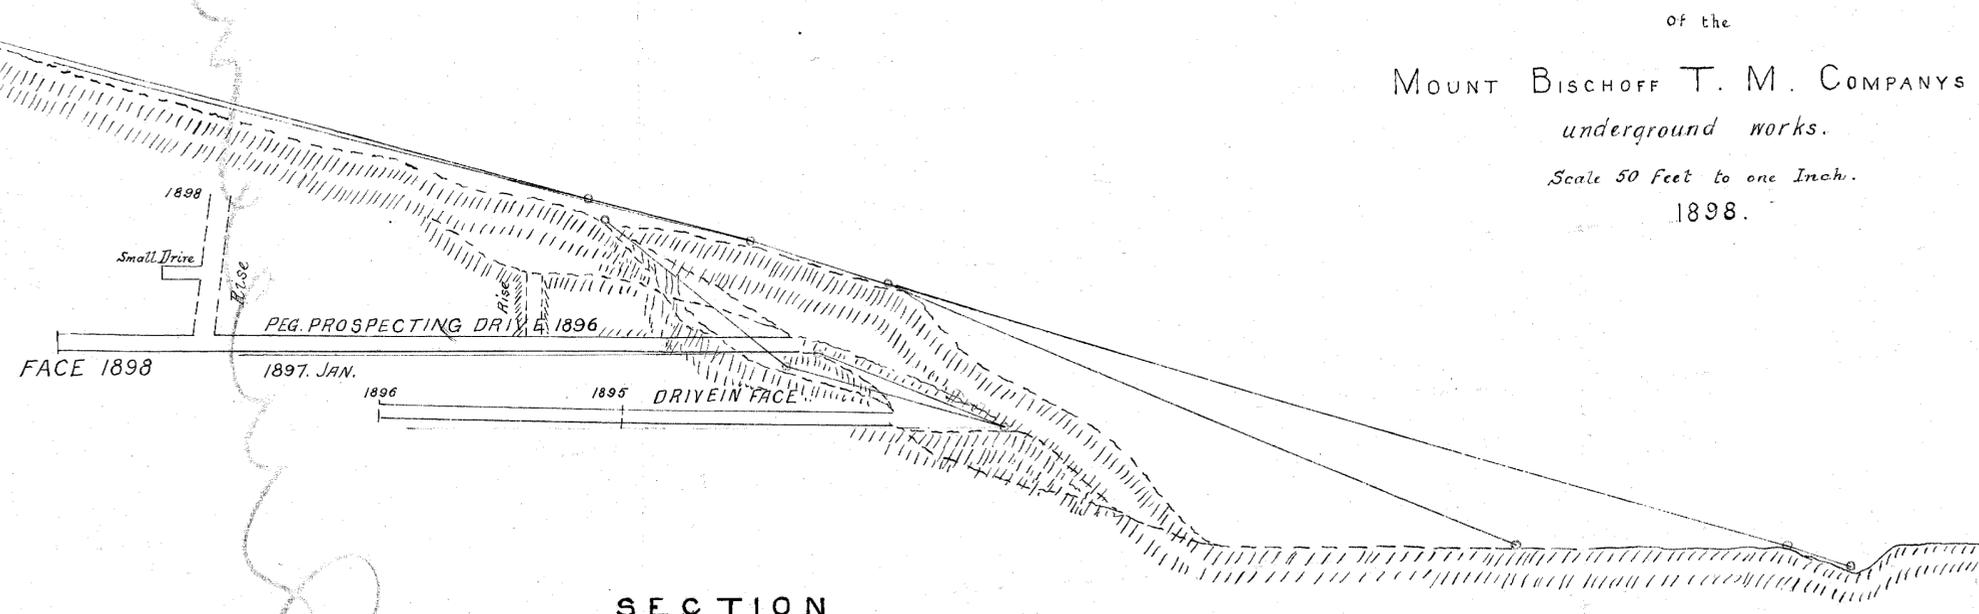

SECTIONS  
 of the  
 MOUNT BISCHOFF T. M. COMPANY'S  
 underground works.  
 Scale 50 feet to one Inch.  
 1898.


27-90

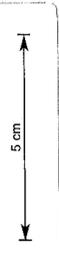

WESTERN CROSS CUT

27-90

*Samuel Jones,*  
 District Surveyor,  
 January 26<sup>th</sup> 1898.

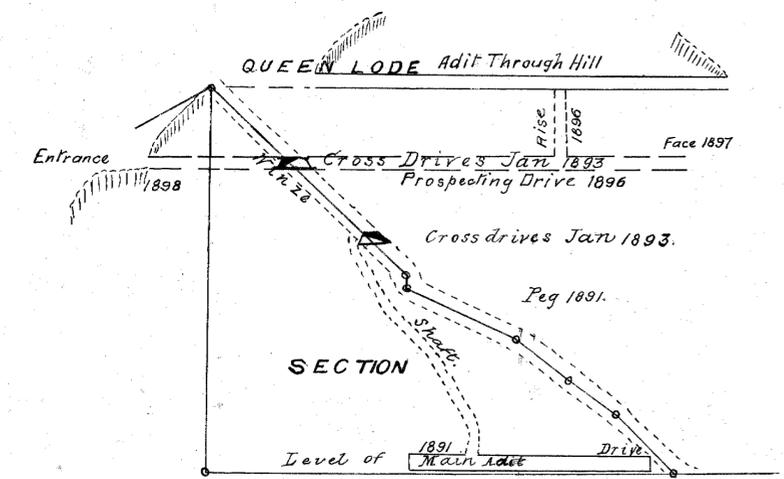

LONGITUDINAL SECTION

