

MT BISCHOFF T.M.CO.REG.


QUEEN LODGE

LONGITUDINAL SECTION

SCALE 25 FT TO 1 INCH

5m

217-91

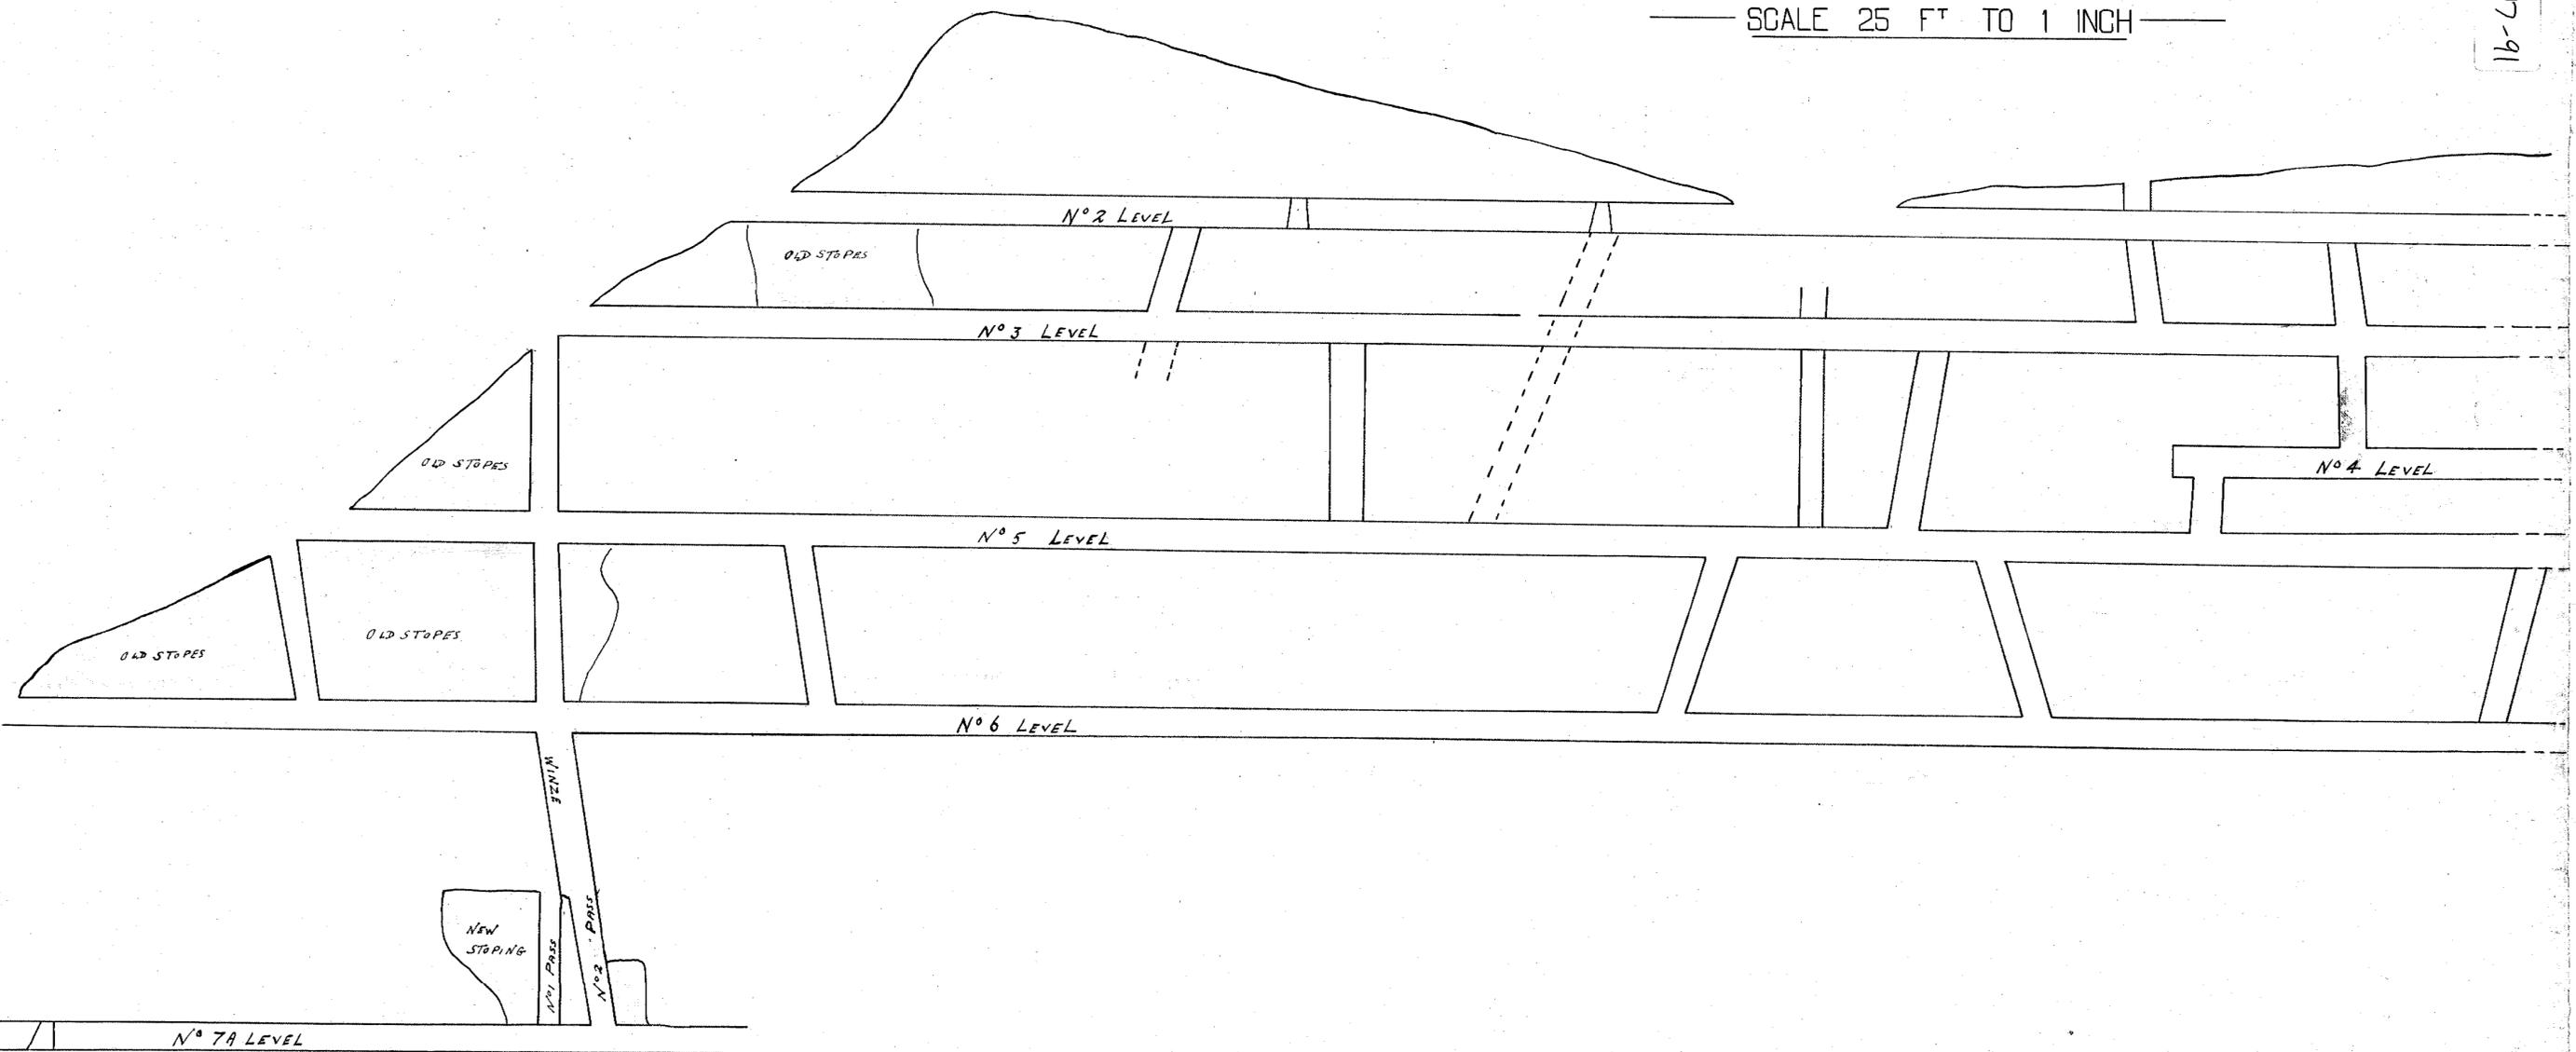

Hand 1920
Survey 11/26/20
but used 5" theodolite

217-91