

217-92


217-92

# MT BISCHOFF T.M.CO.REG.

## QUEEN LODGE

TRANSVERSE SECTION

SCALE 25 FT TO 1 INCH

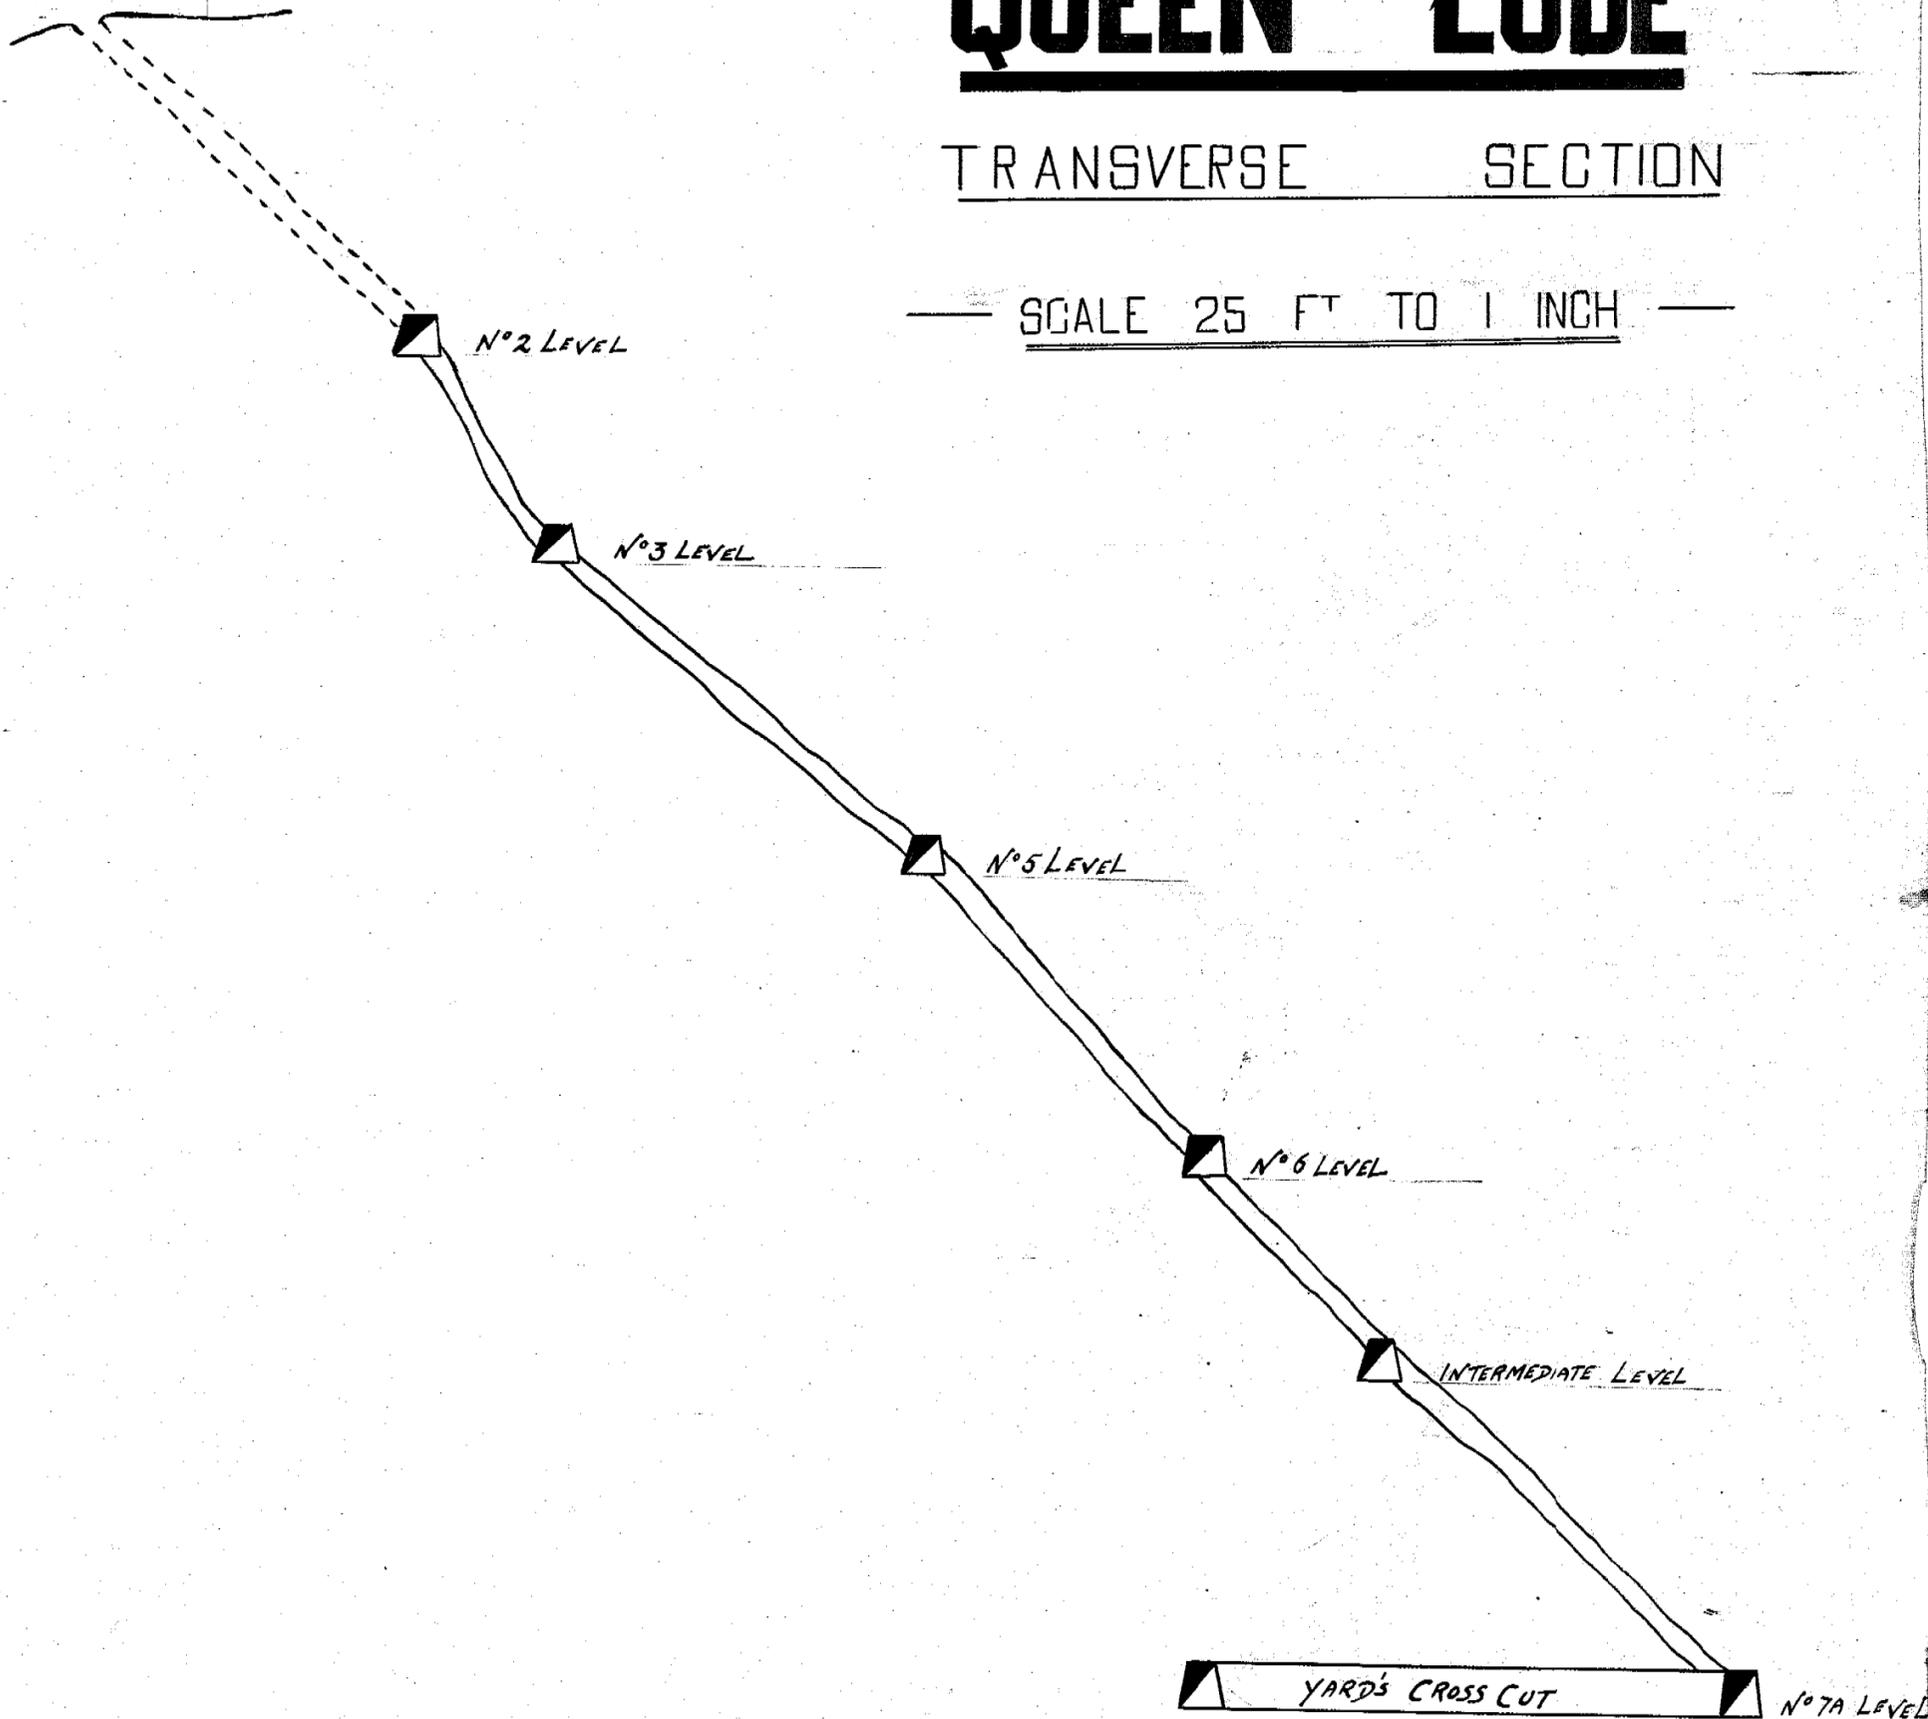

WORK 1936  
 SURVEYOR C. F. B. K.  
 INST. USED 5" THEODOLITE  
 DATE 7th June 1937