

217-93

2900 N.


Mt. BISCHOFF T. M. Co. Reg. QUEEN WORKINGS

UNDERGROUND WORKINGS TO DEC. 31 1923.

SCALE 25FT. TO 1IN.

2800.

*W. G. Wright
Cons. Party
25.2.24.*

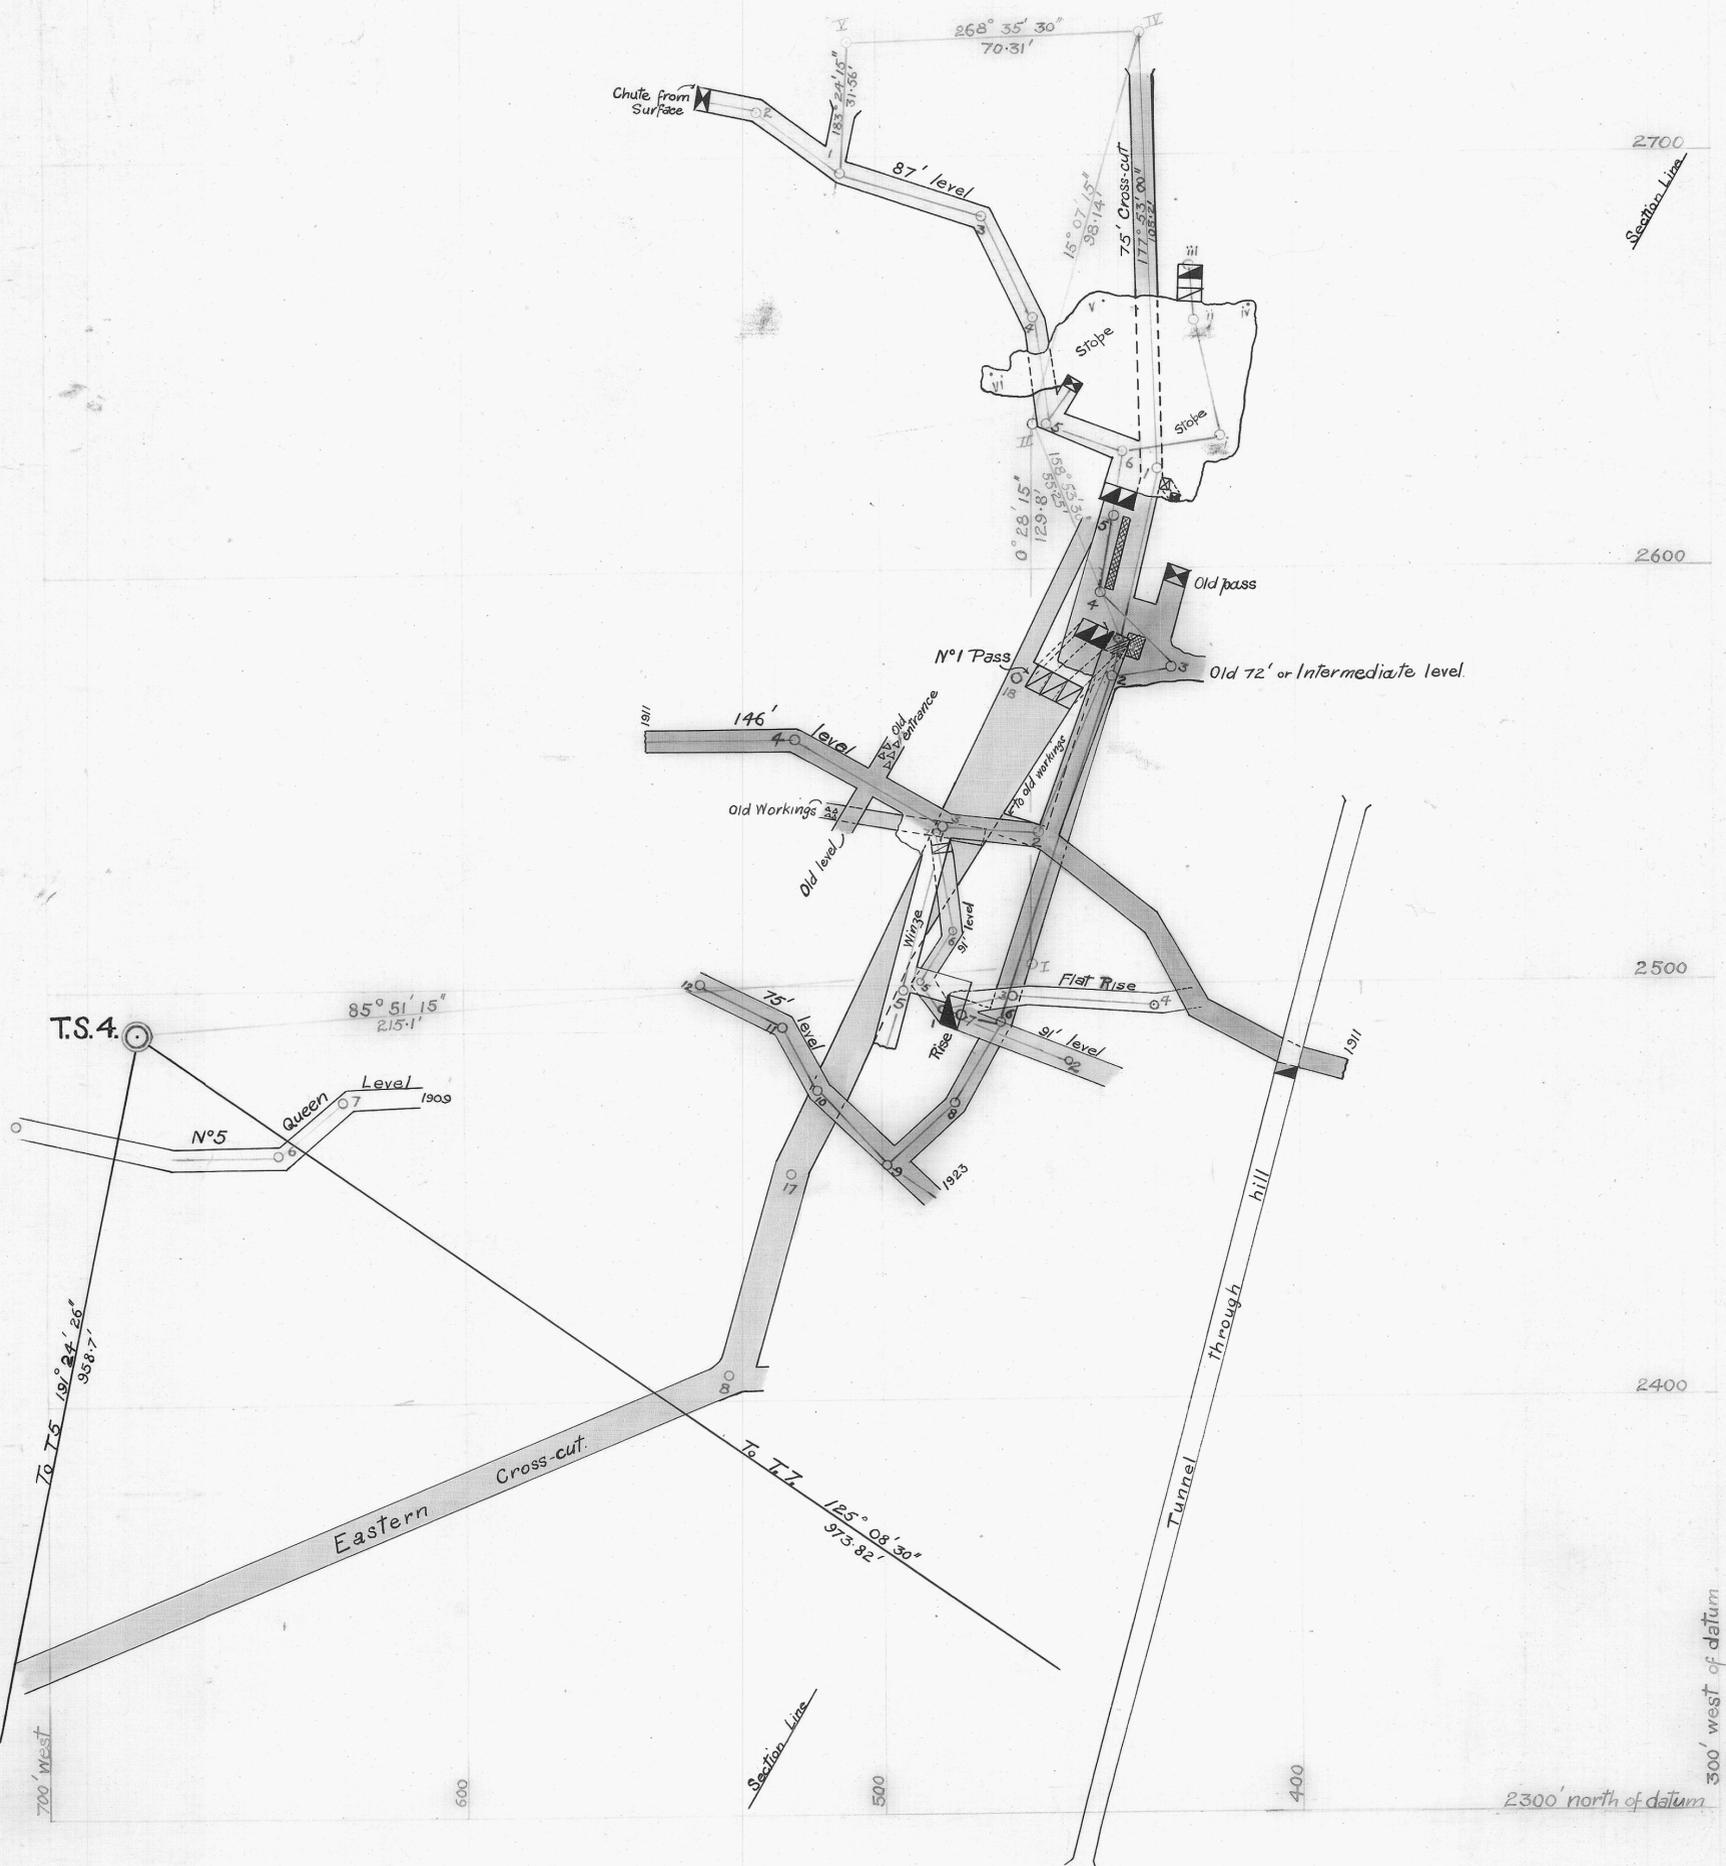

2700
Section Line

2600

2500

2400

300' west of datum

2300' north of datum