

5 cm

217-95


Mt. BISCHOFF T. M. Co. Reg.

QUEEN = WORKINGS


SECTIONS OF WORKINGS TO DEC. 31 1924.

SCALE 25 FT. TO 1 IN.

*W.P. Gandy
Chief Surveyor*

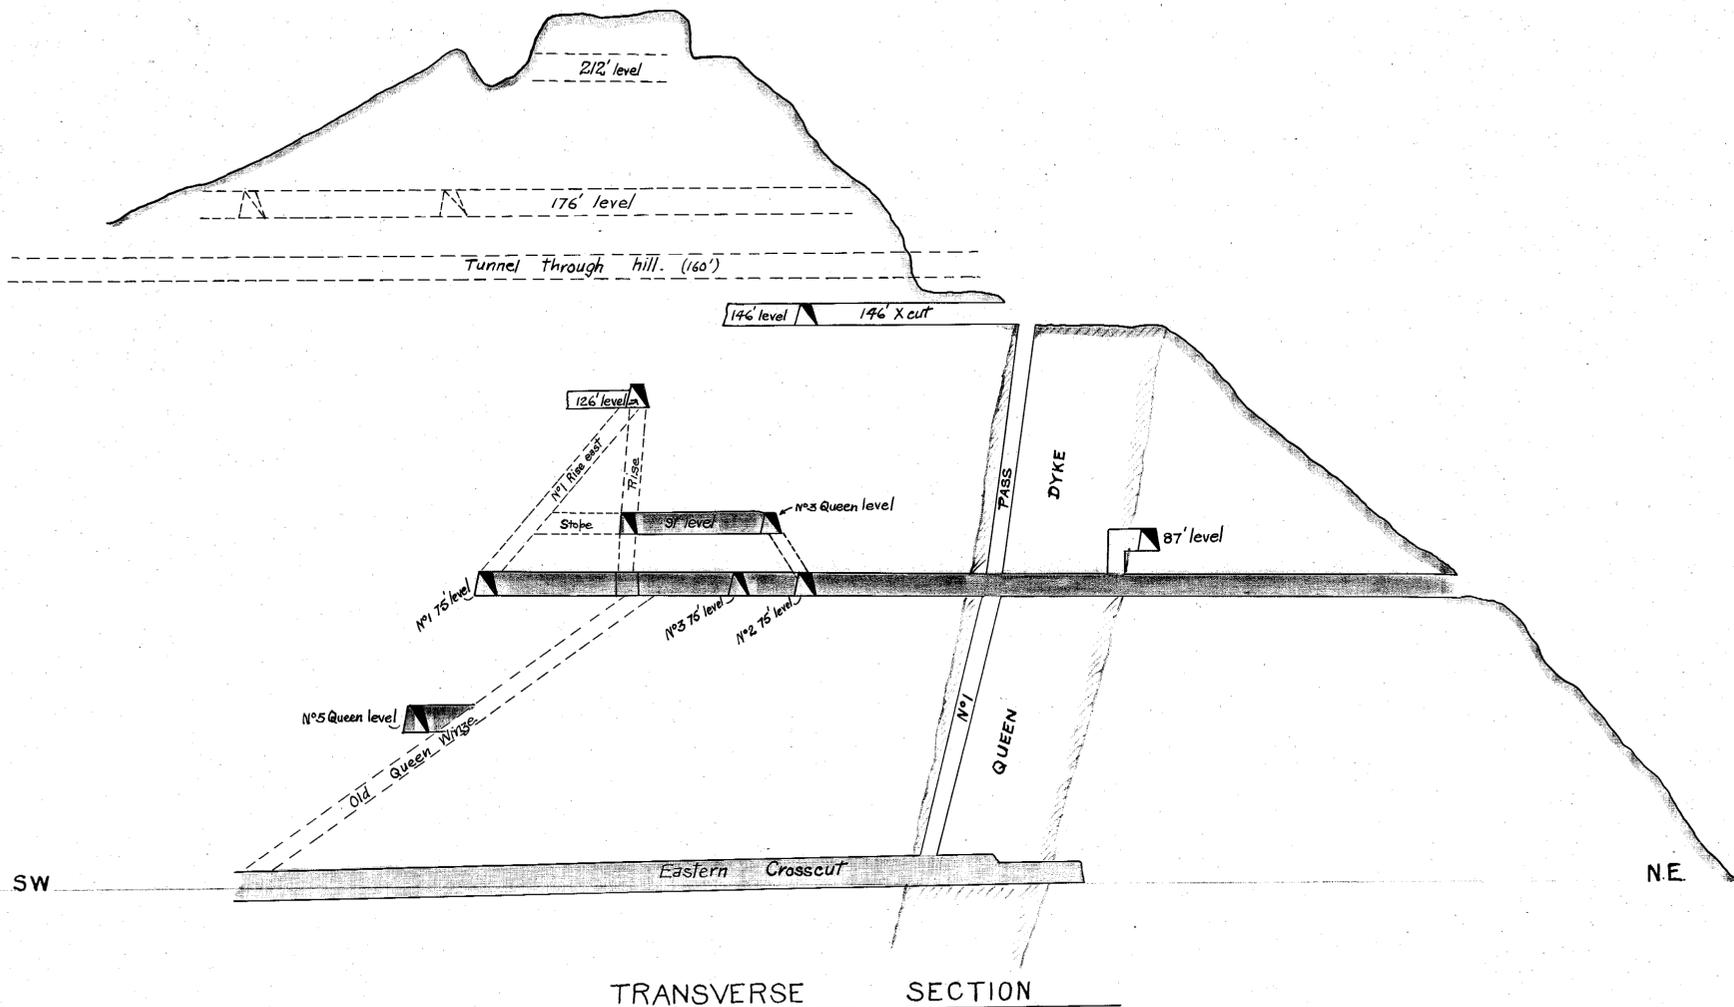

TRANSVERSE SECTION

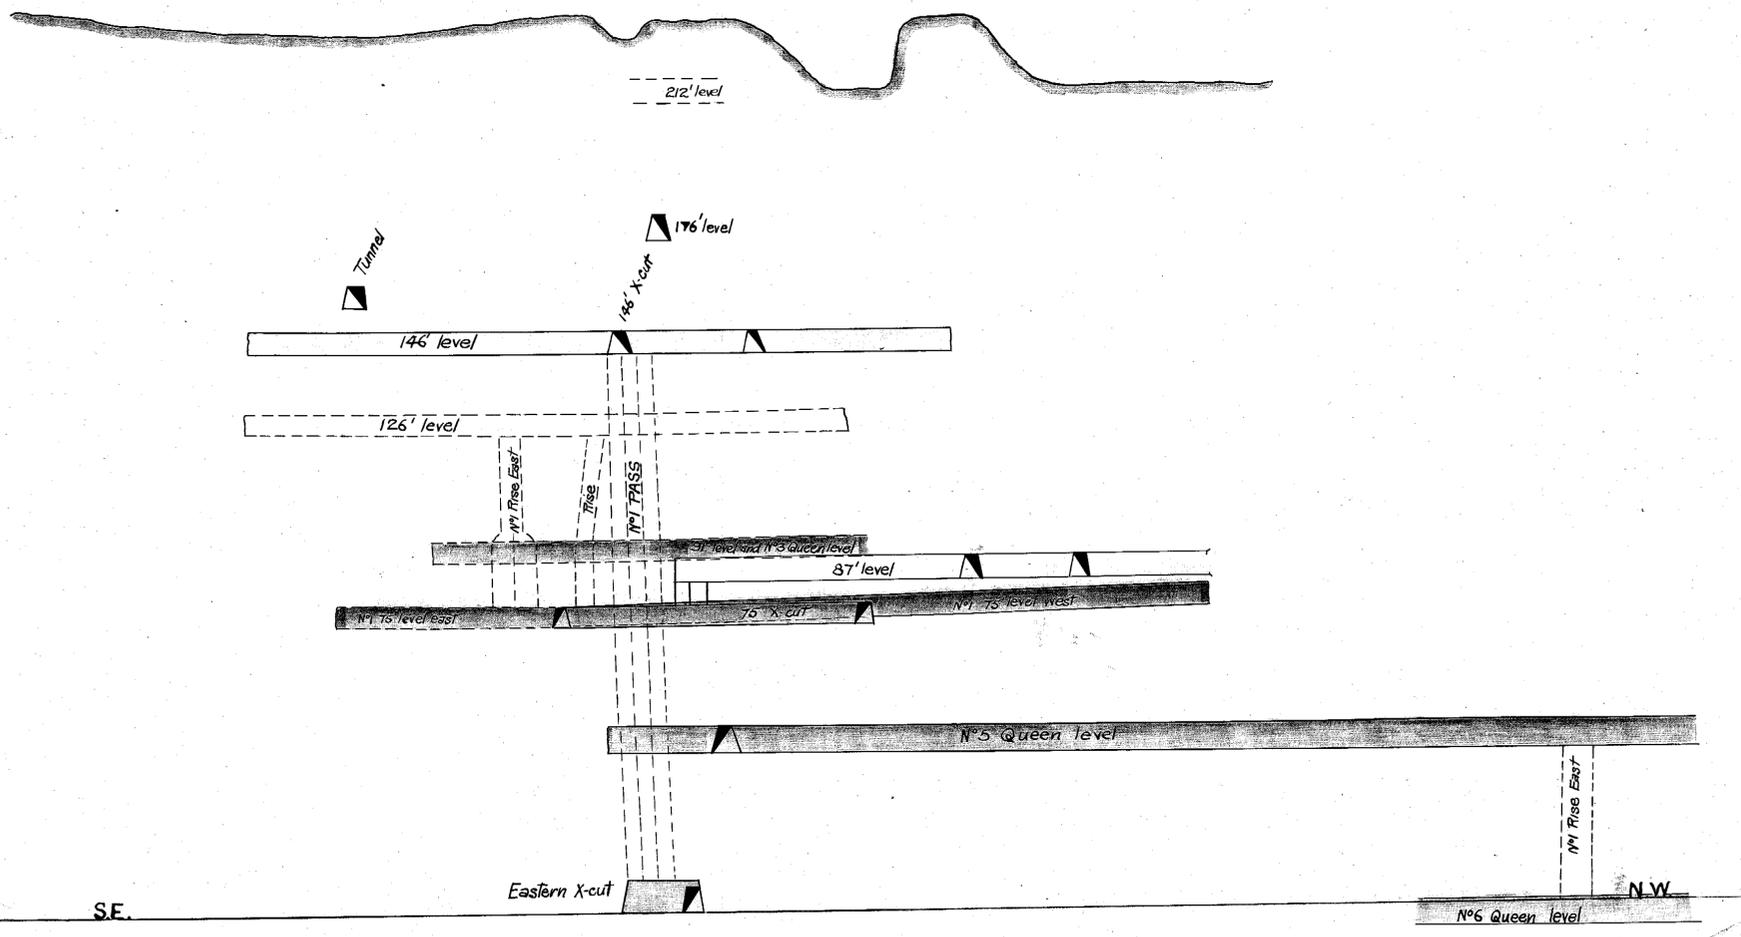

LONGITUDINAL SECTION