
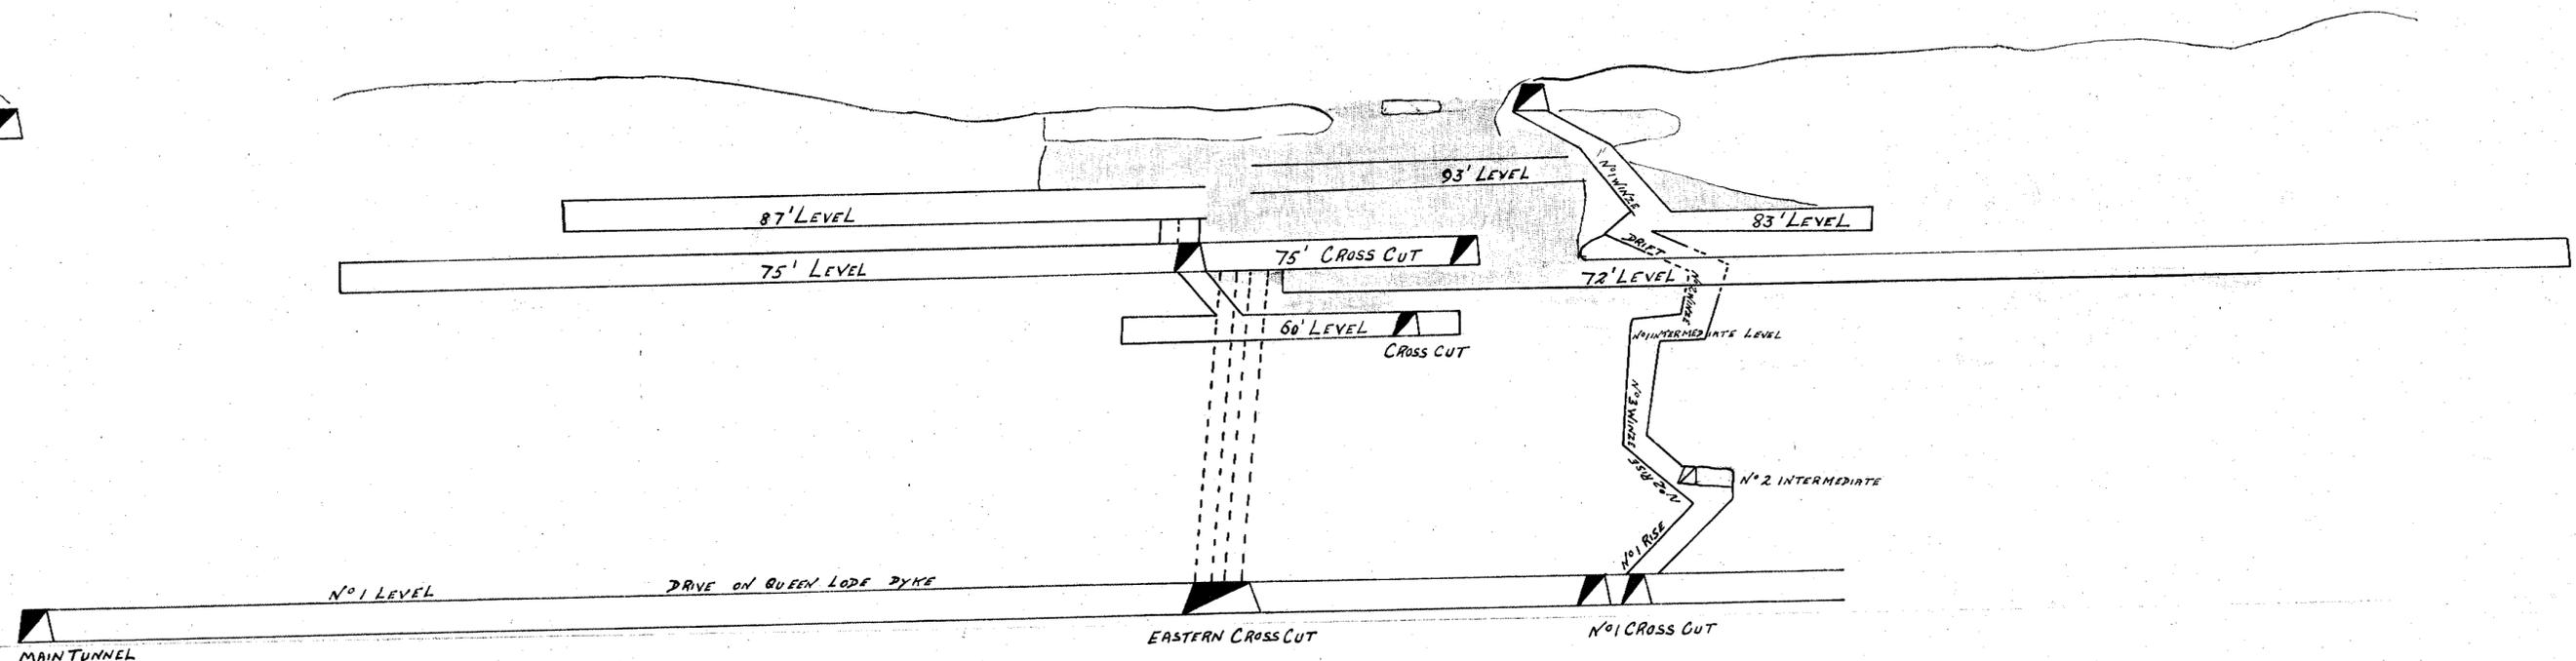


# MT BISCHOFF T. M. CO. REC.

## QUEEN LODGE DYKE

LONGITUDINAL SECTION

SCALE 25 FT TO 1 INCH

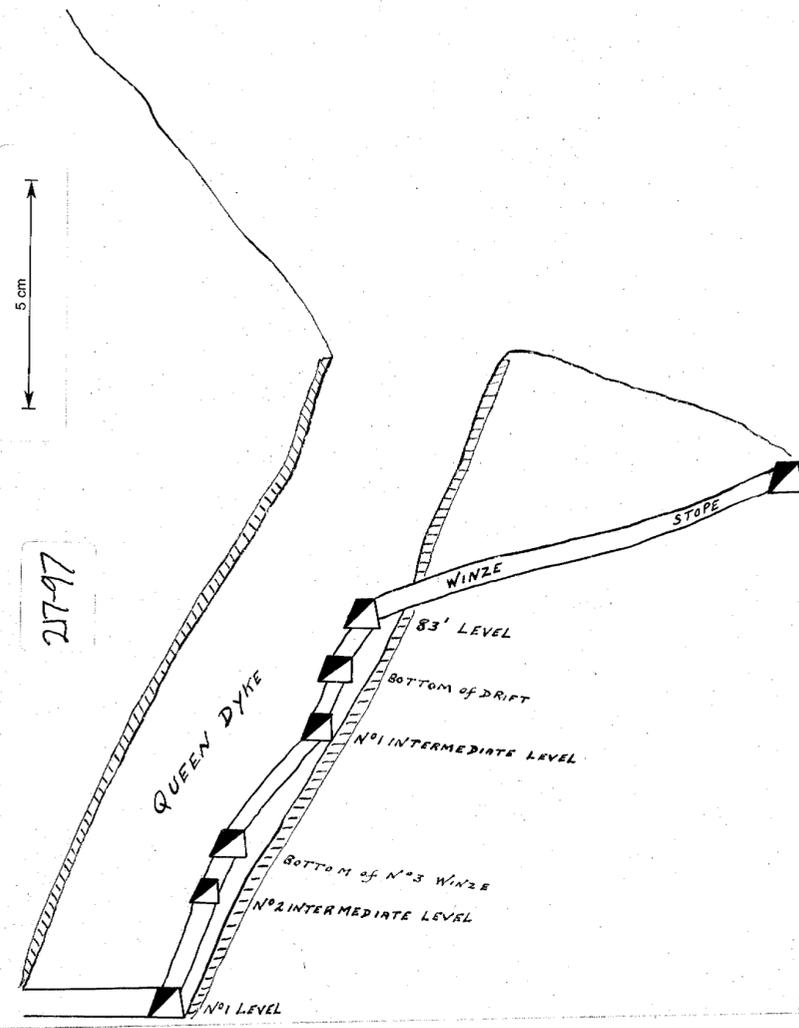

Transverse Section.

Works 1935  
Surveyor 1938 D. O. B.  
Int. and 5' theodolite

217-97

217-97

5 cm