
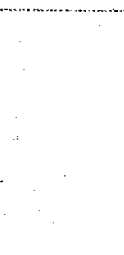 

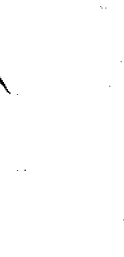
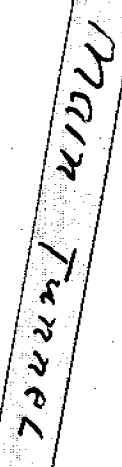
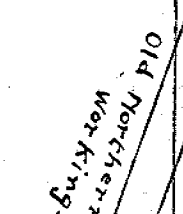
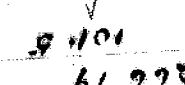
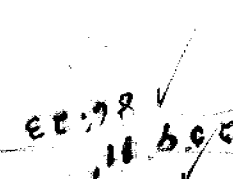
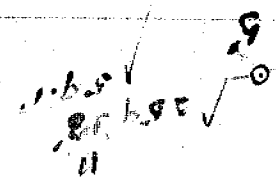


- MT BISCHOFF T. M. CO. REG. -
- QUEEN LODGE BRANCH -

— SCALE 25 FT TO 1 INCH —

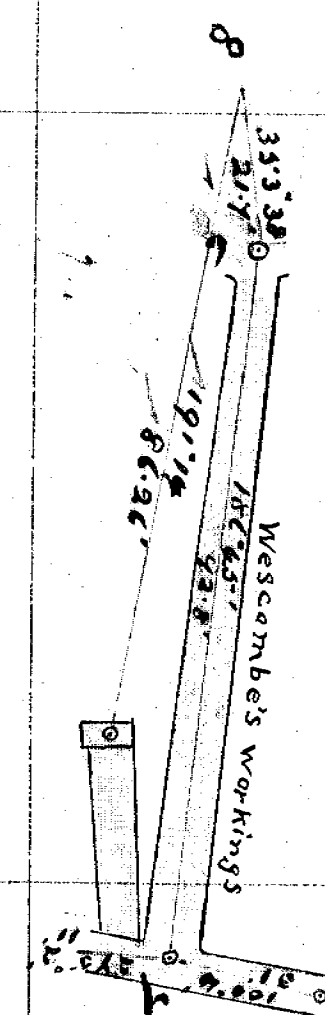

217-100

5 cm

Work 1933
Survey W. H. Porter
and 5" theodolite