

217-102

5 cm


217-102

MT BISCHOFF T.M.CO.REG.

QUEEN LODGE

TRANSVERSE SECTION

SCALE 25 FT TO 1 INCH

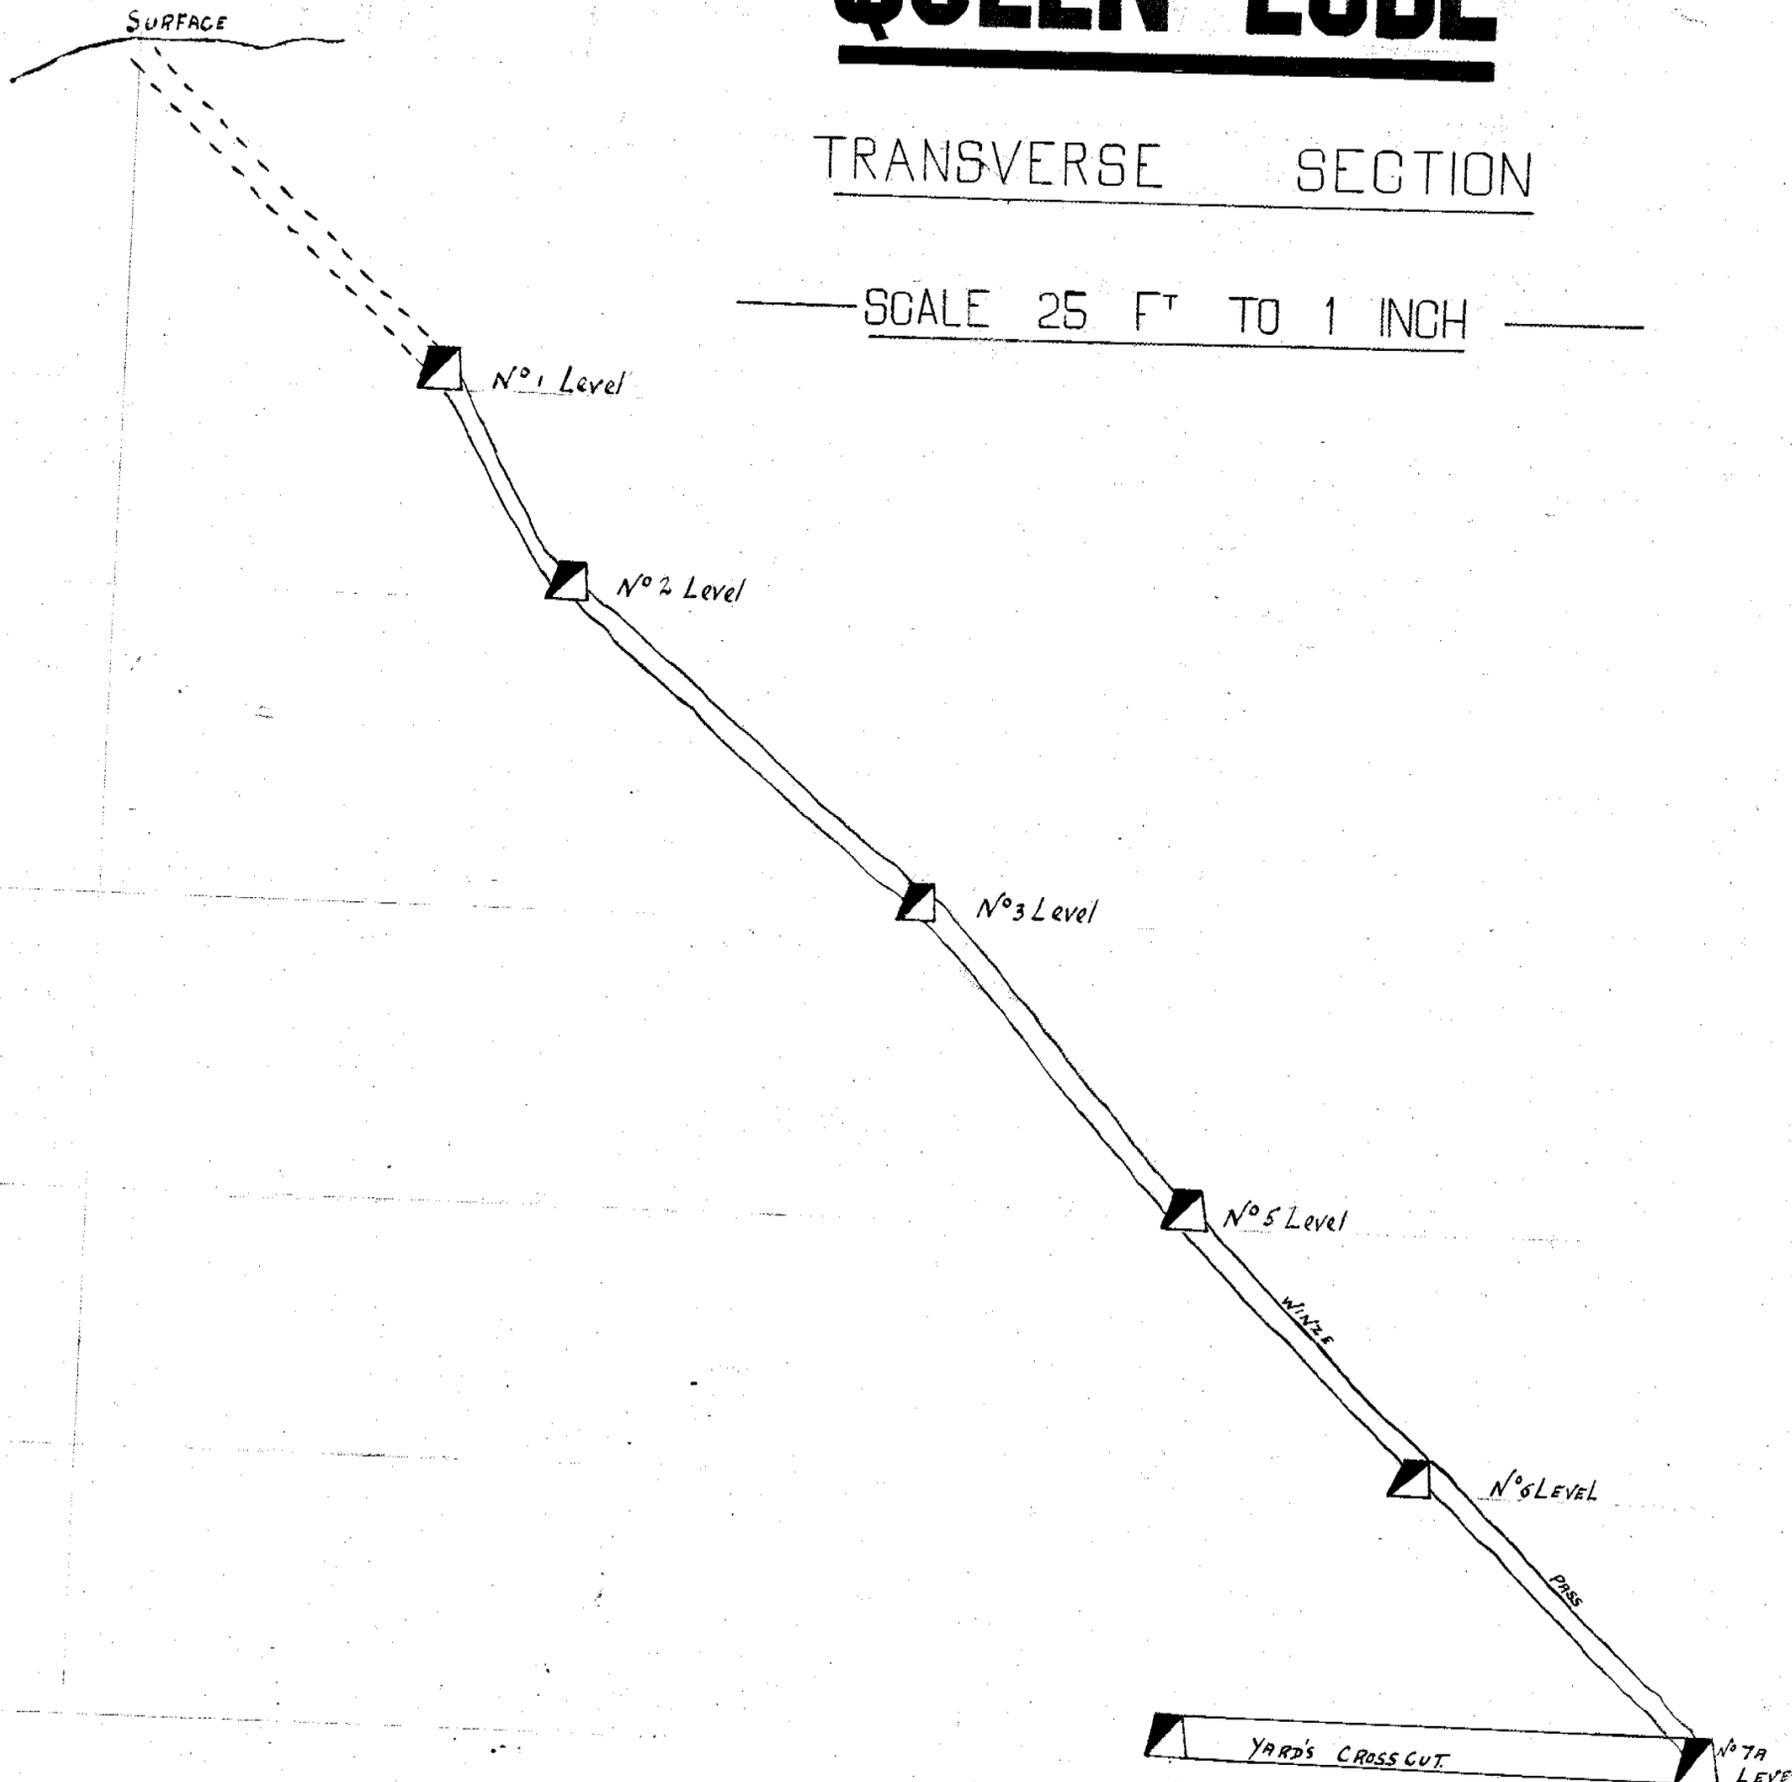

Work 1935
Surveyor W. G. Dorris
first used 6" theodolite