


217-104

MT BISCHOFF T. M. CO. REG.

QUEEN LODE

LONGITUDINAL SECTION

— SCALE 25 FT TO 1 INCH —

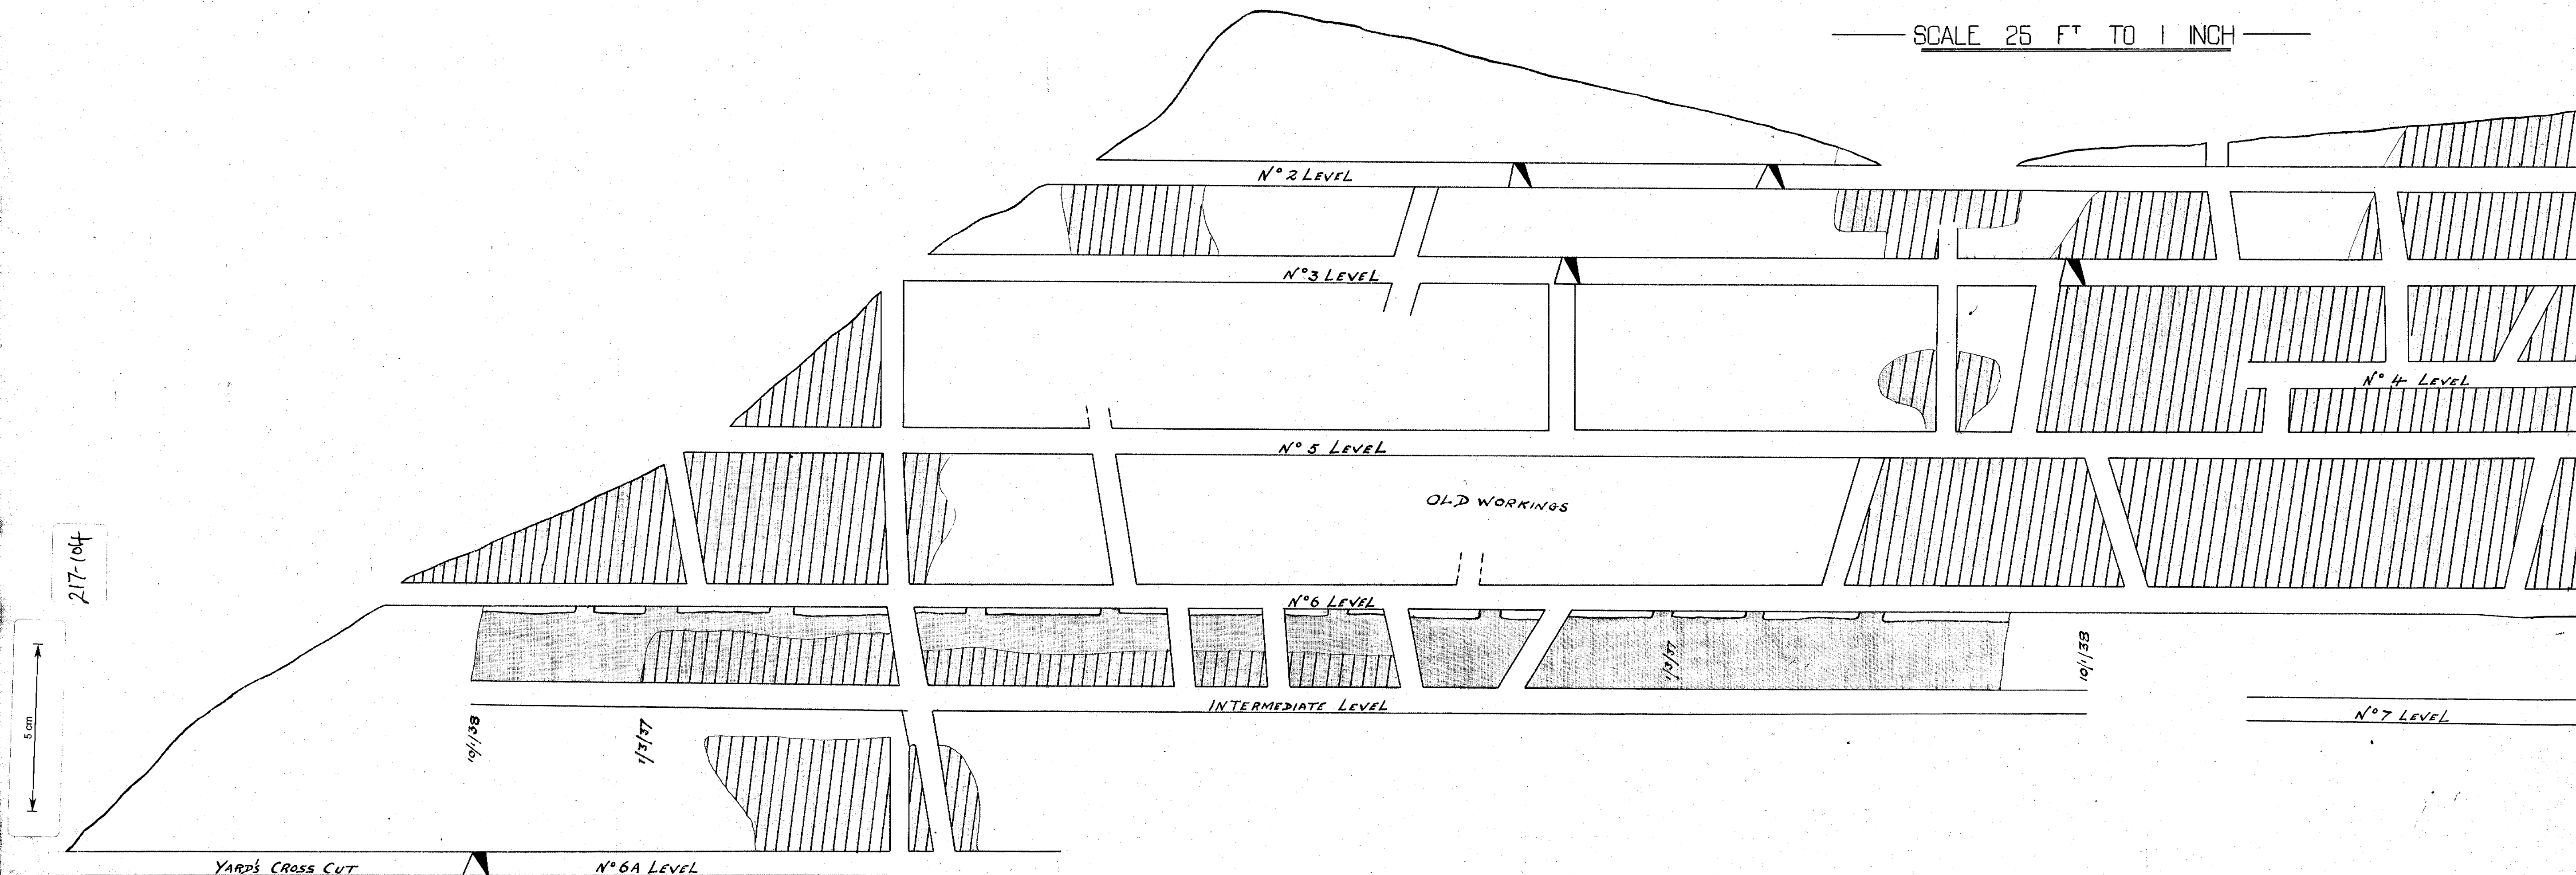

WORK 1936
SURVEYOR G. T. POPE
INST. USED 5" THEODOLITE
DATE 7 June 1937
COMPLETE TO 3/12/37

CURRENT YEARS WORK SHOWN THUS