


217-105

~~End 29/7/12~~

217-105

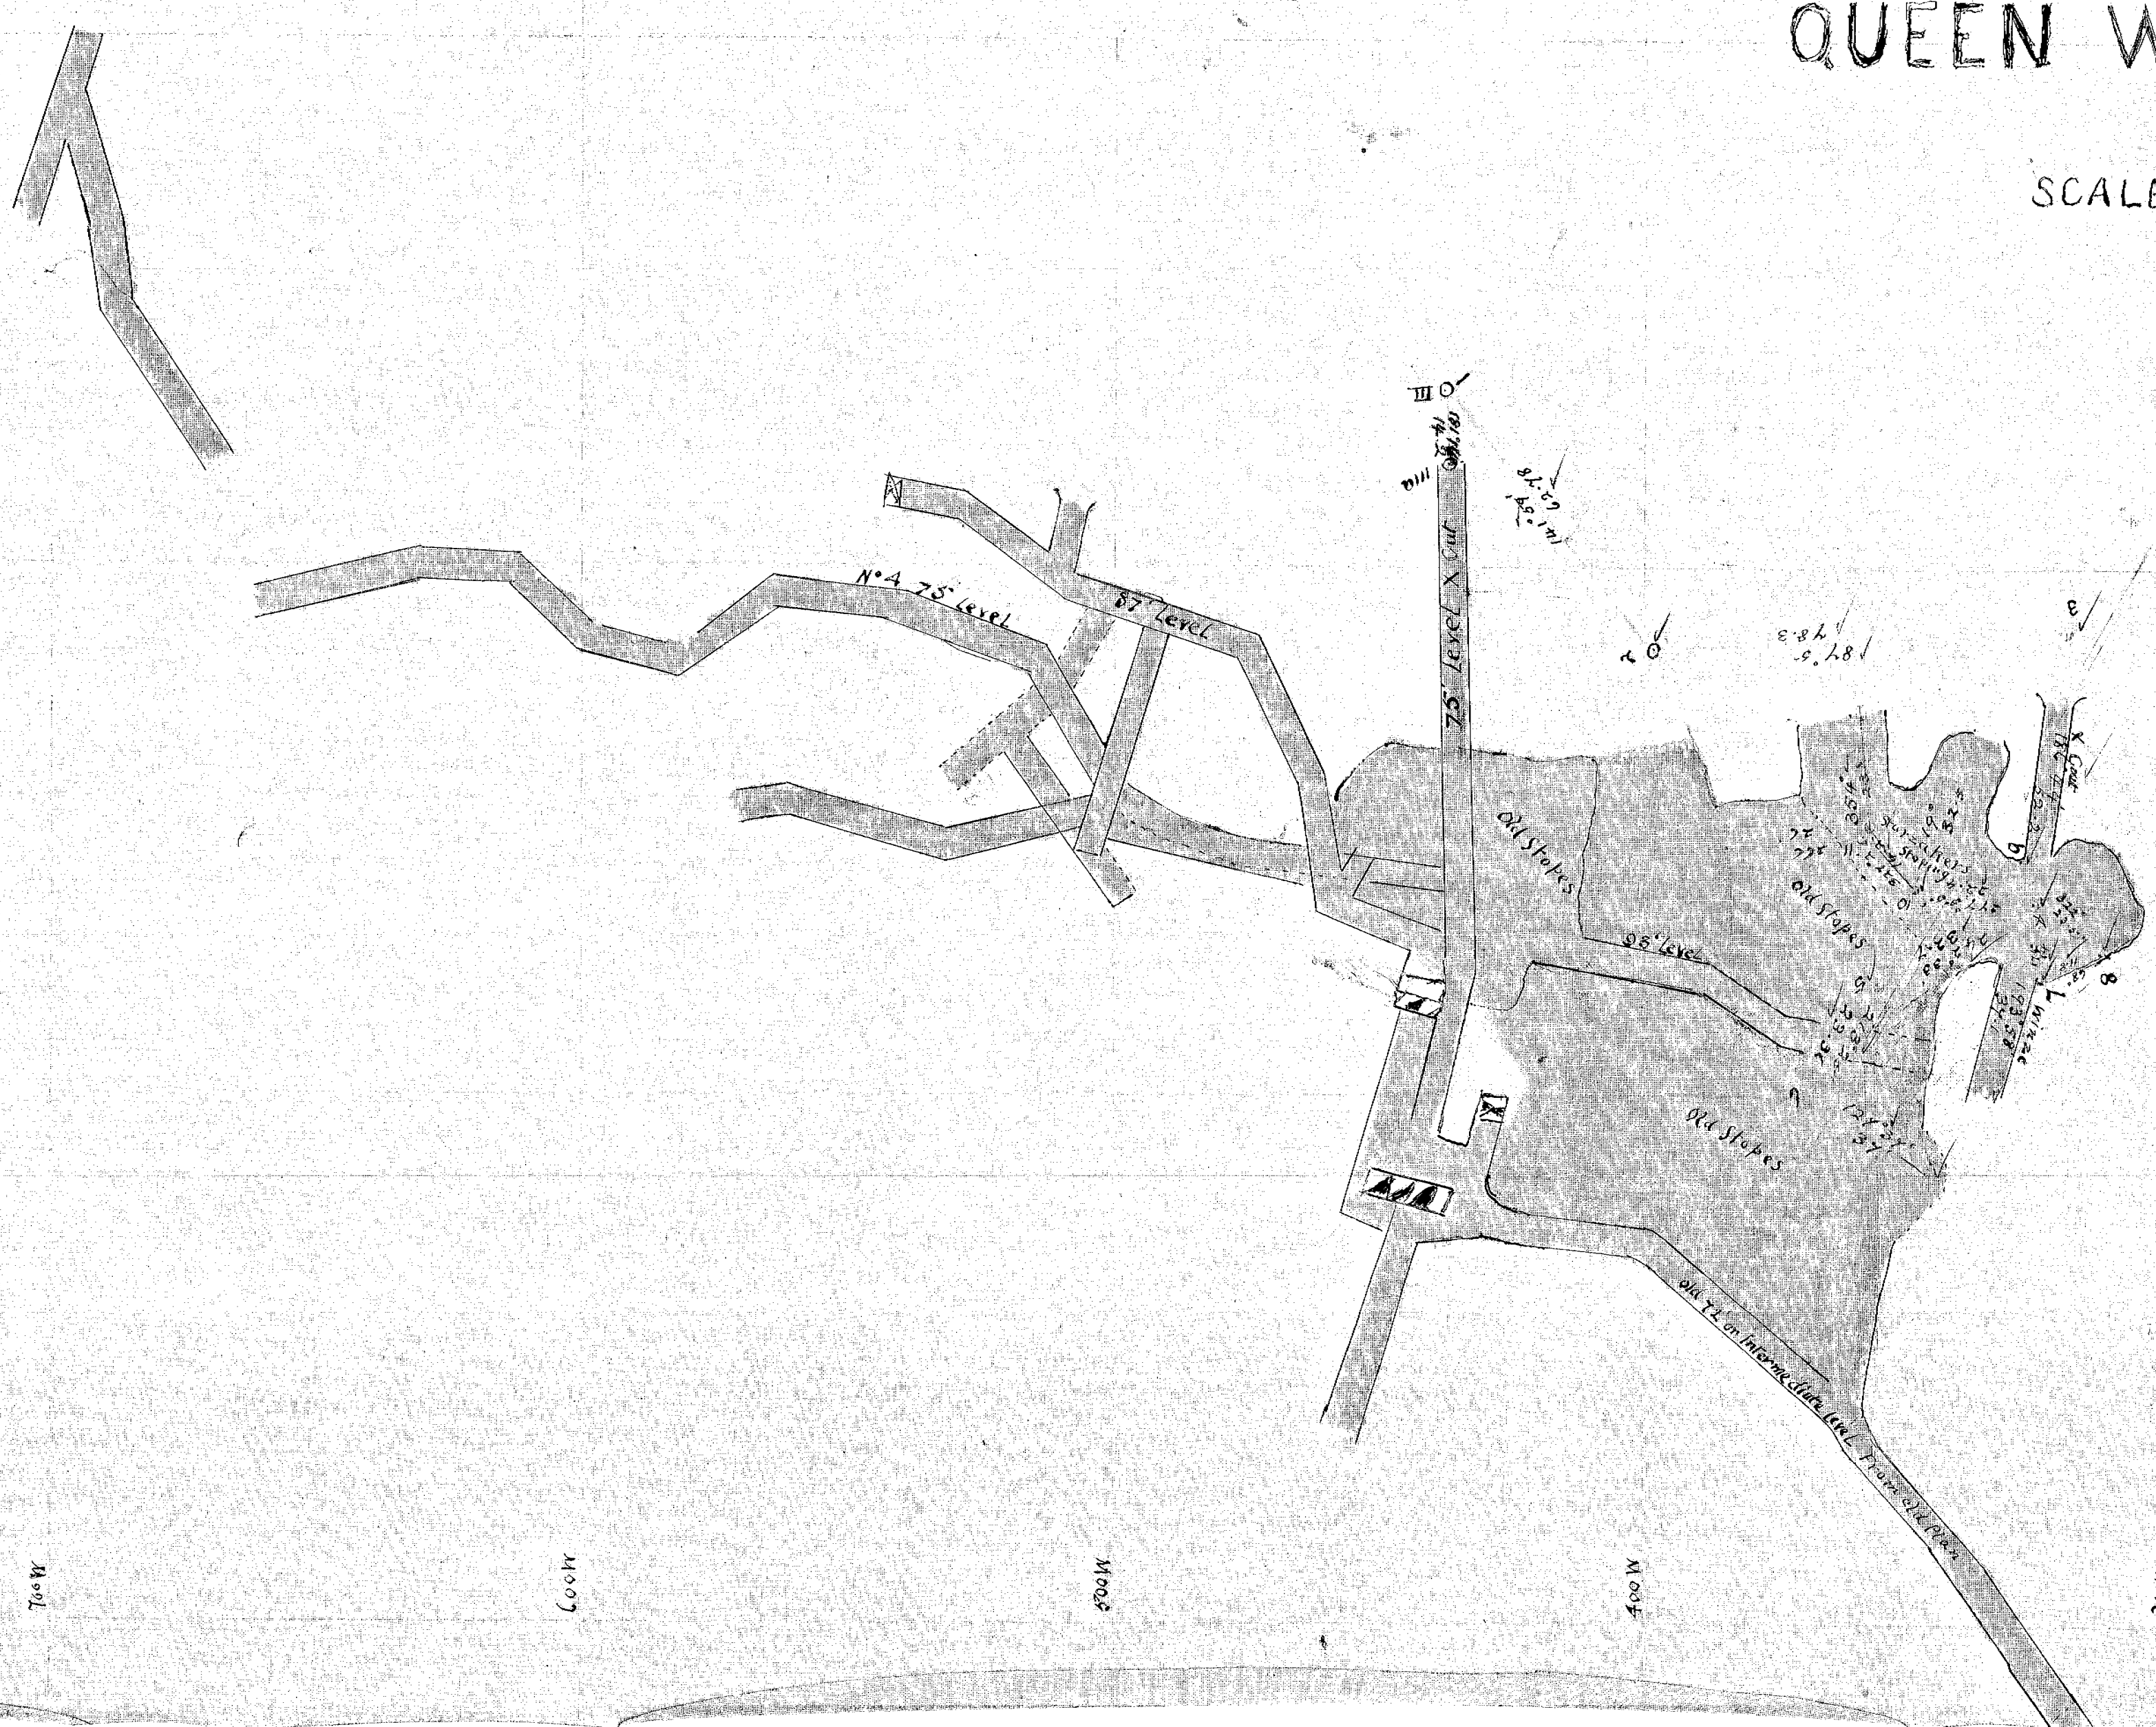

900 W
Surveyor H. Port
But used 4" theodolite
11/3/32