


MT. BISCHOFF T.M. CO REG
 STURZAKERS STOPING
 TO SURFACE
 QUEEN WORKINGS

5m


— LONGITUDINAL SECTION —

— Scale 25 FT to 1 Inch —

217-106

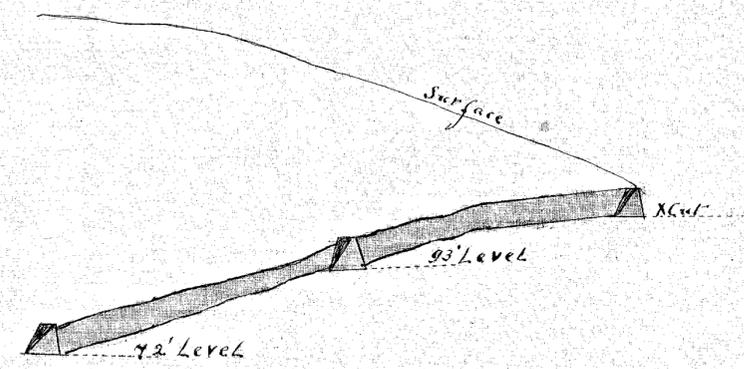

Transverse Section
 of Sturzakers Stoping

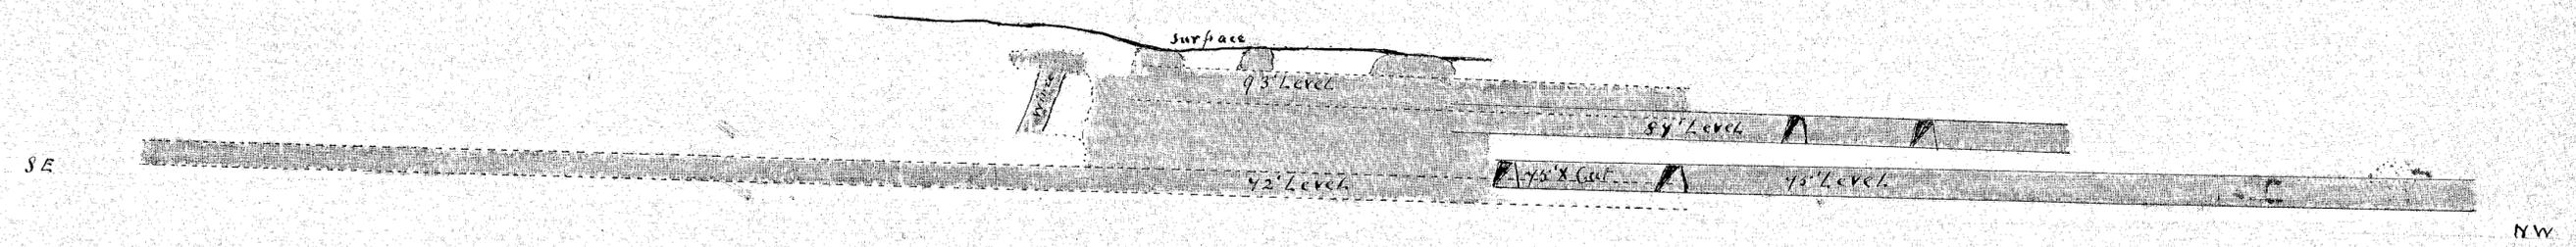

Surveyor W. Port
 first used 4" theodolite
 11/3/32

217-106