

MT BISCHOFF T. M. CO. REG.

QUEEN LODGE

— SCALE 25 FT TO 1 INCH —

5 cm

3000' N


217-108

2900' N

2800' N

2700' N

217-108

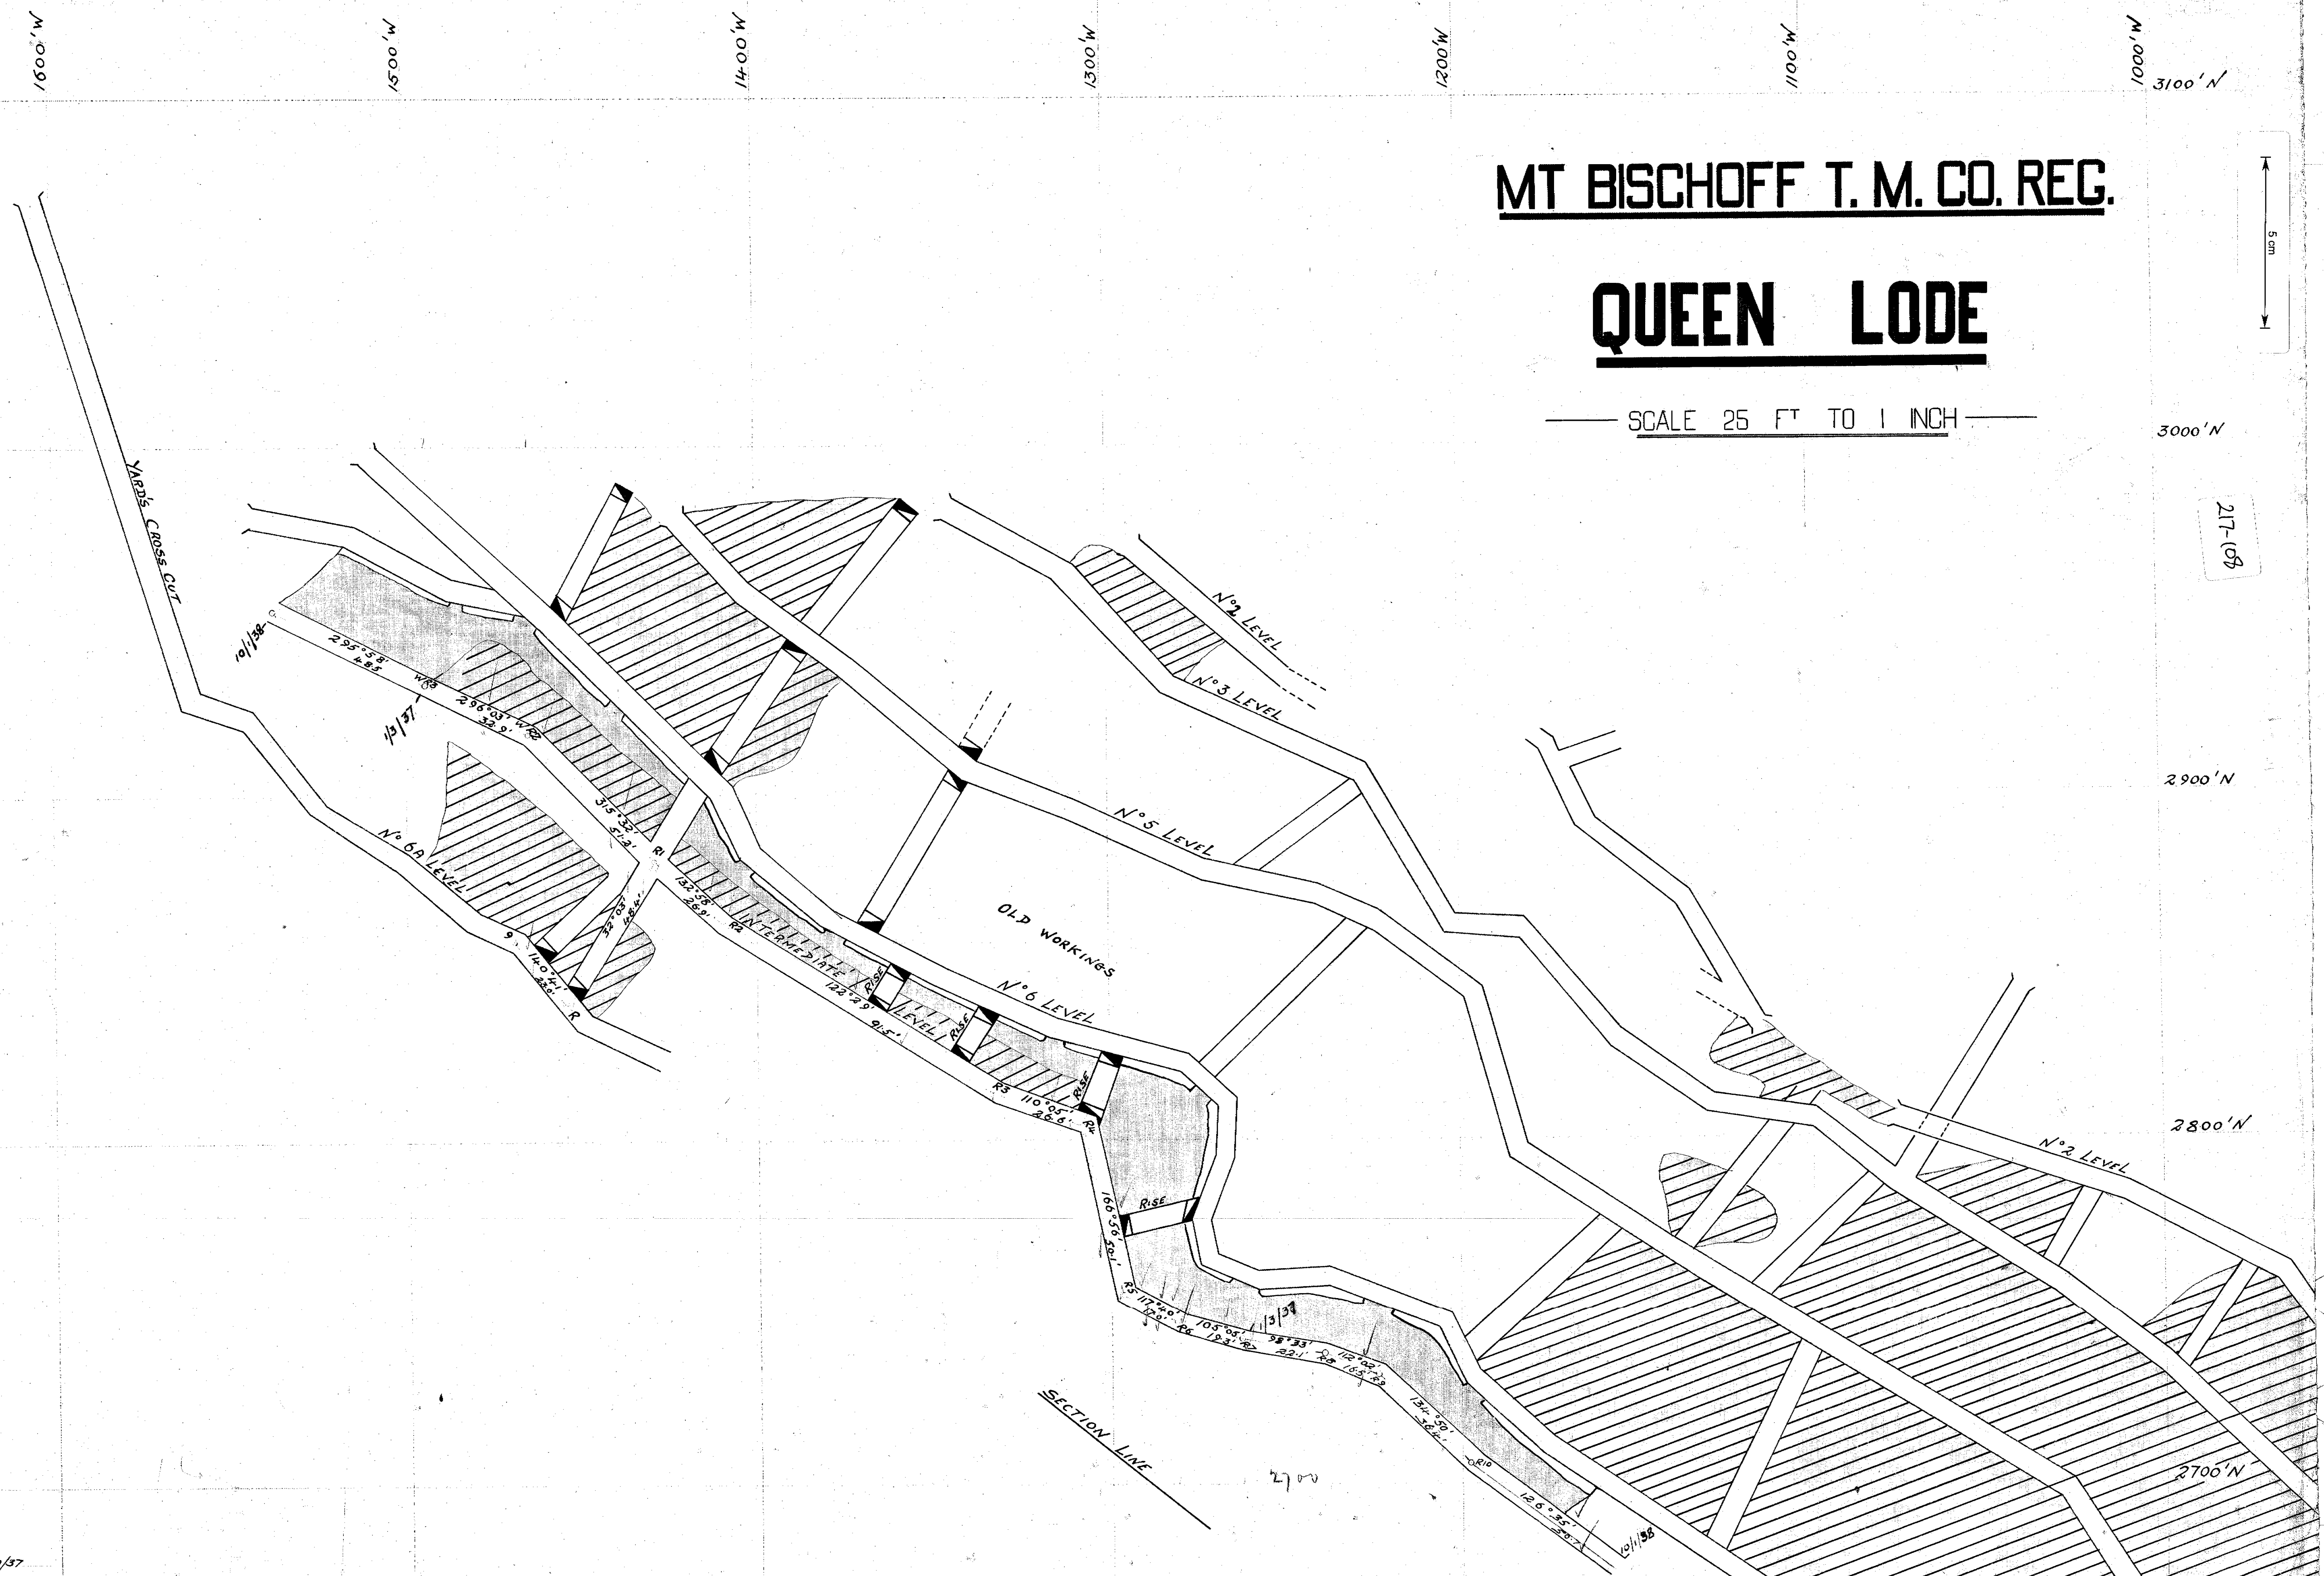

SECTION LINE

SECTION LINE

Planned
1/3/37 1/3/38

WORK 1936
SURVEYOR G. T. B. & C.
NOT USED 5 THEORETICAL
DATE 7th June 1937
COMPLETE TO 3/12/37