

— MT BISCHOFF T.M.CO.REG. —


— QUEEN LODGE —

— SCALE 25 FT TO 1 INCH —

217-109

5 cm

217-109

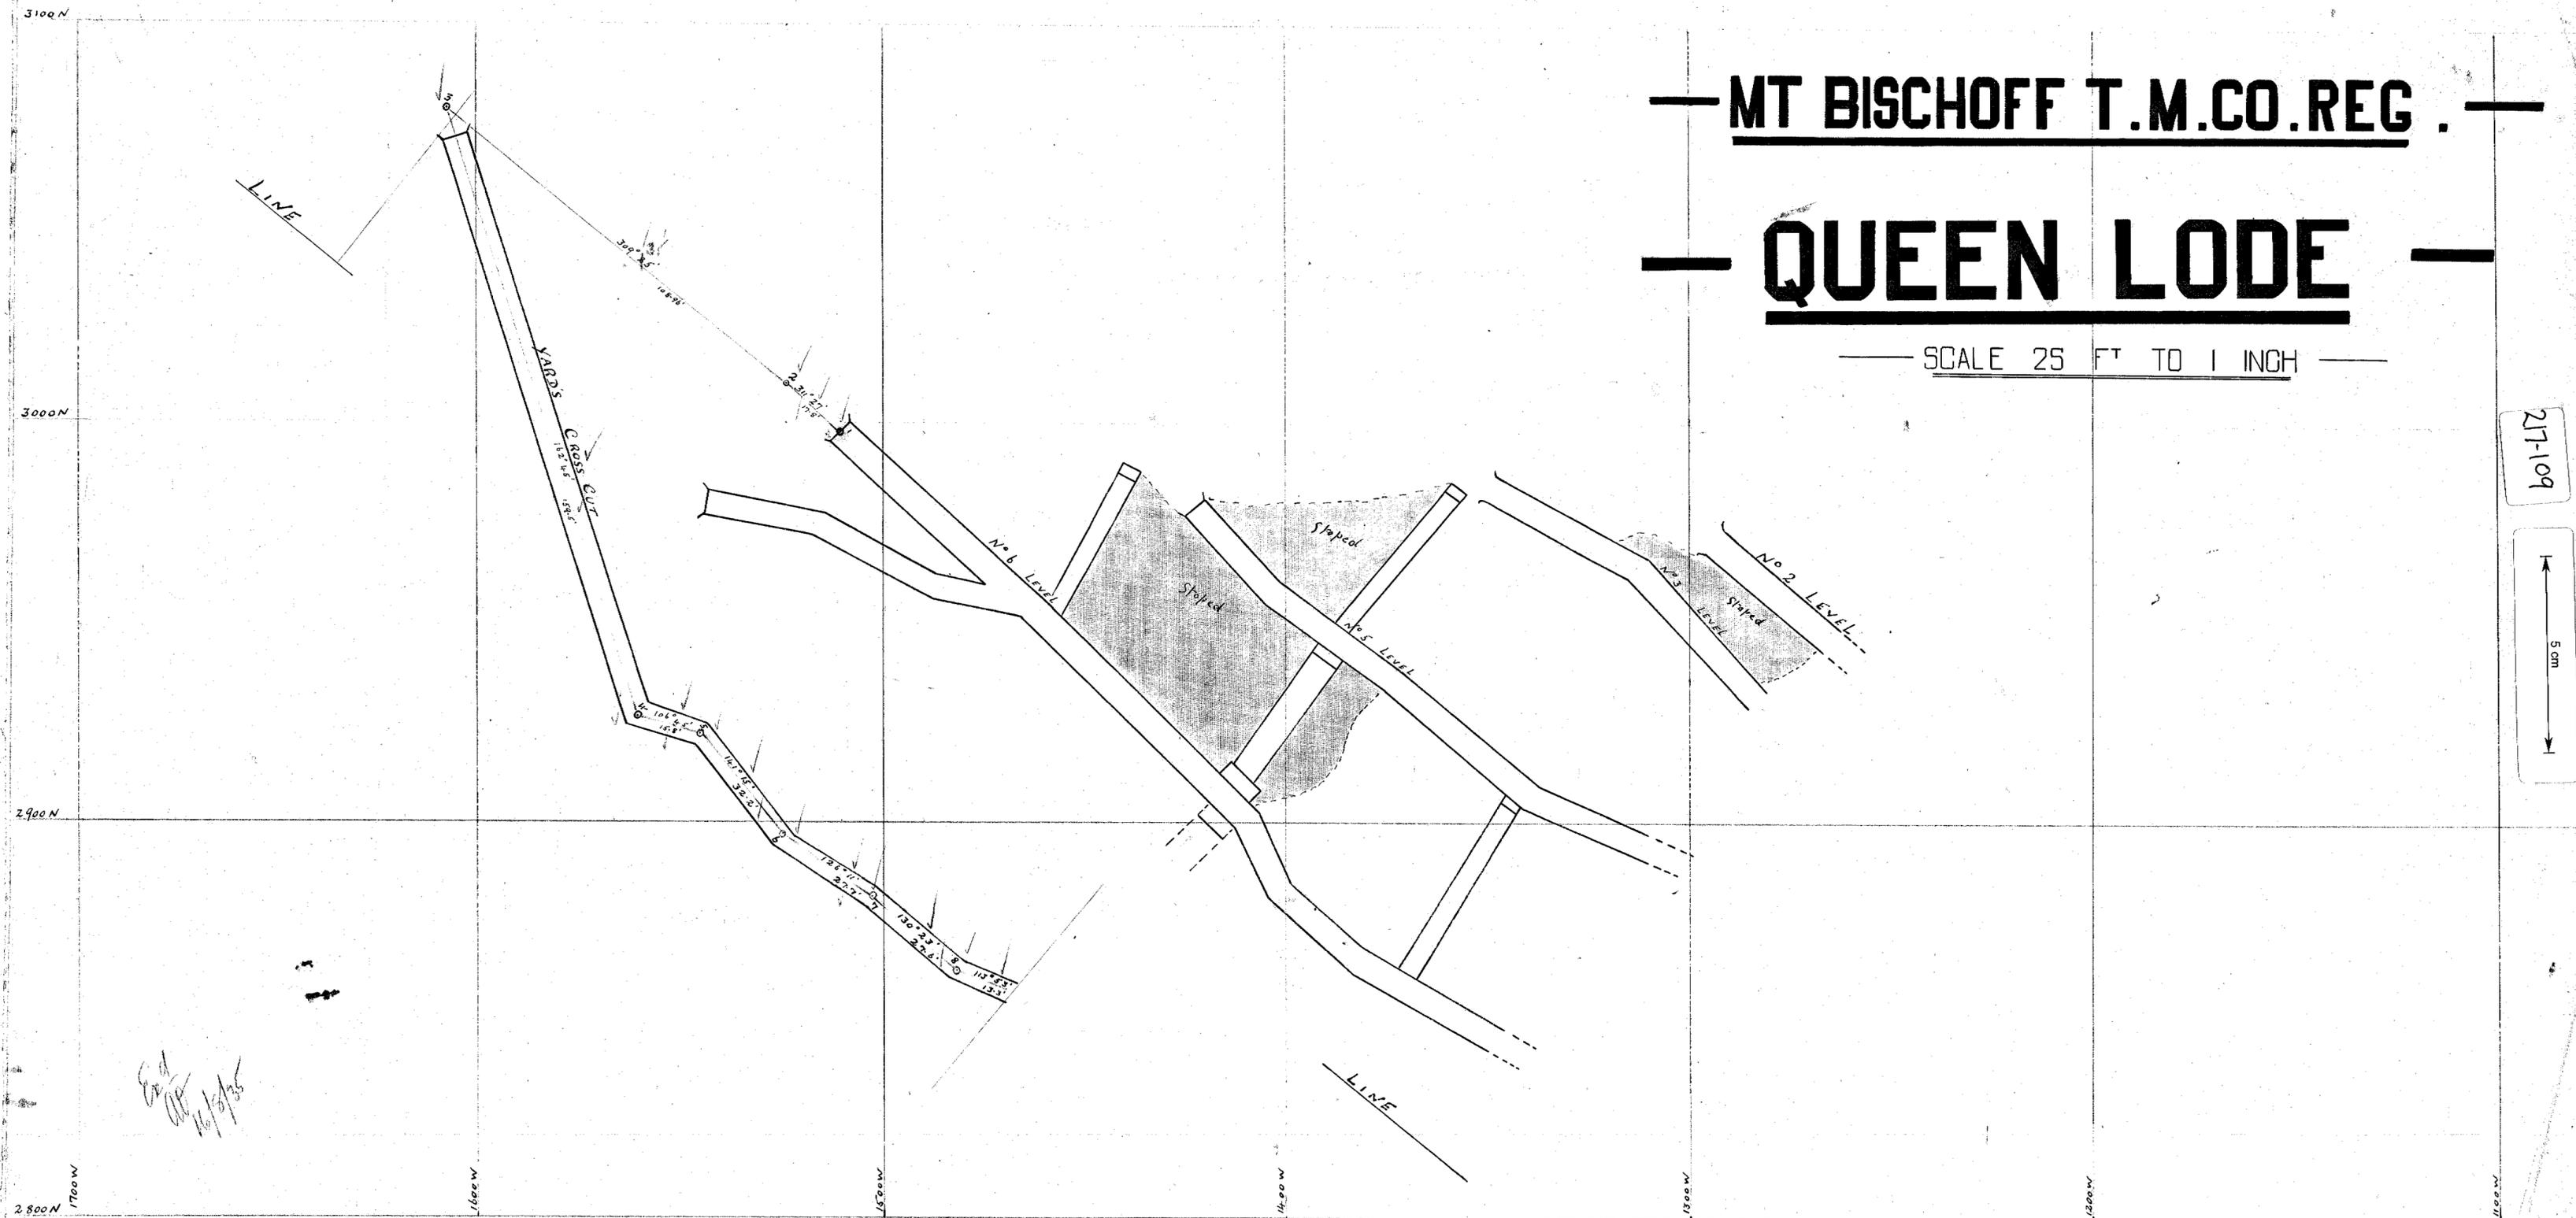

*End
OK
10/13/35*

*Work 1934
Surveyor W. Porter
Just ahead 5' ahead*