

1200'W

1100'W

1500'N


1400'N

Mt. Bischoff T.M. Co. Reg.


Stoping Performed during 1924.

Scale 25' = 1"


*W. K. ...  
Coy. Surveyor.*

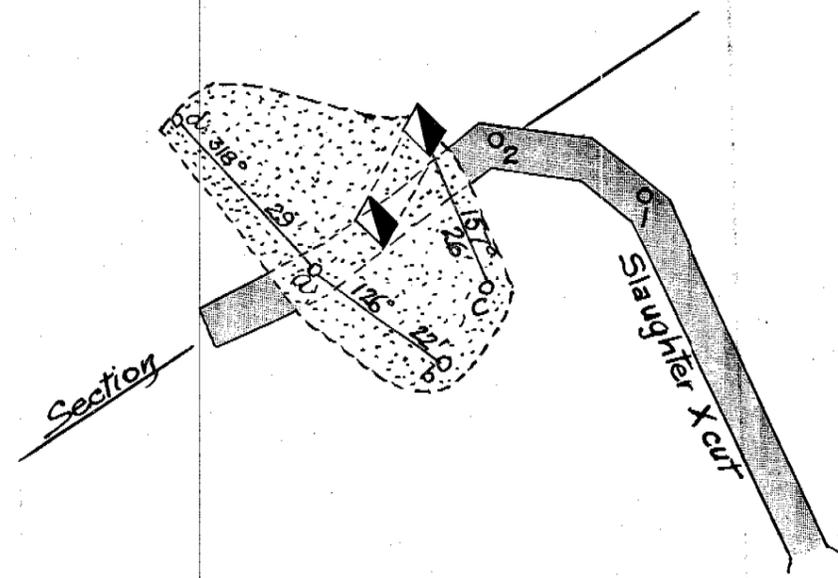


N°2 Slaughter Lode.

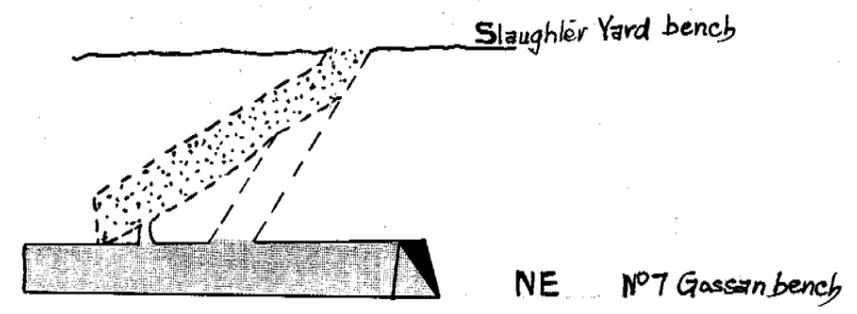

Transverse Section

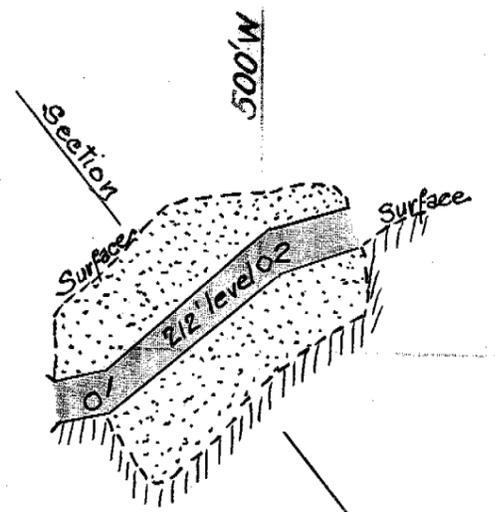

212' Level Queen Workings

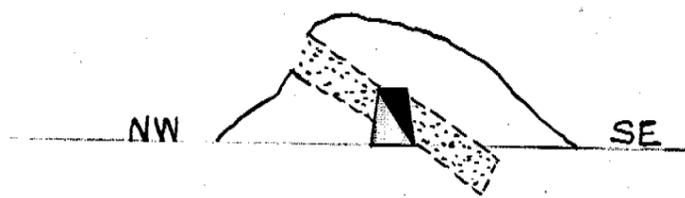

Transverse Section

217-111

217-111