


217-113

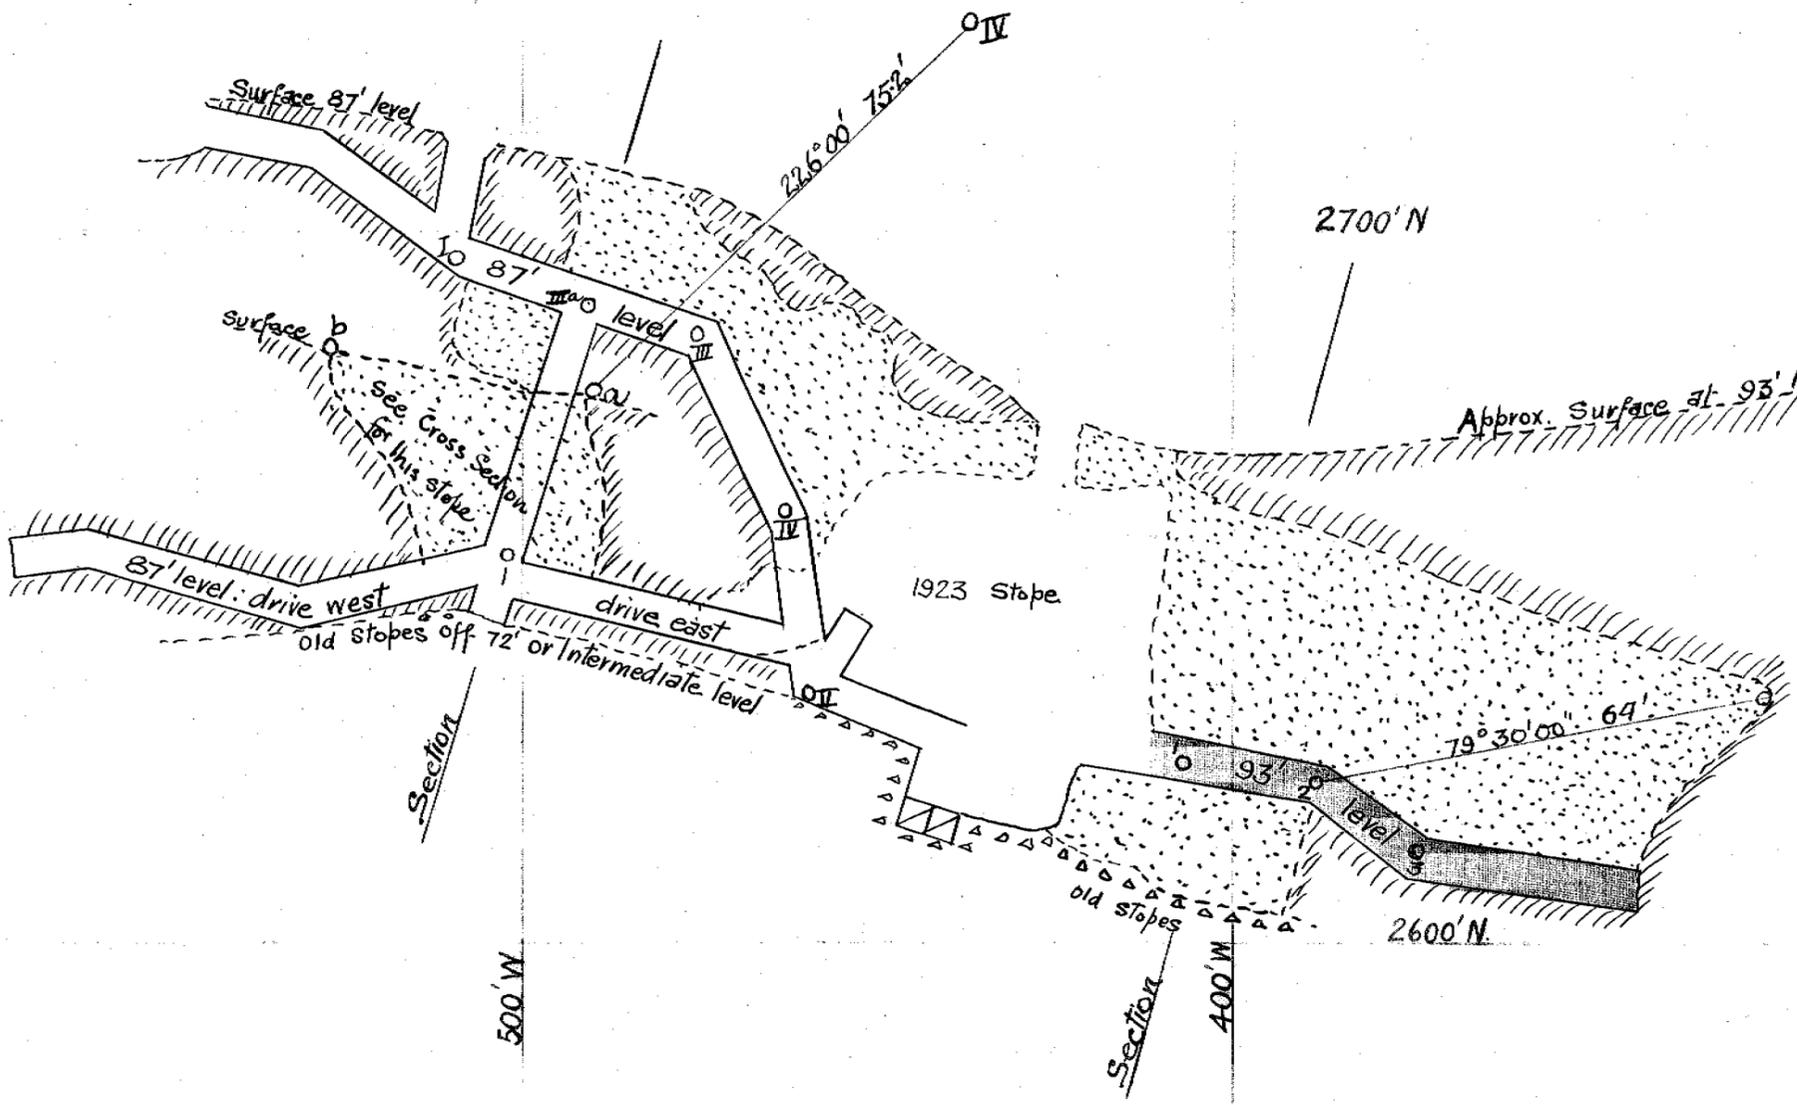


— Mt. Bischoff T. M. Co. Reg. —

Stoping on 87' and 93' levels during 1924.


Scale 25' = 1"

Solid Ground: Hatched  
 Stopped Ground: Stippled.

*W. H. Lewis*  
 Coy. Surveyor.

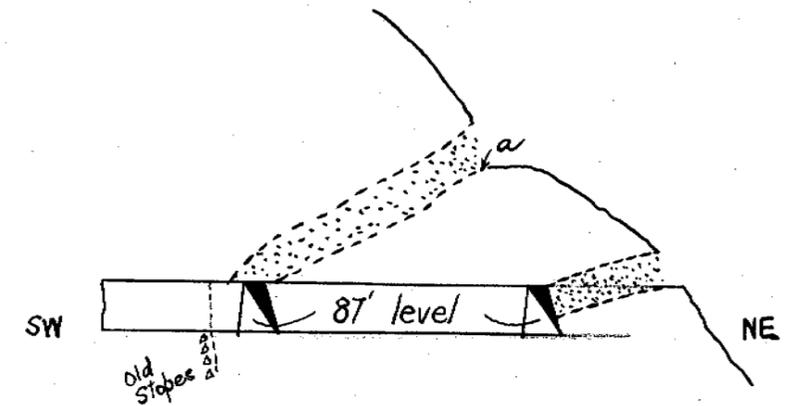

Section across 87' Stopes

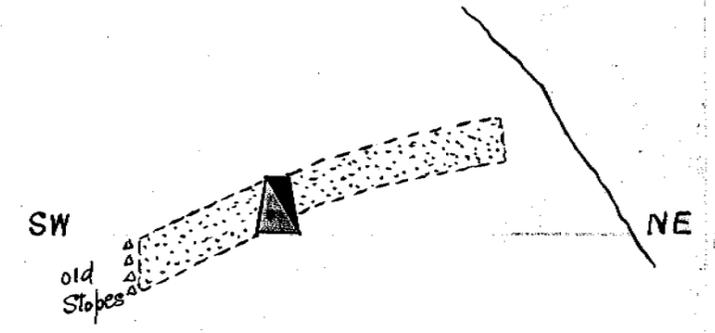

Section across 93' Stopes.

217-113