


5 cm

217-115

Mt BISCHOFF T M C. REG
 WORKINGS ON CROSS LODGE AND FLAT MAKE

TRANSVERSE SECTION ON LINE C D

SCALE 25 FT TO 1 INCH

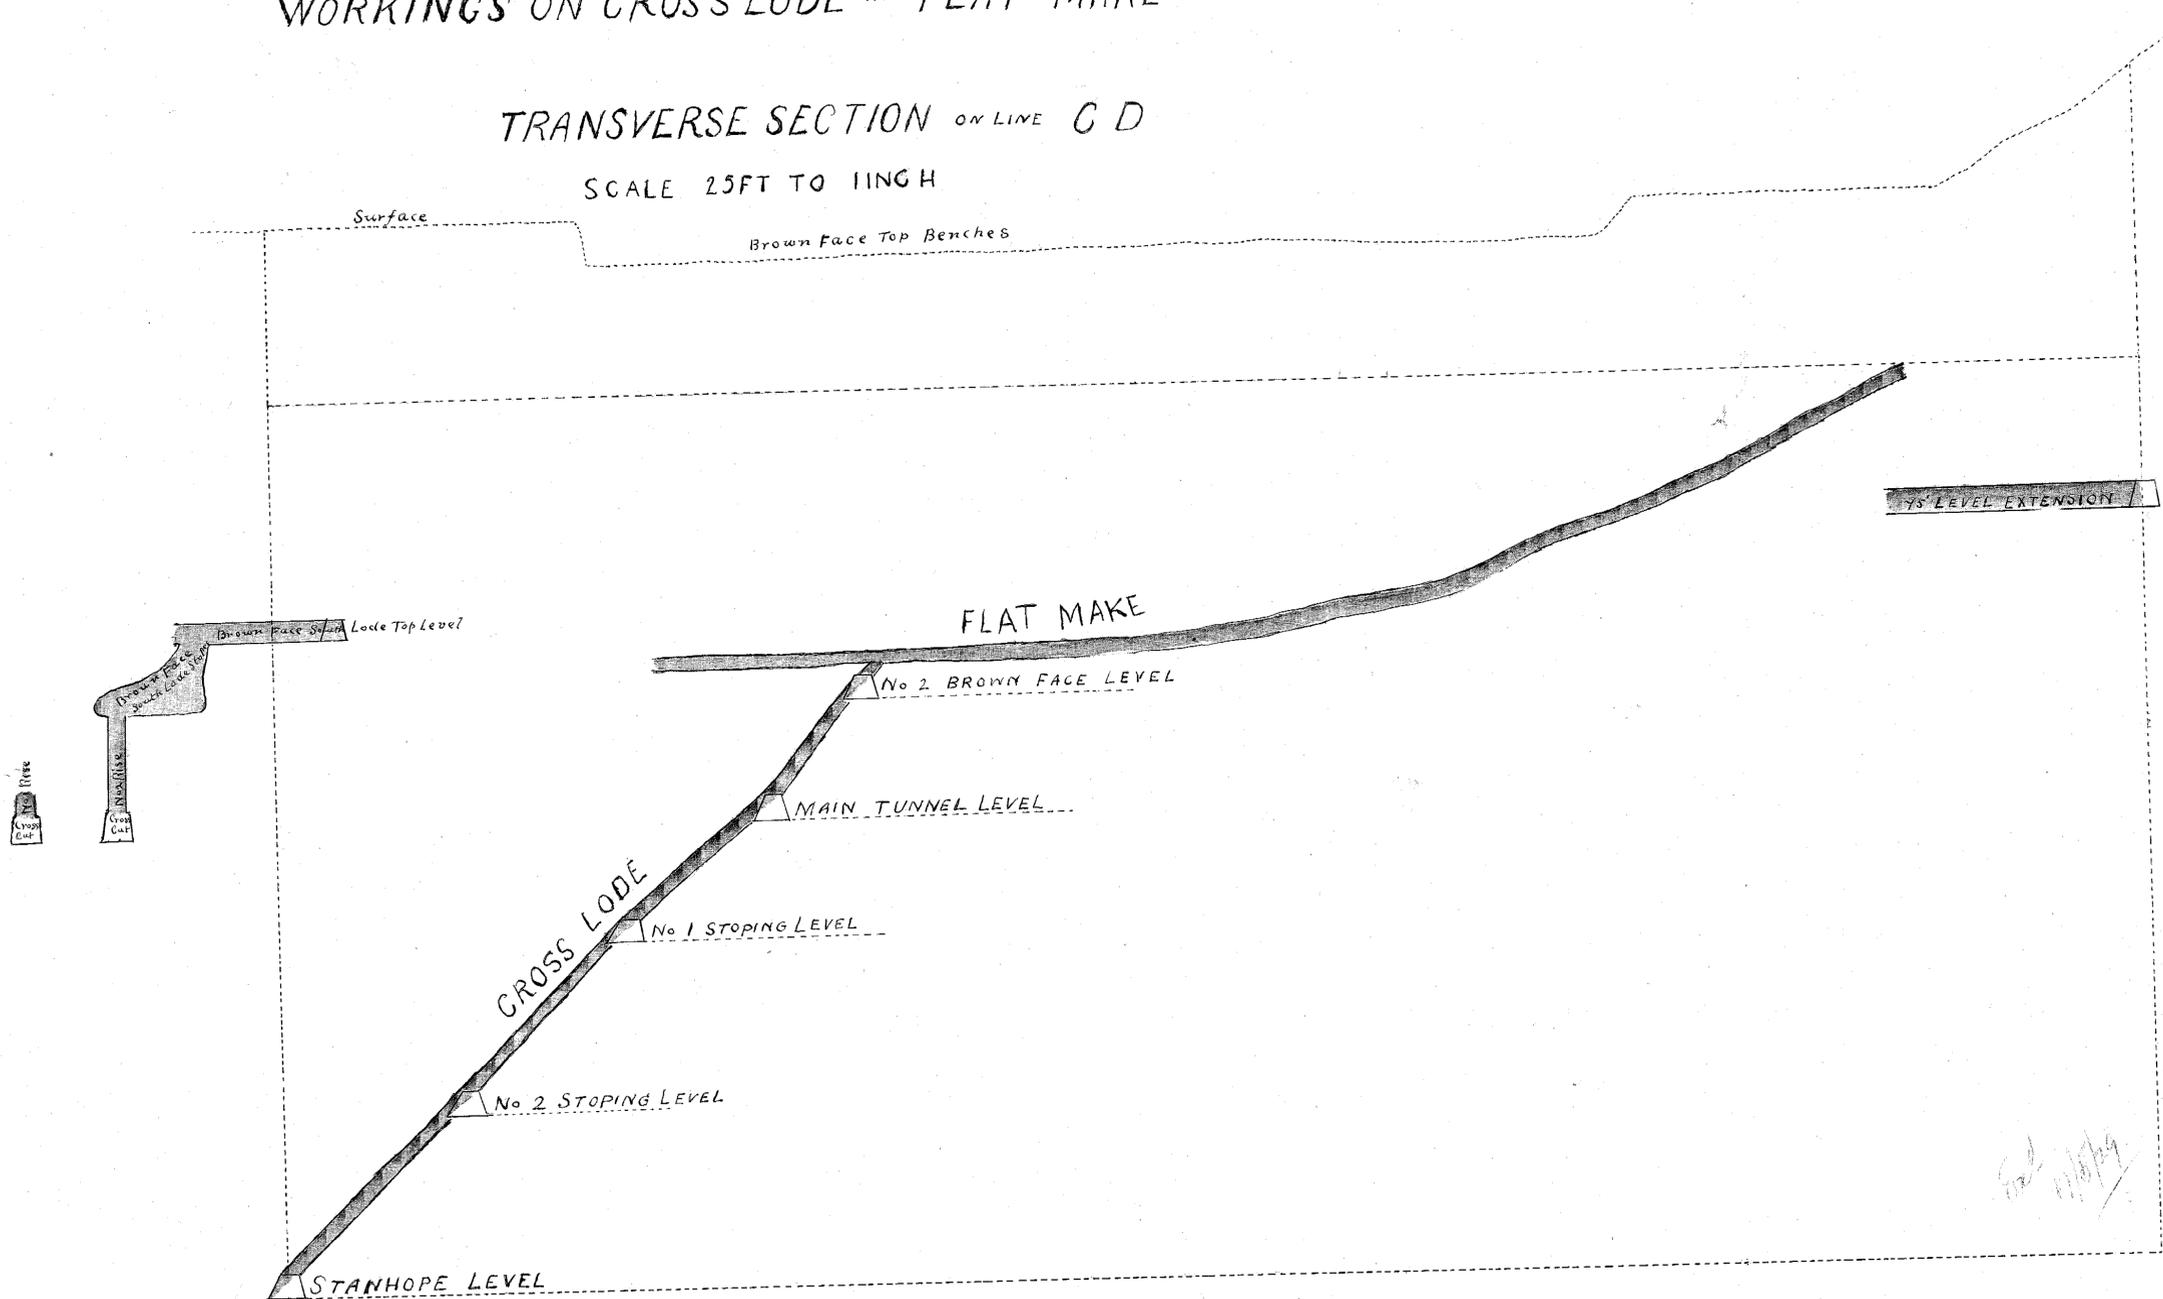

Handwritten signature or initials in the bottom right corner.

Surveyor W. P. ... and 14" theodolite