


DRIVE CONNECTING 75' LEVEL AND FLAT MAKE.

SCALE 25 FT. = 1 IN

217-116

12 0 10

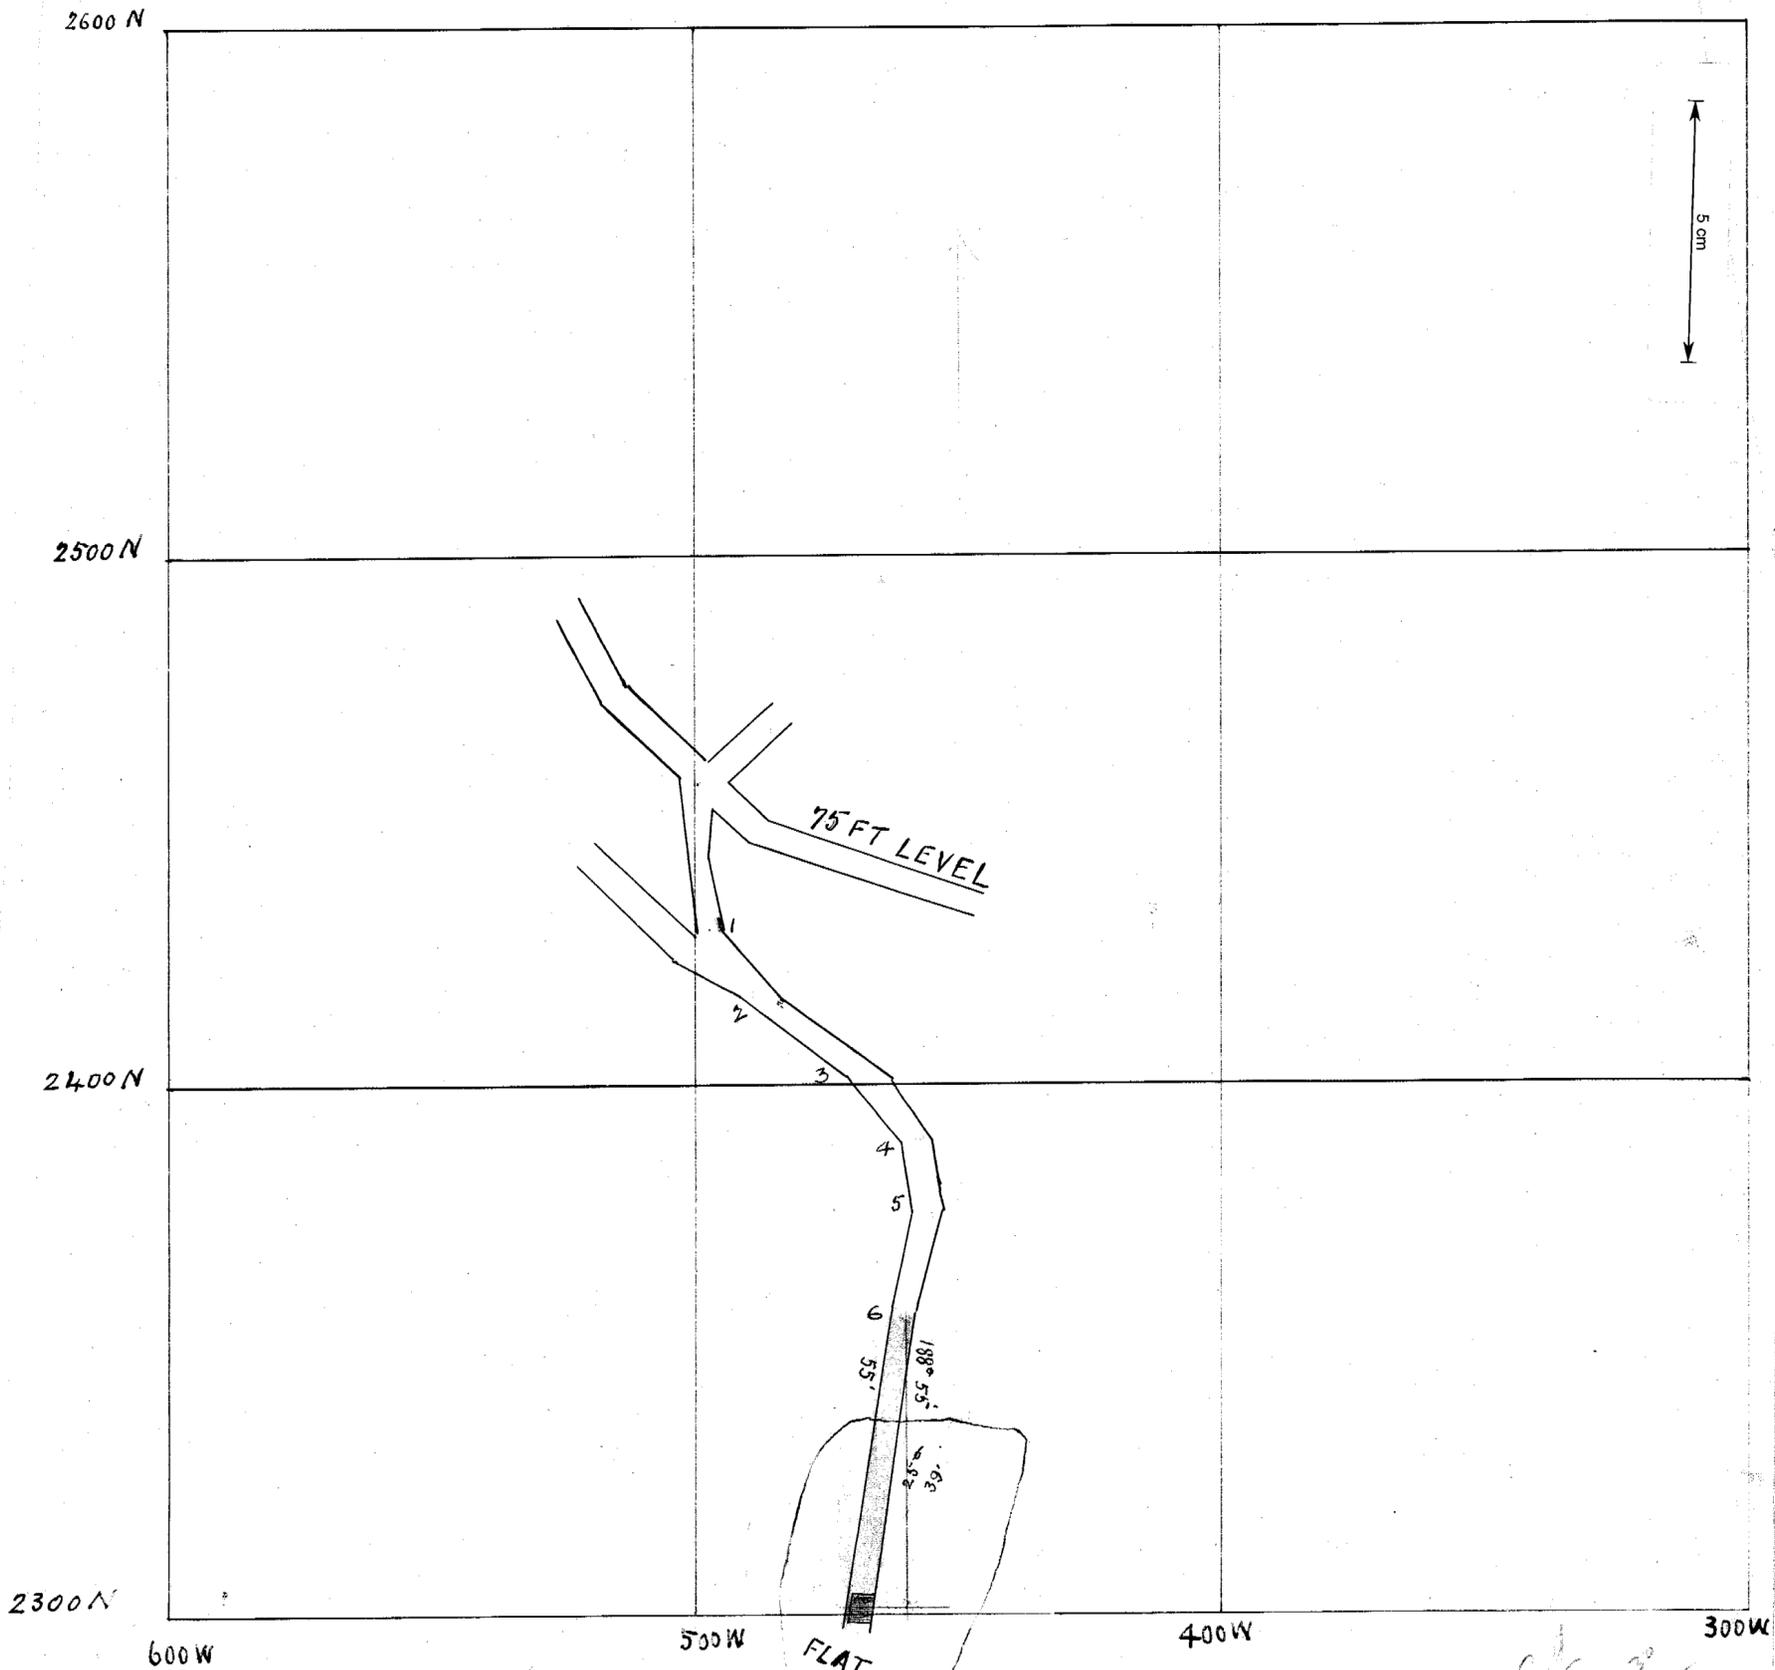

217-116

J. H. Levings
Surveyor.

Ed
17-5-30