


MT. BISCHOFF T.M.CO. RFG.

FLAT MAKE STOPES

SCALE 25 FT = 1 IN


217-117

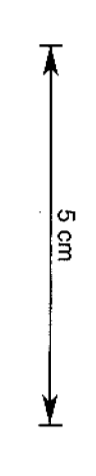

2300 N

2200 N

2100 N

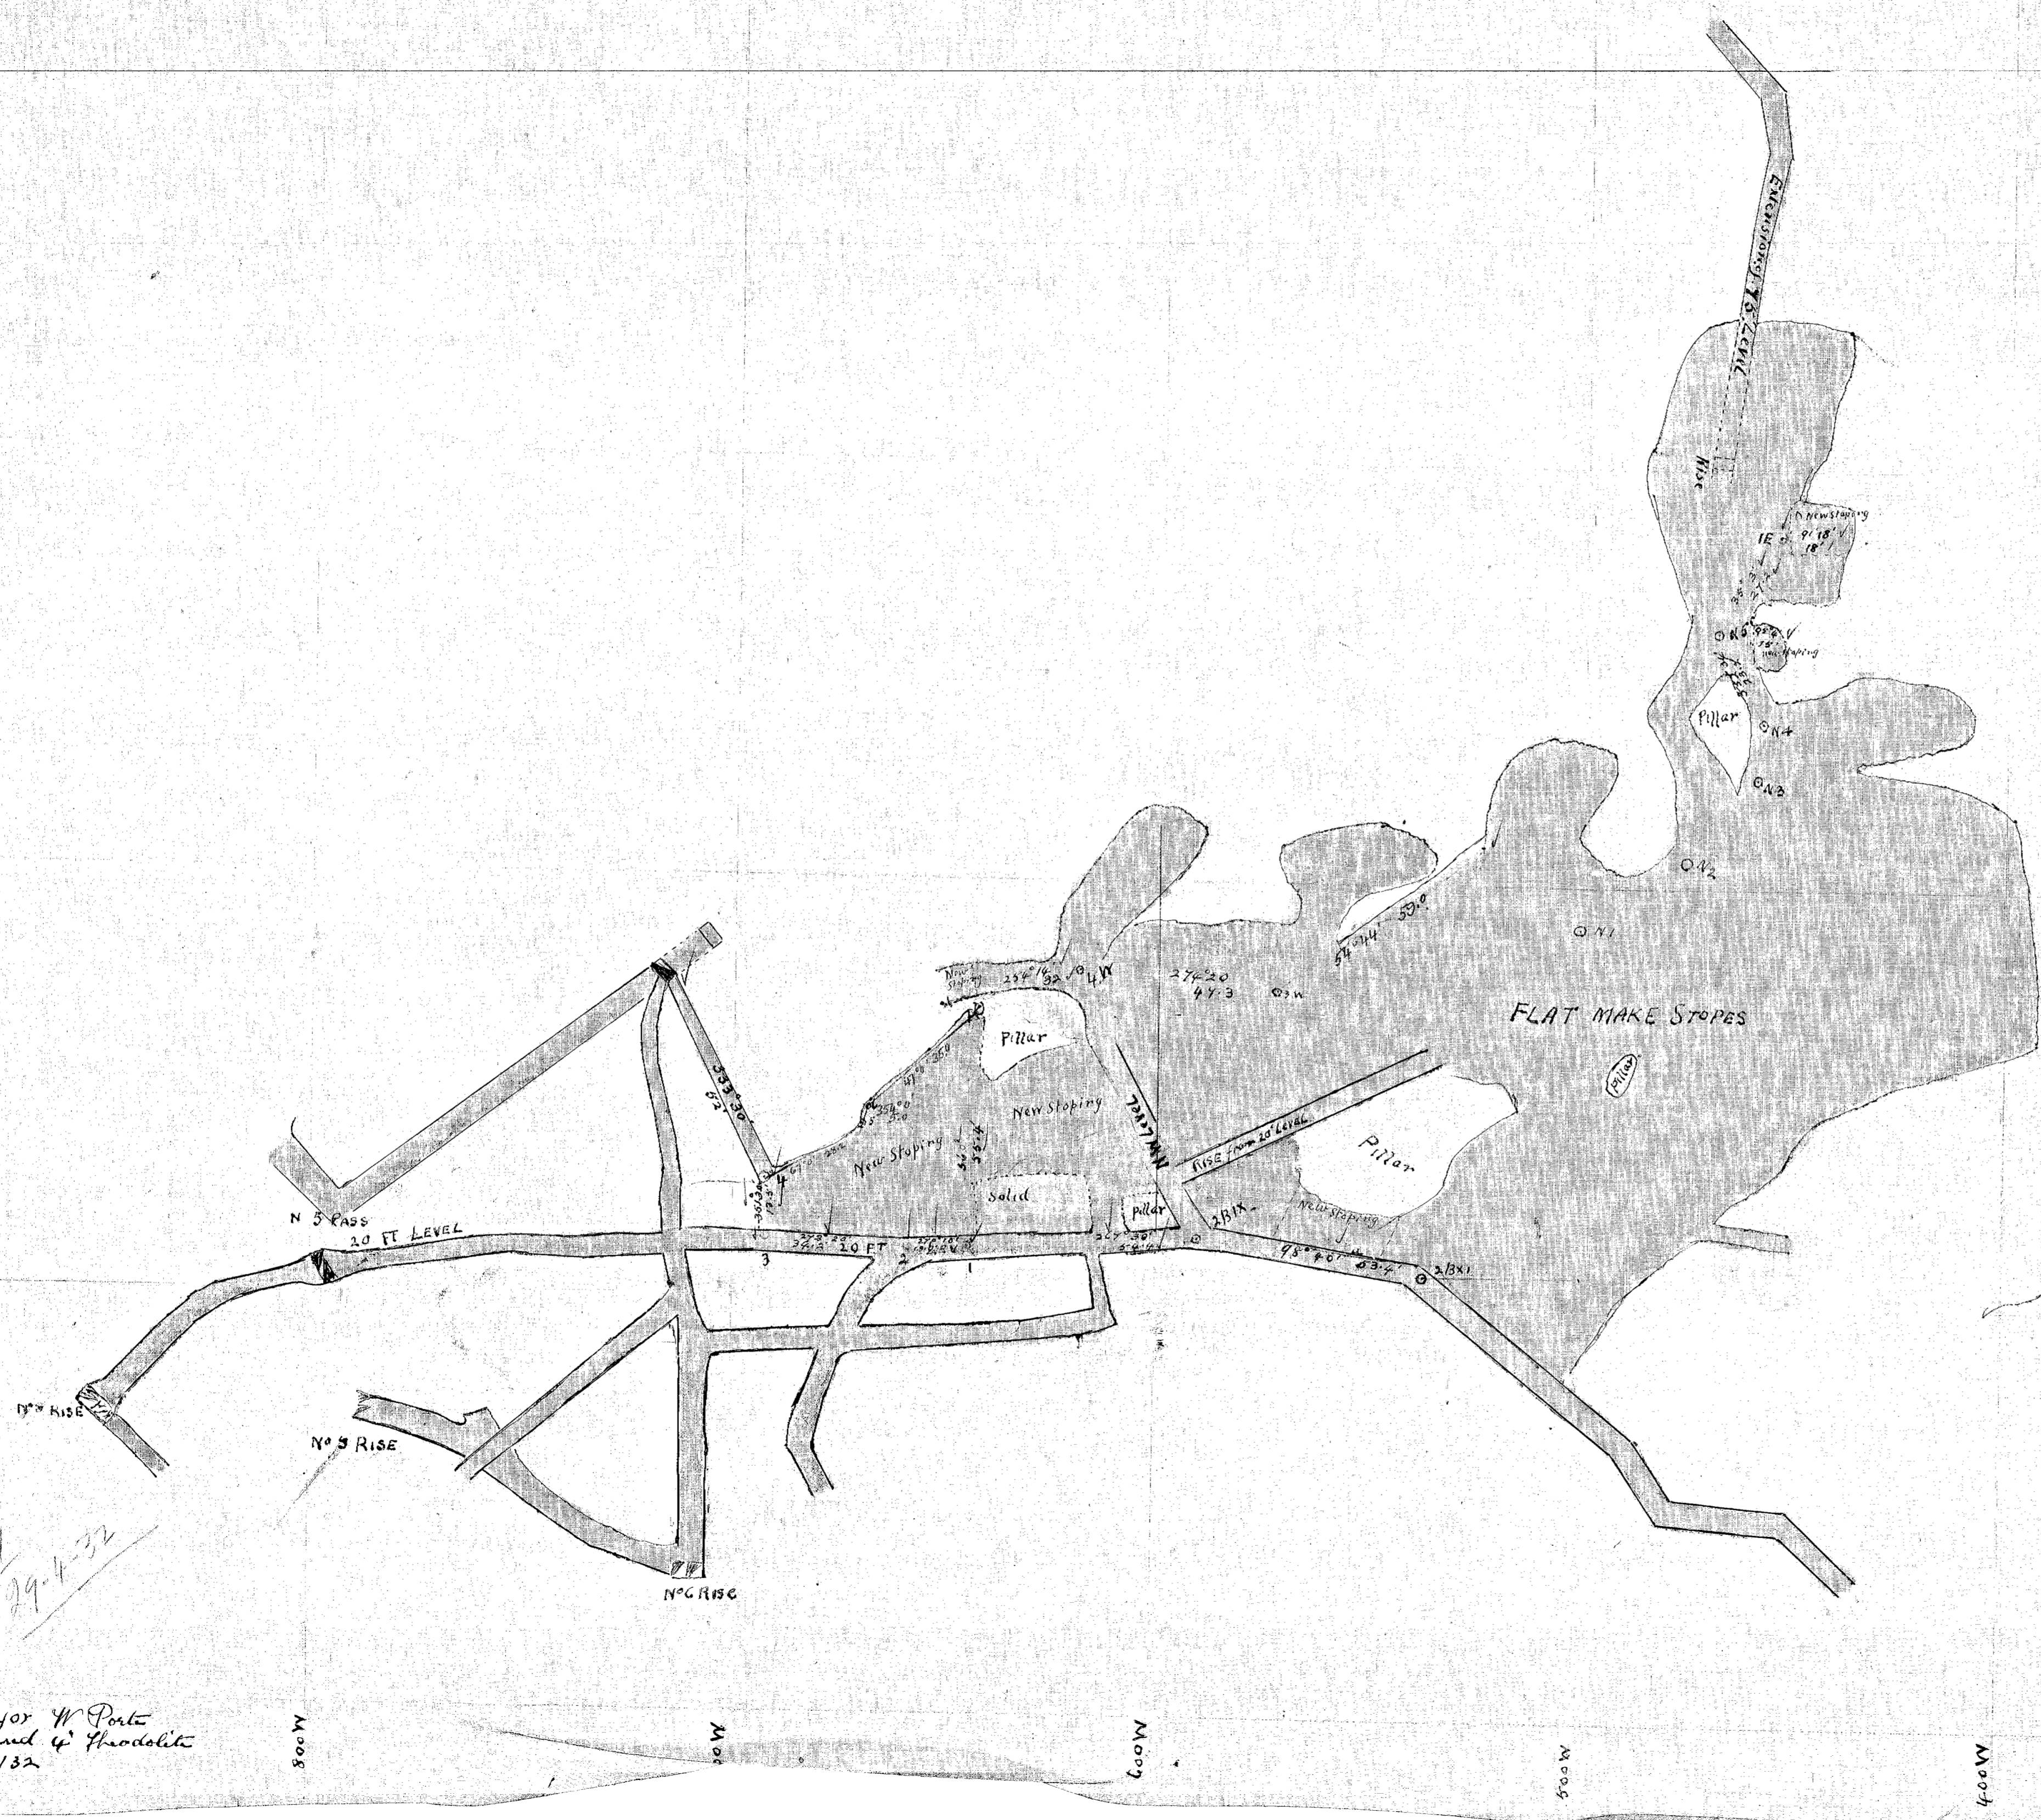

Ed 29-1-32

Surveyor W. P. Porter
used up theodolite
11/2/32

217-117