

217-118


# MT BISCHOFF T M C. REG

## WORKINGS ON CROSS LODGE AND FLAT MAKE

AND BROWN FACE SOUTH LODGE

### SECTION ON LINE A-B

Scale 2.5 ft = 1 Inch

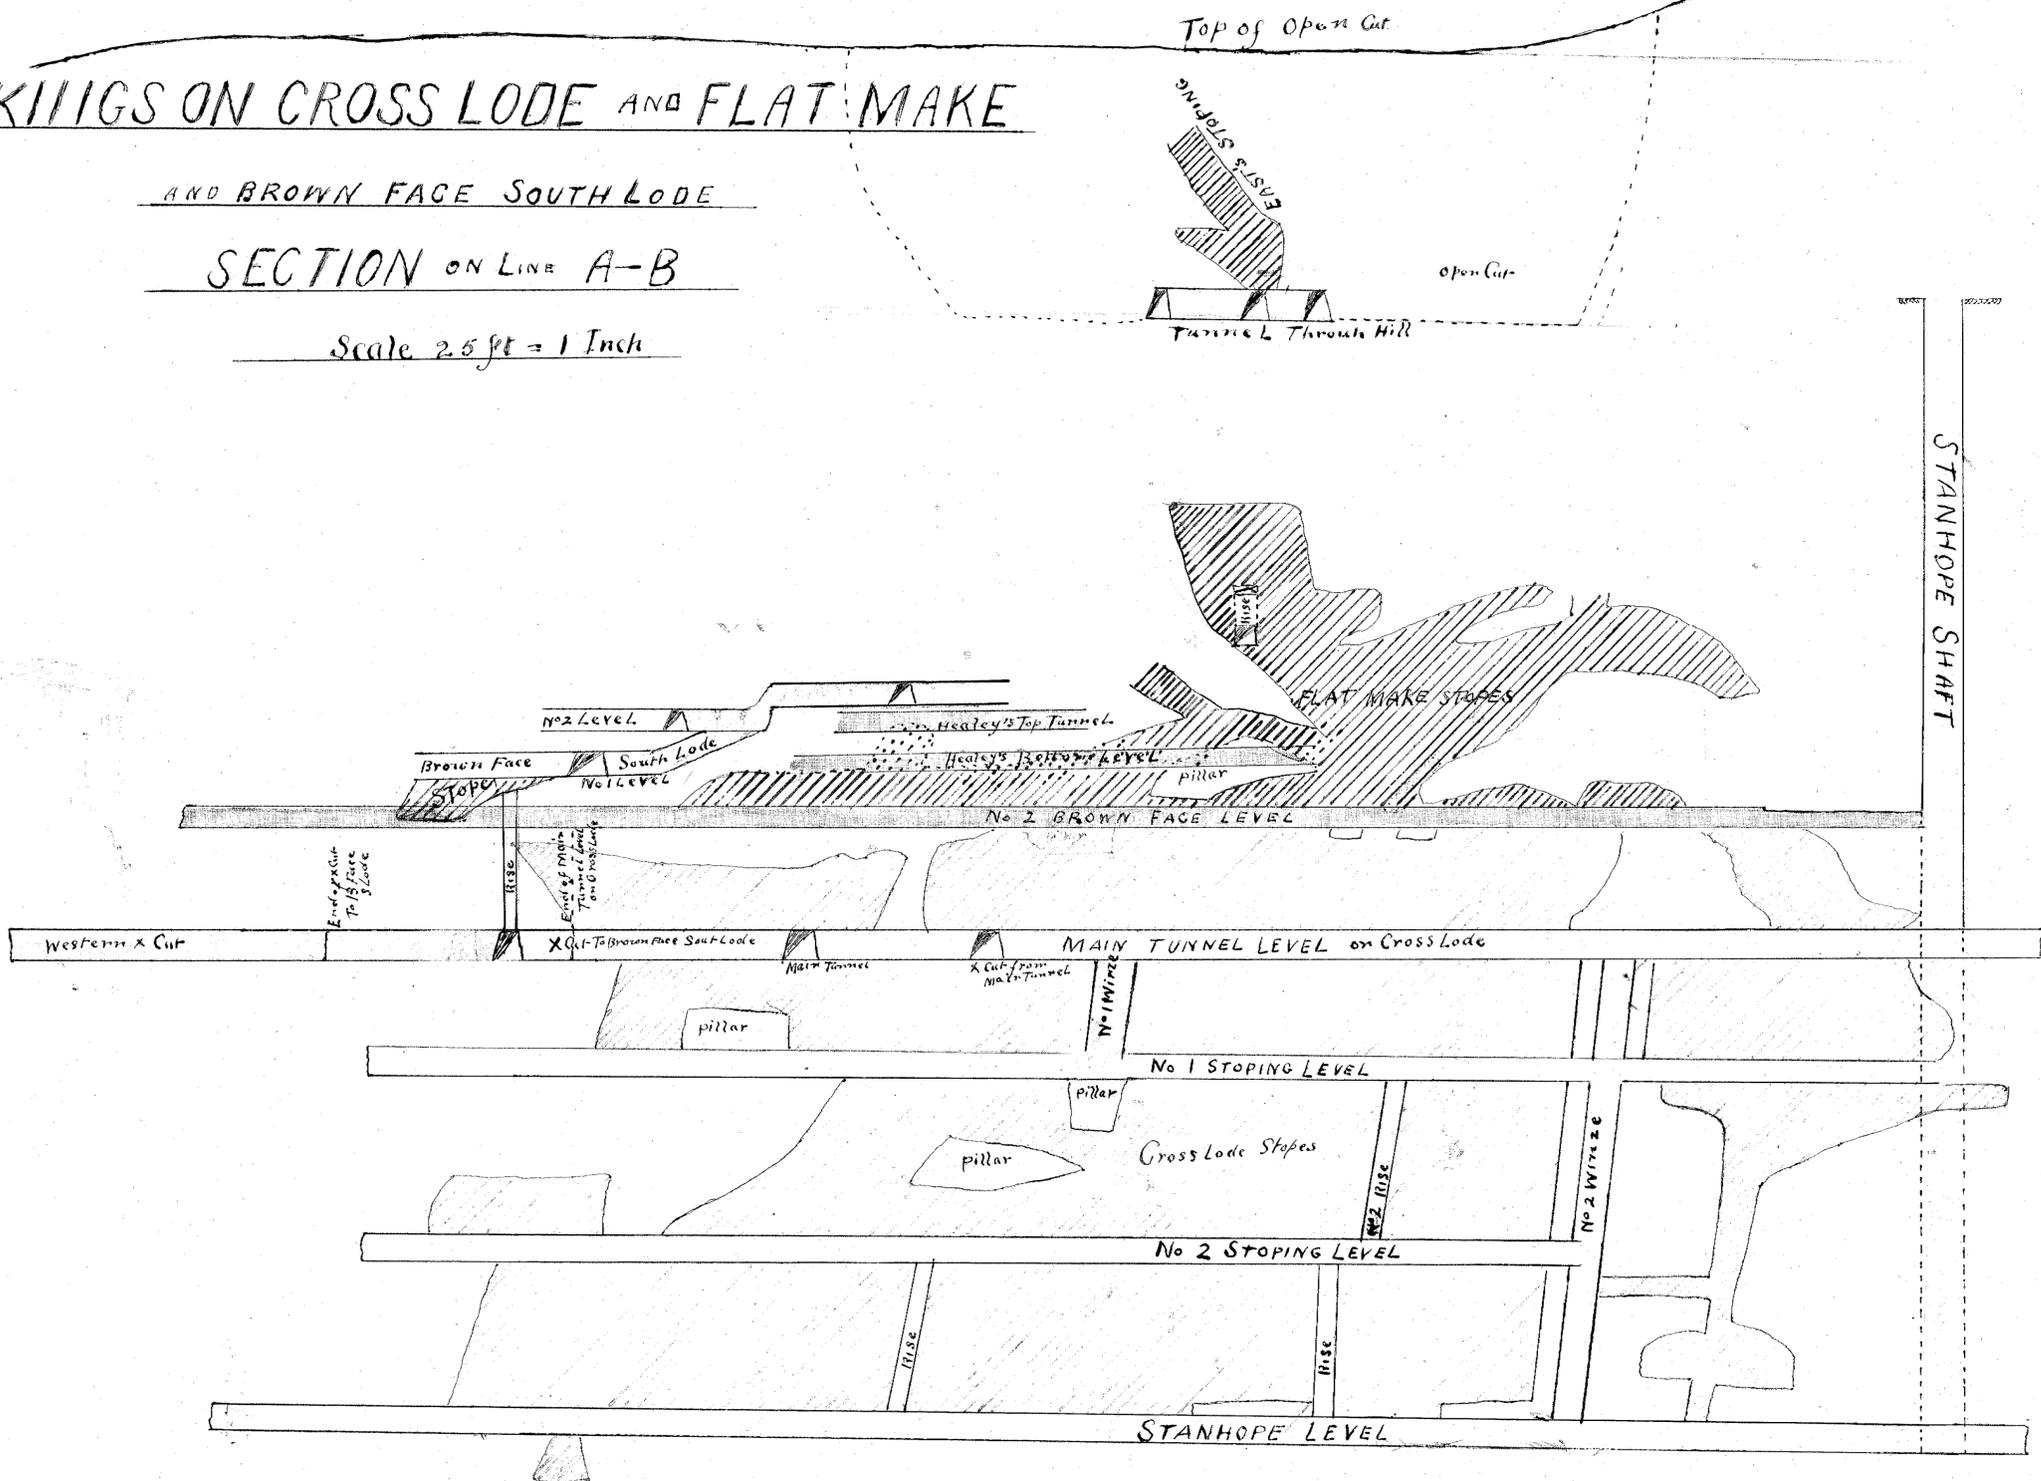

217-118

Work 1932  
 Surveyor W. P. ...  
 10/4/33