


MT BISCHOFF T M C. REG

WORKINGS ON CROSS LODGE AND FLAT MAKE

LONGTITUDINAL SECTION ON LINE A B

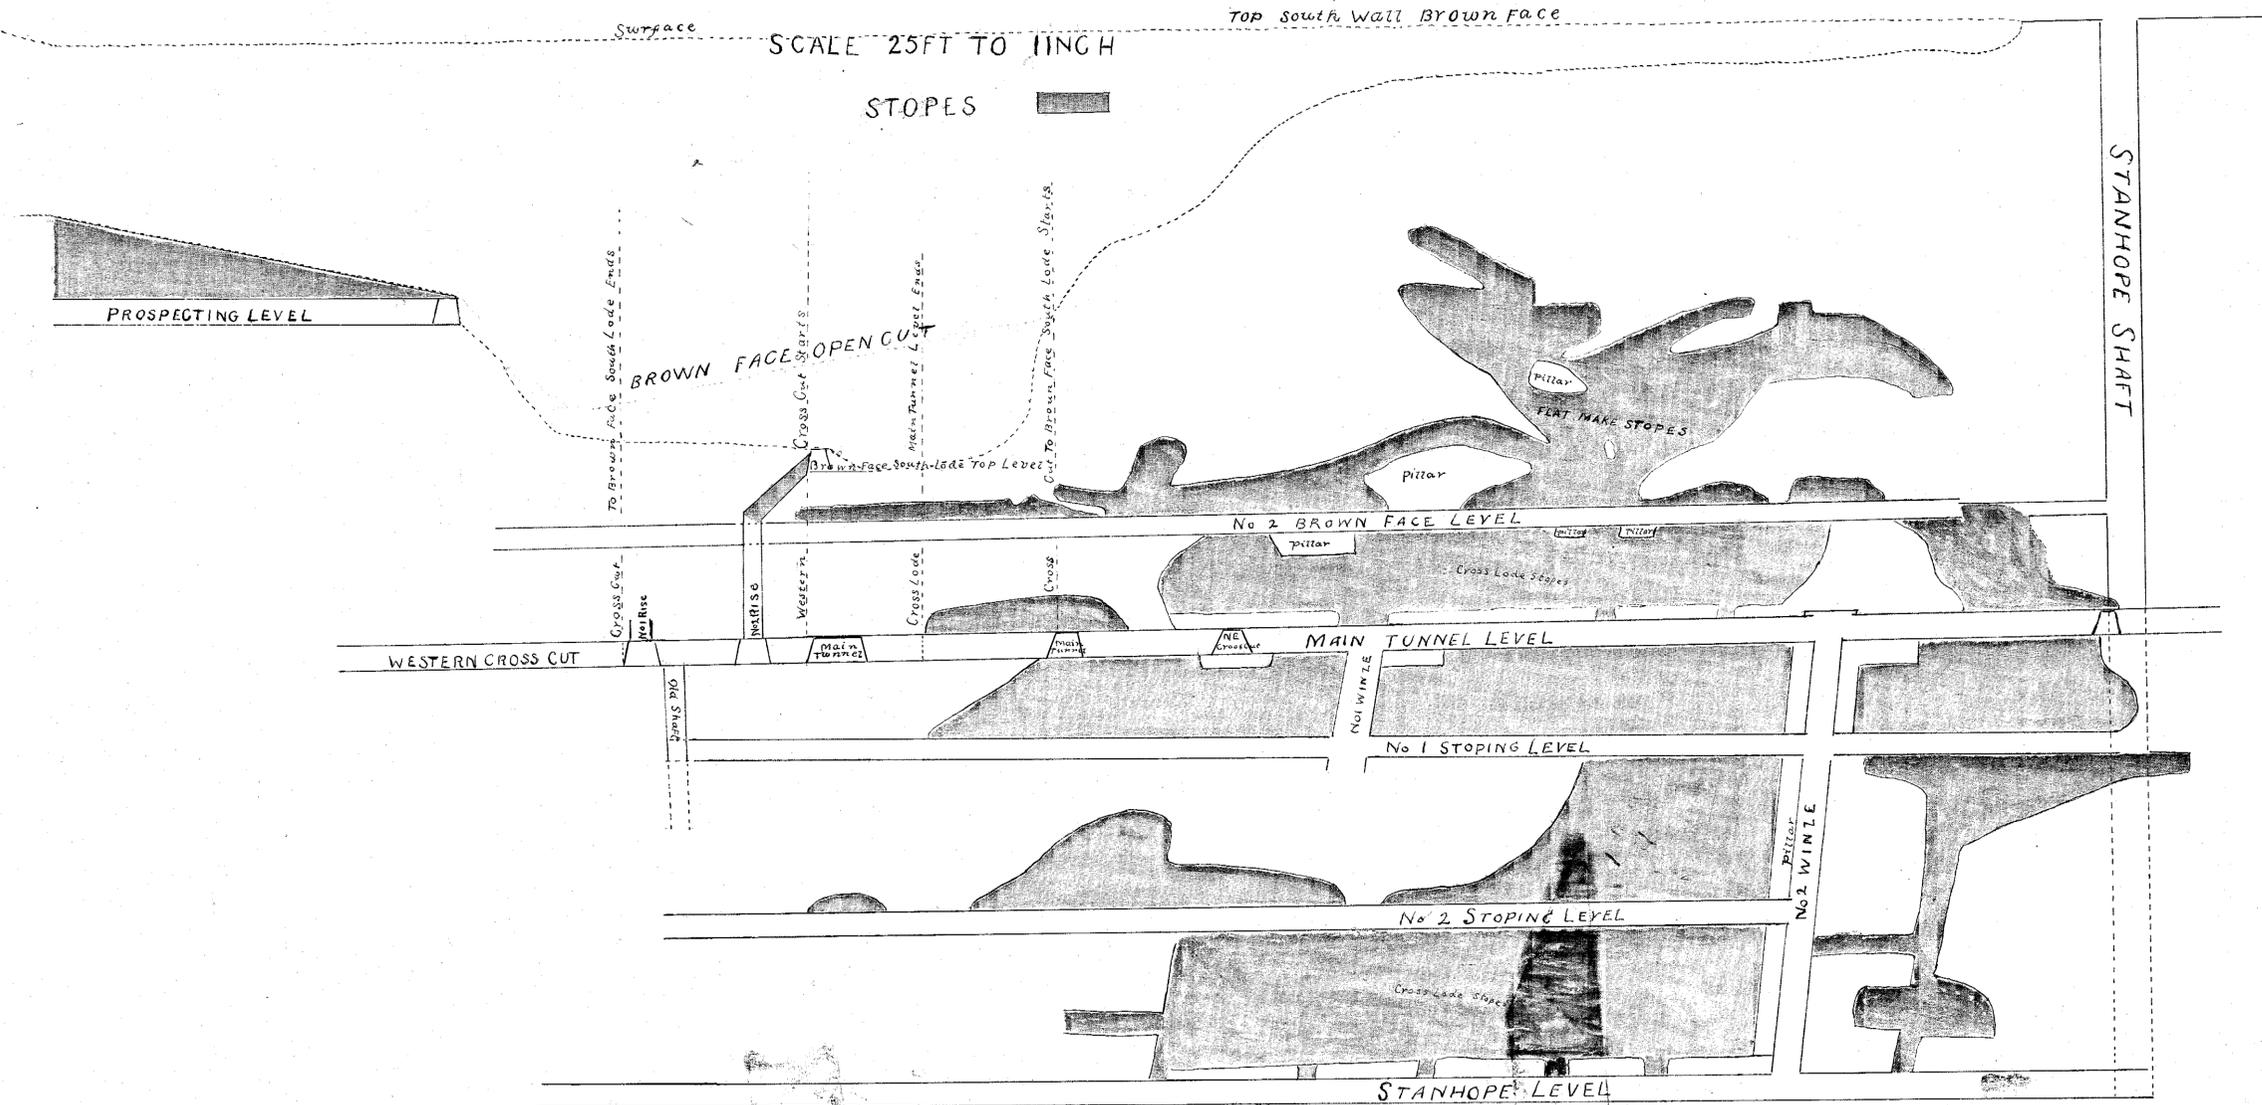

Handwritten note: 20th July

Surveyor W. Pate and J. Thordahl

Handwritten note: 17/1/28