


Mt BISCHOFF T M Co REC

WORKINGS ON GROSS LODE AND FLAT MAKE

AND BROWN FACE SOUTH LODE

TRANSVERSE SECTION

Scale 25ft = 1 Inch

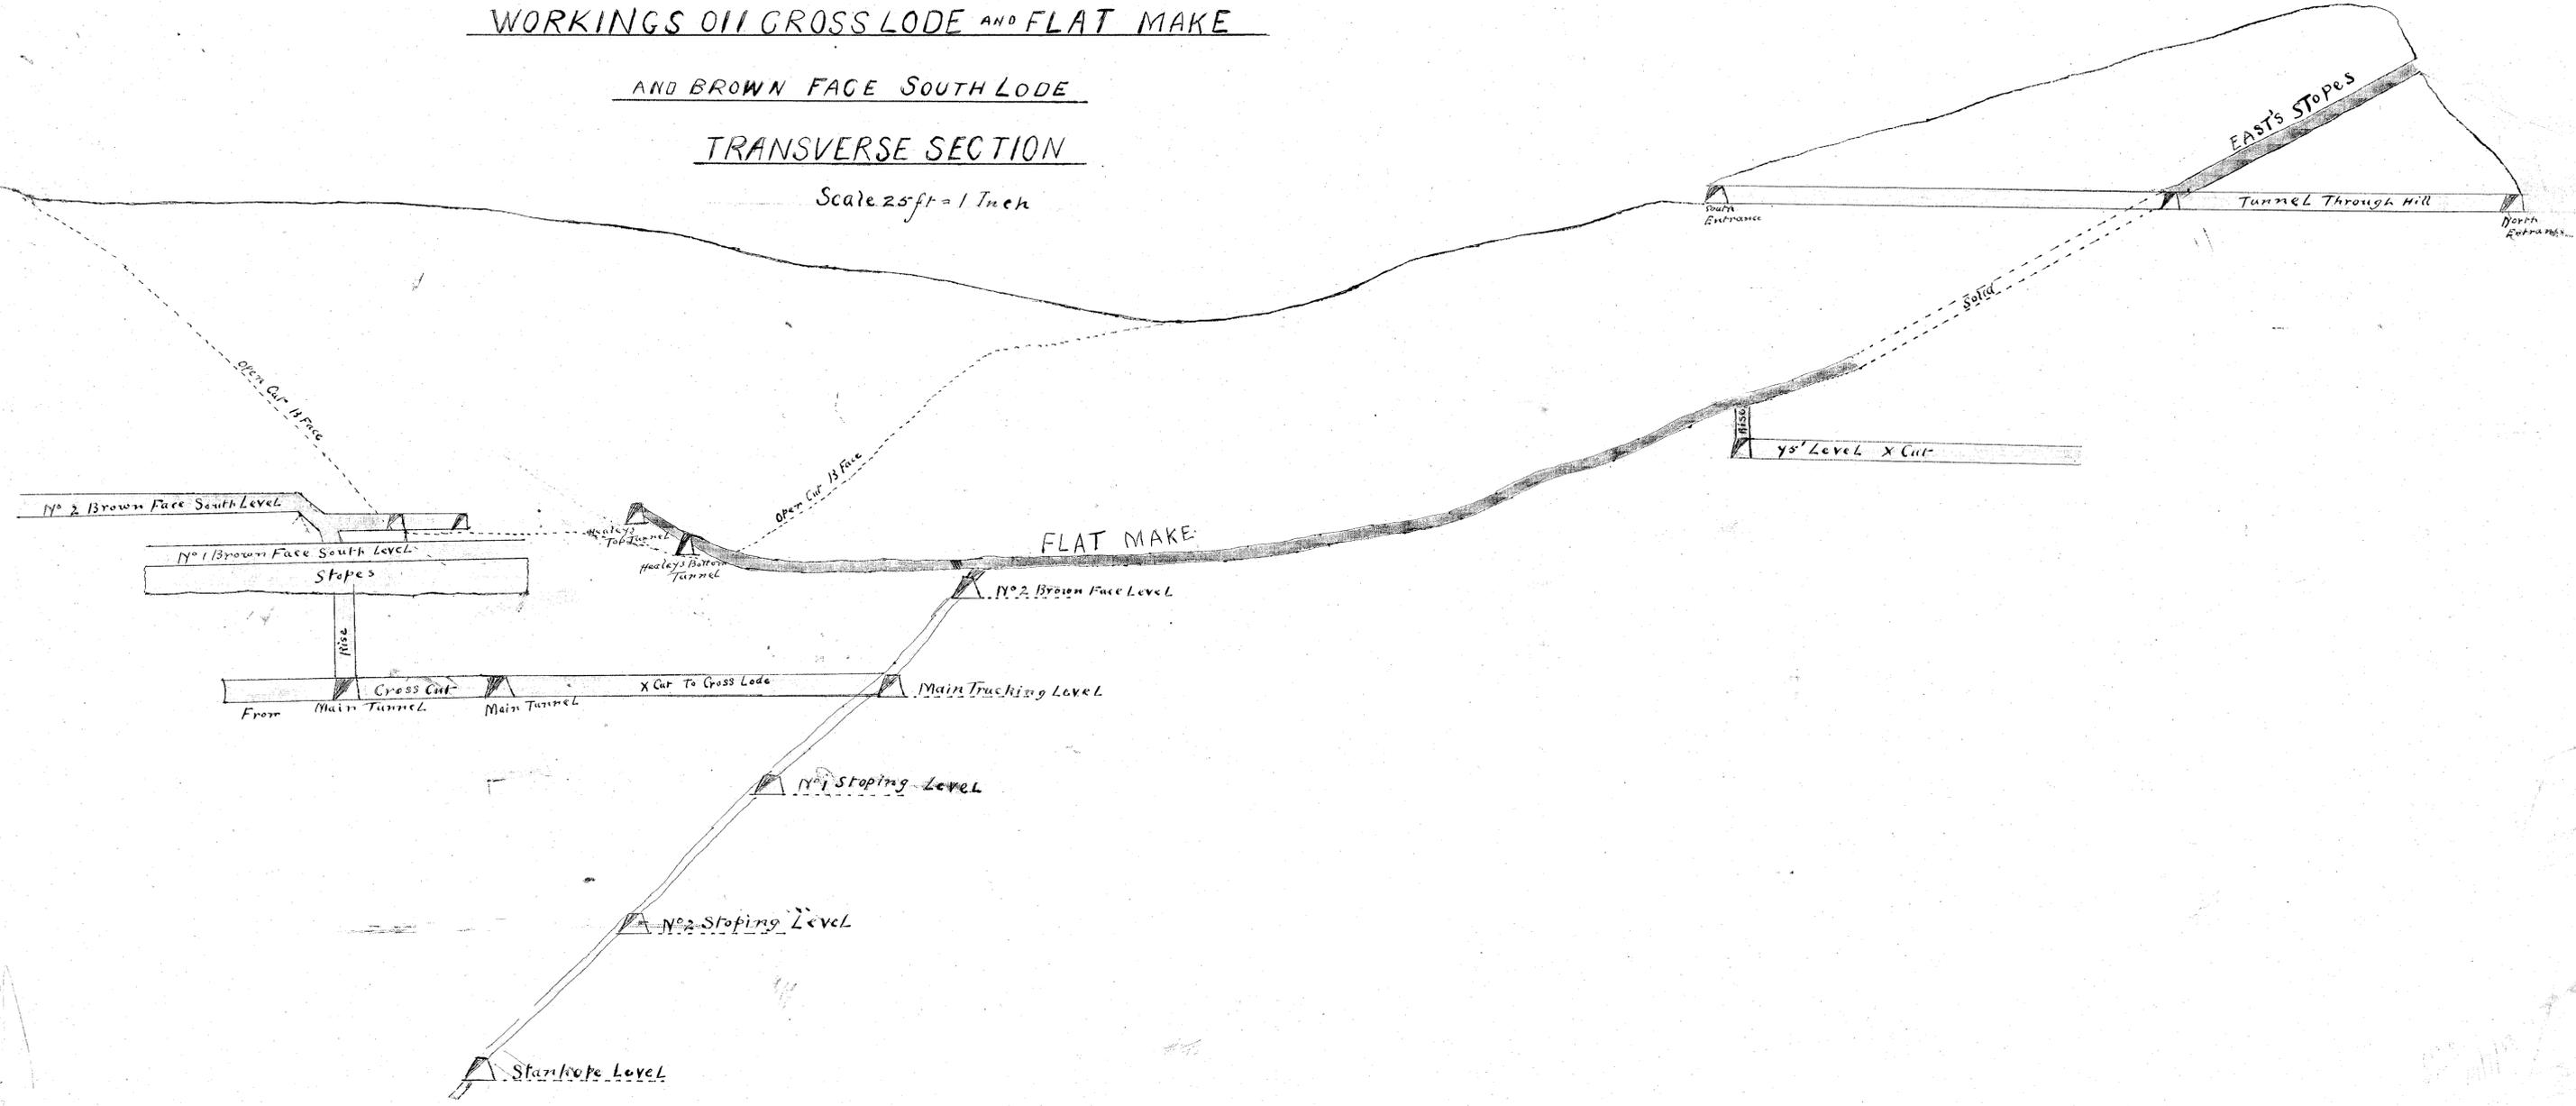

Work 1932
Surveyor W. Porter
10/7/33

but used 4" thread
and compass

217-121