


217-123

217-123

MT. BISCHOFF T.M. CO.

5 cm

SCALE 25 FT. = 1 in.

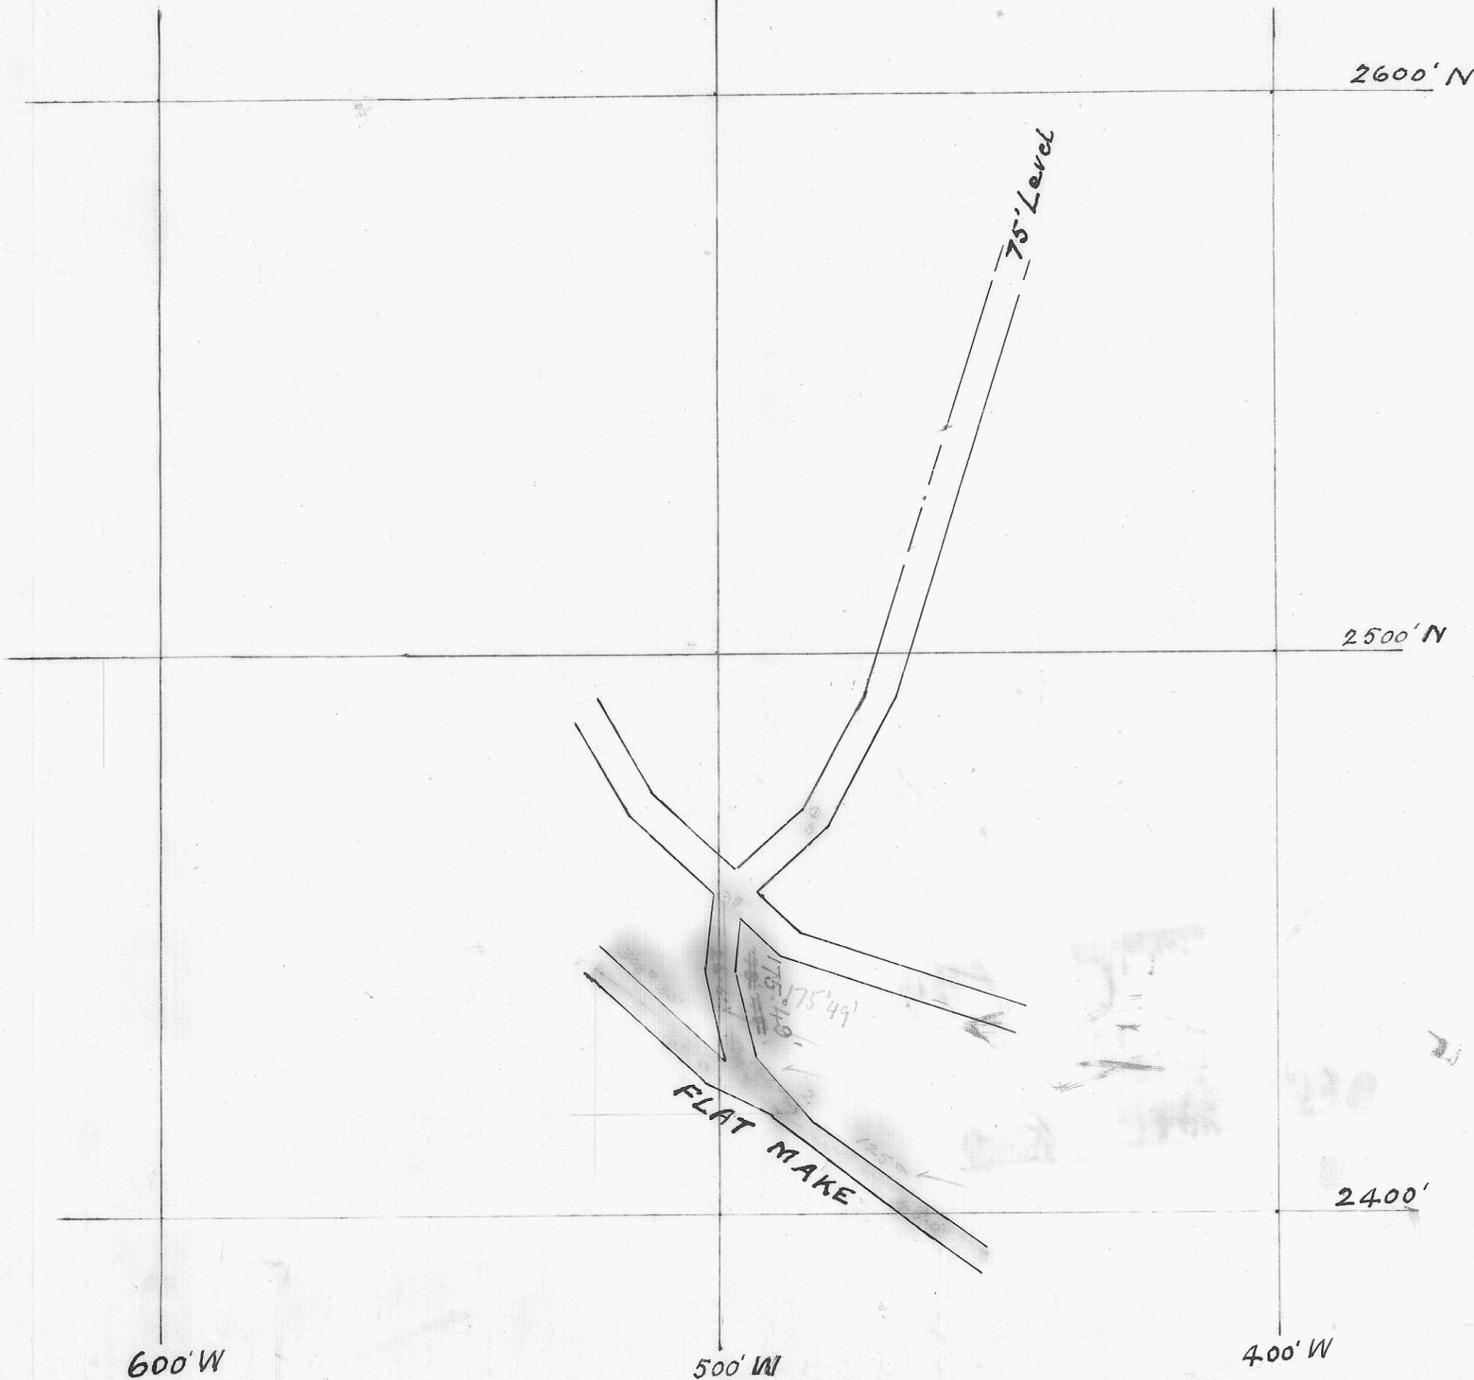

Surveyor - J. H. Levings  
 Int. used to "Bendoline"  
 Dec. 31<sup>st</sup> 1927