

217-125

5 cm

Mt. BISCHOFF T. M. Co. Reg.

WHITE FACE



UNDERGROUND WORKINGS TO DEC. 31 1923.

SCALE 25 FT. TO 1 IN.


*Mt. Bischoff
Cableway Surveyor
25-2-27.*

*No. 4 level
7° 48' 00"
34.02'*

*5° 16' 00"
143.23'*

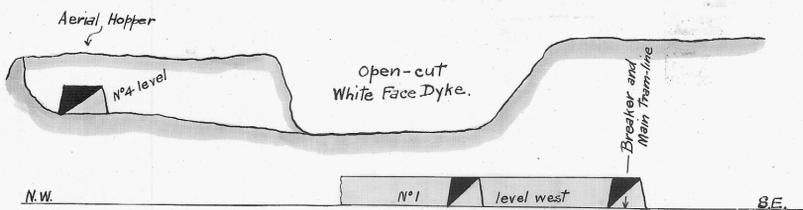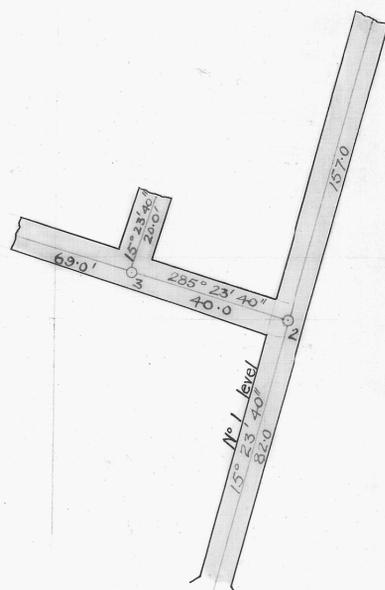

TRANSVERSE SECTION

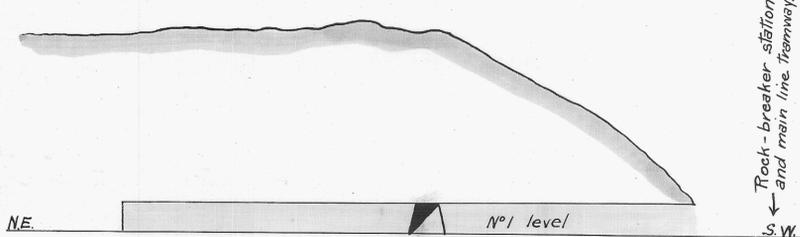

LONGITUDINAL SECTION

*Tock-breaker station
and main line tramway.*

2.93.5'

358° 46' 40"

19° 04' 10"

401.8'

© T.S.O.

600 W.

500

600 N.

400 W.

White Face