


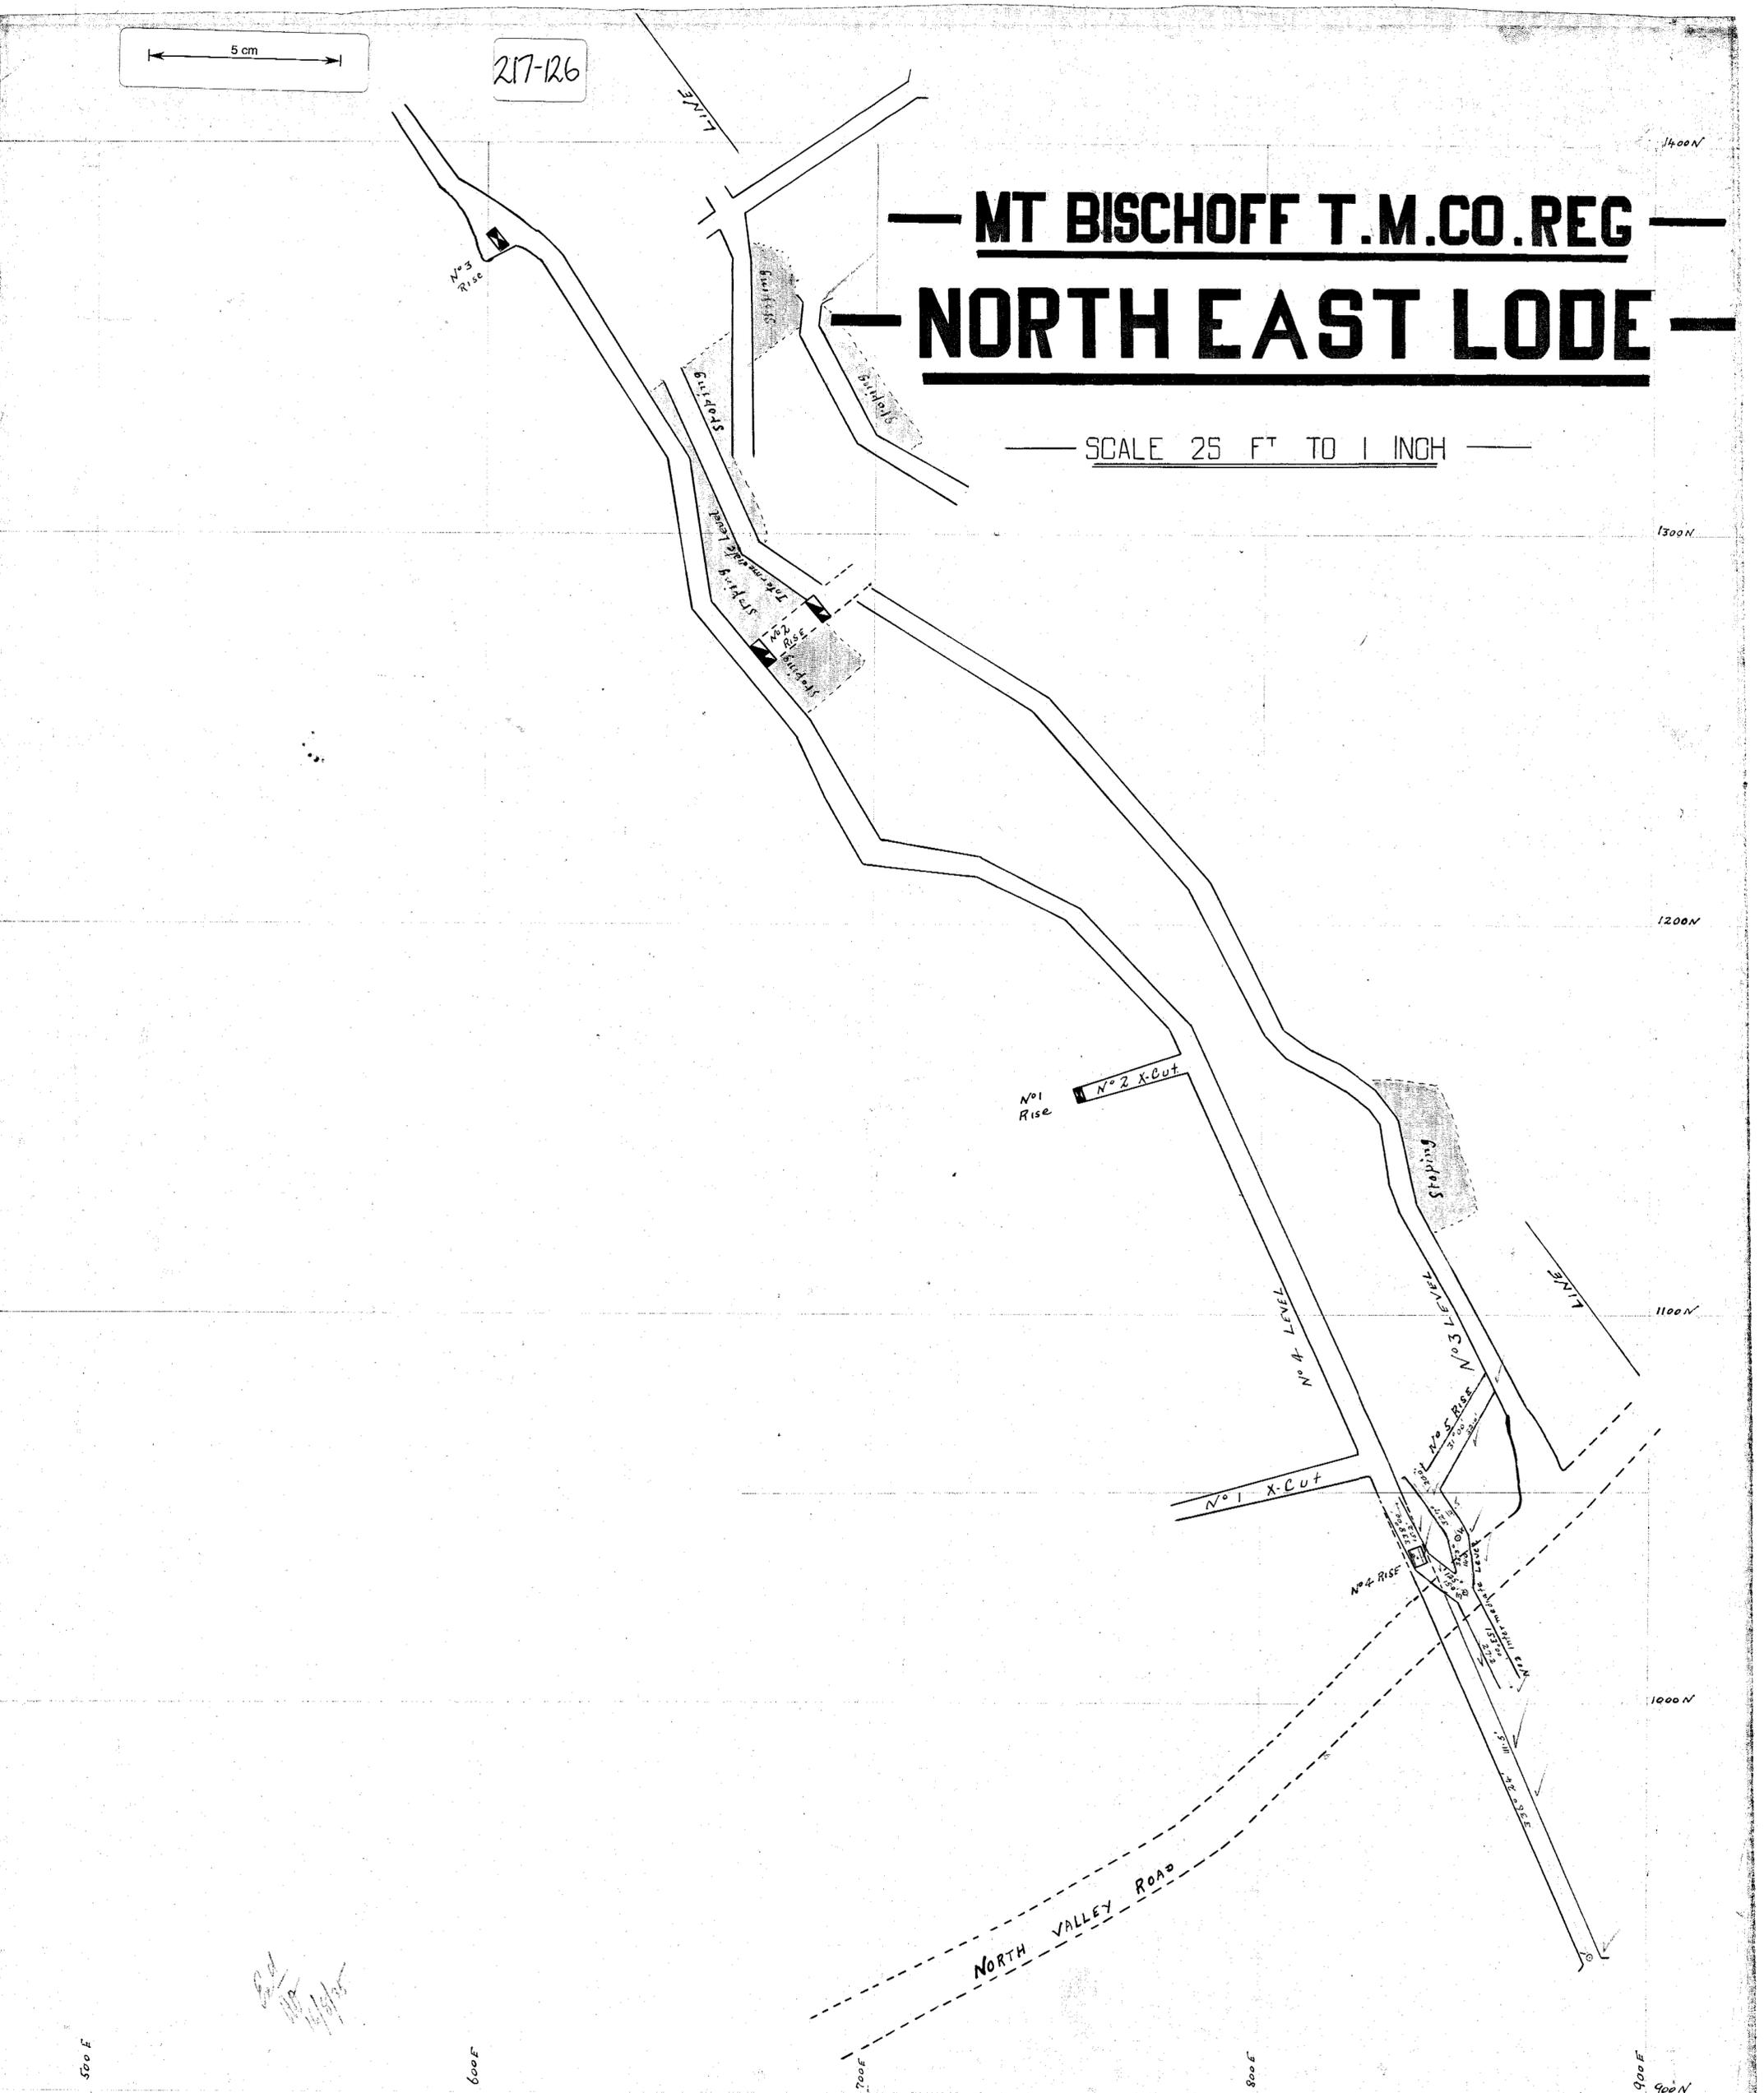

217-126

# — MT BISCHOFF T.M.CO.REG — — NORTH EAST LODE —

— SCALE 25 FT TO 1 INCH —



500 E

600 E

700 E

800 E

900 N

1000 N

1100 N

1200 N

1300 N

1400 N

Work 1934  
Surveyor W.D. [unclear]  
with and 5" theod and compass

*Handwritten notes:*  
S.D.  
11/19/34