



217-130

1000' E
1100' E
1200' E
1300' E
1400' E
1500' E
1600' E
1700' E
1800' E
1900' E


THE M^r BISCHOFF T M COY REG NORTH EAST LODGE-

SCALE 25 FT TO 1 INCH

217-130

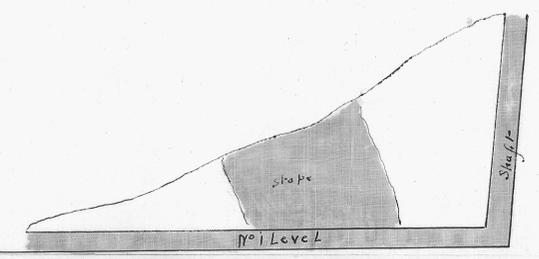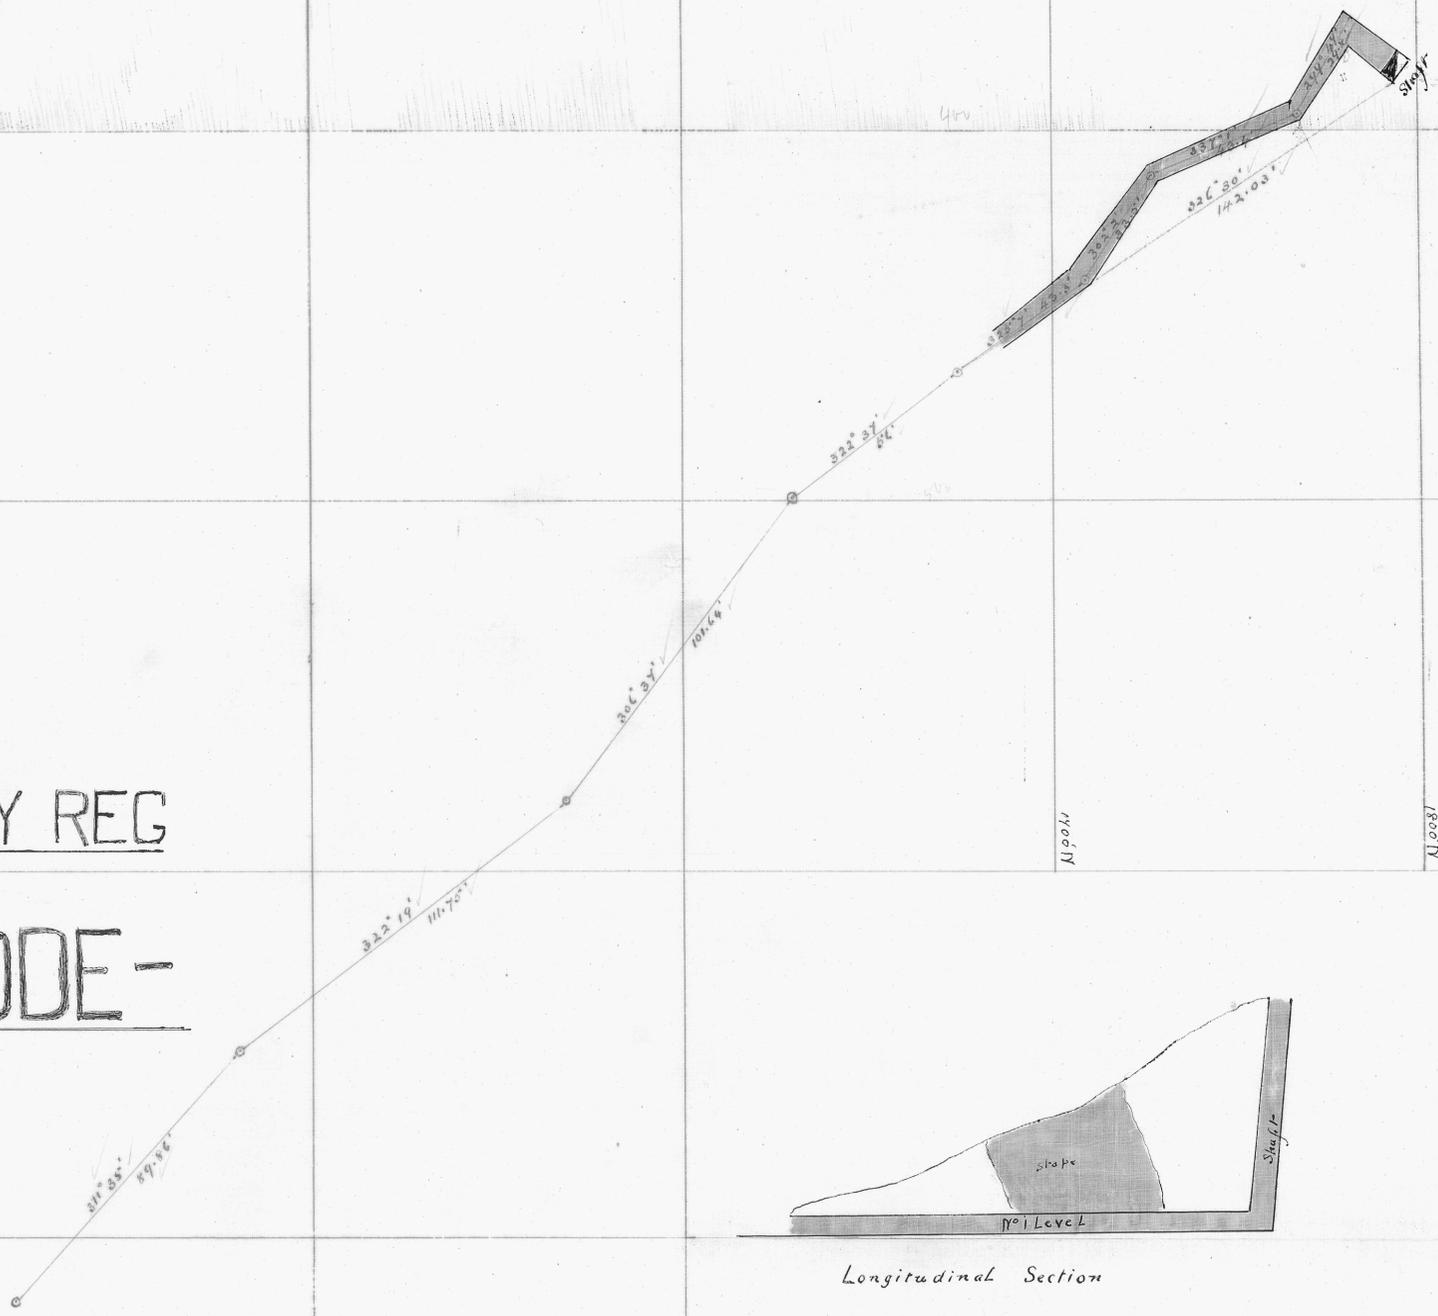

Longitudinal Section

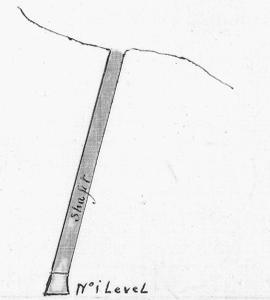

Transverse Section

6 cm