


217-131

500 E
600 E
700 E
800 E
900 E
1000 E
1100 N
1200 N
1300 N
1400 N
1500 N

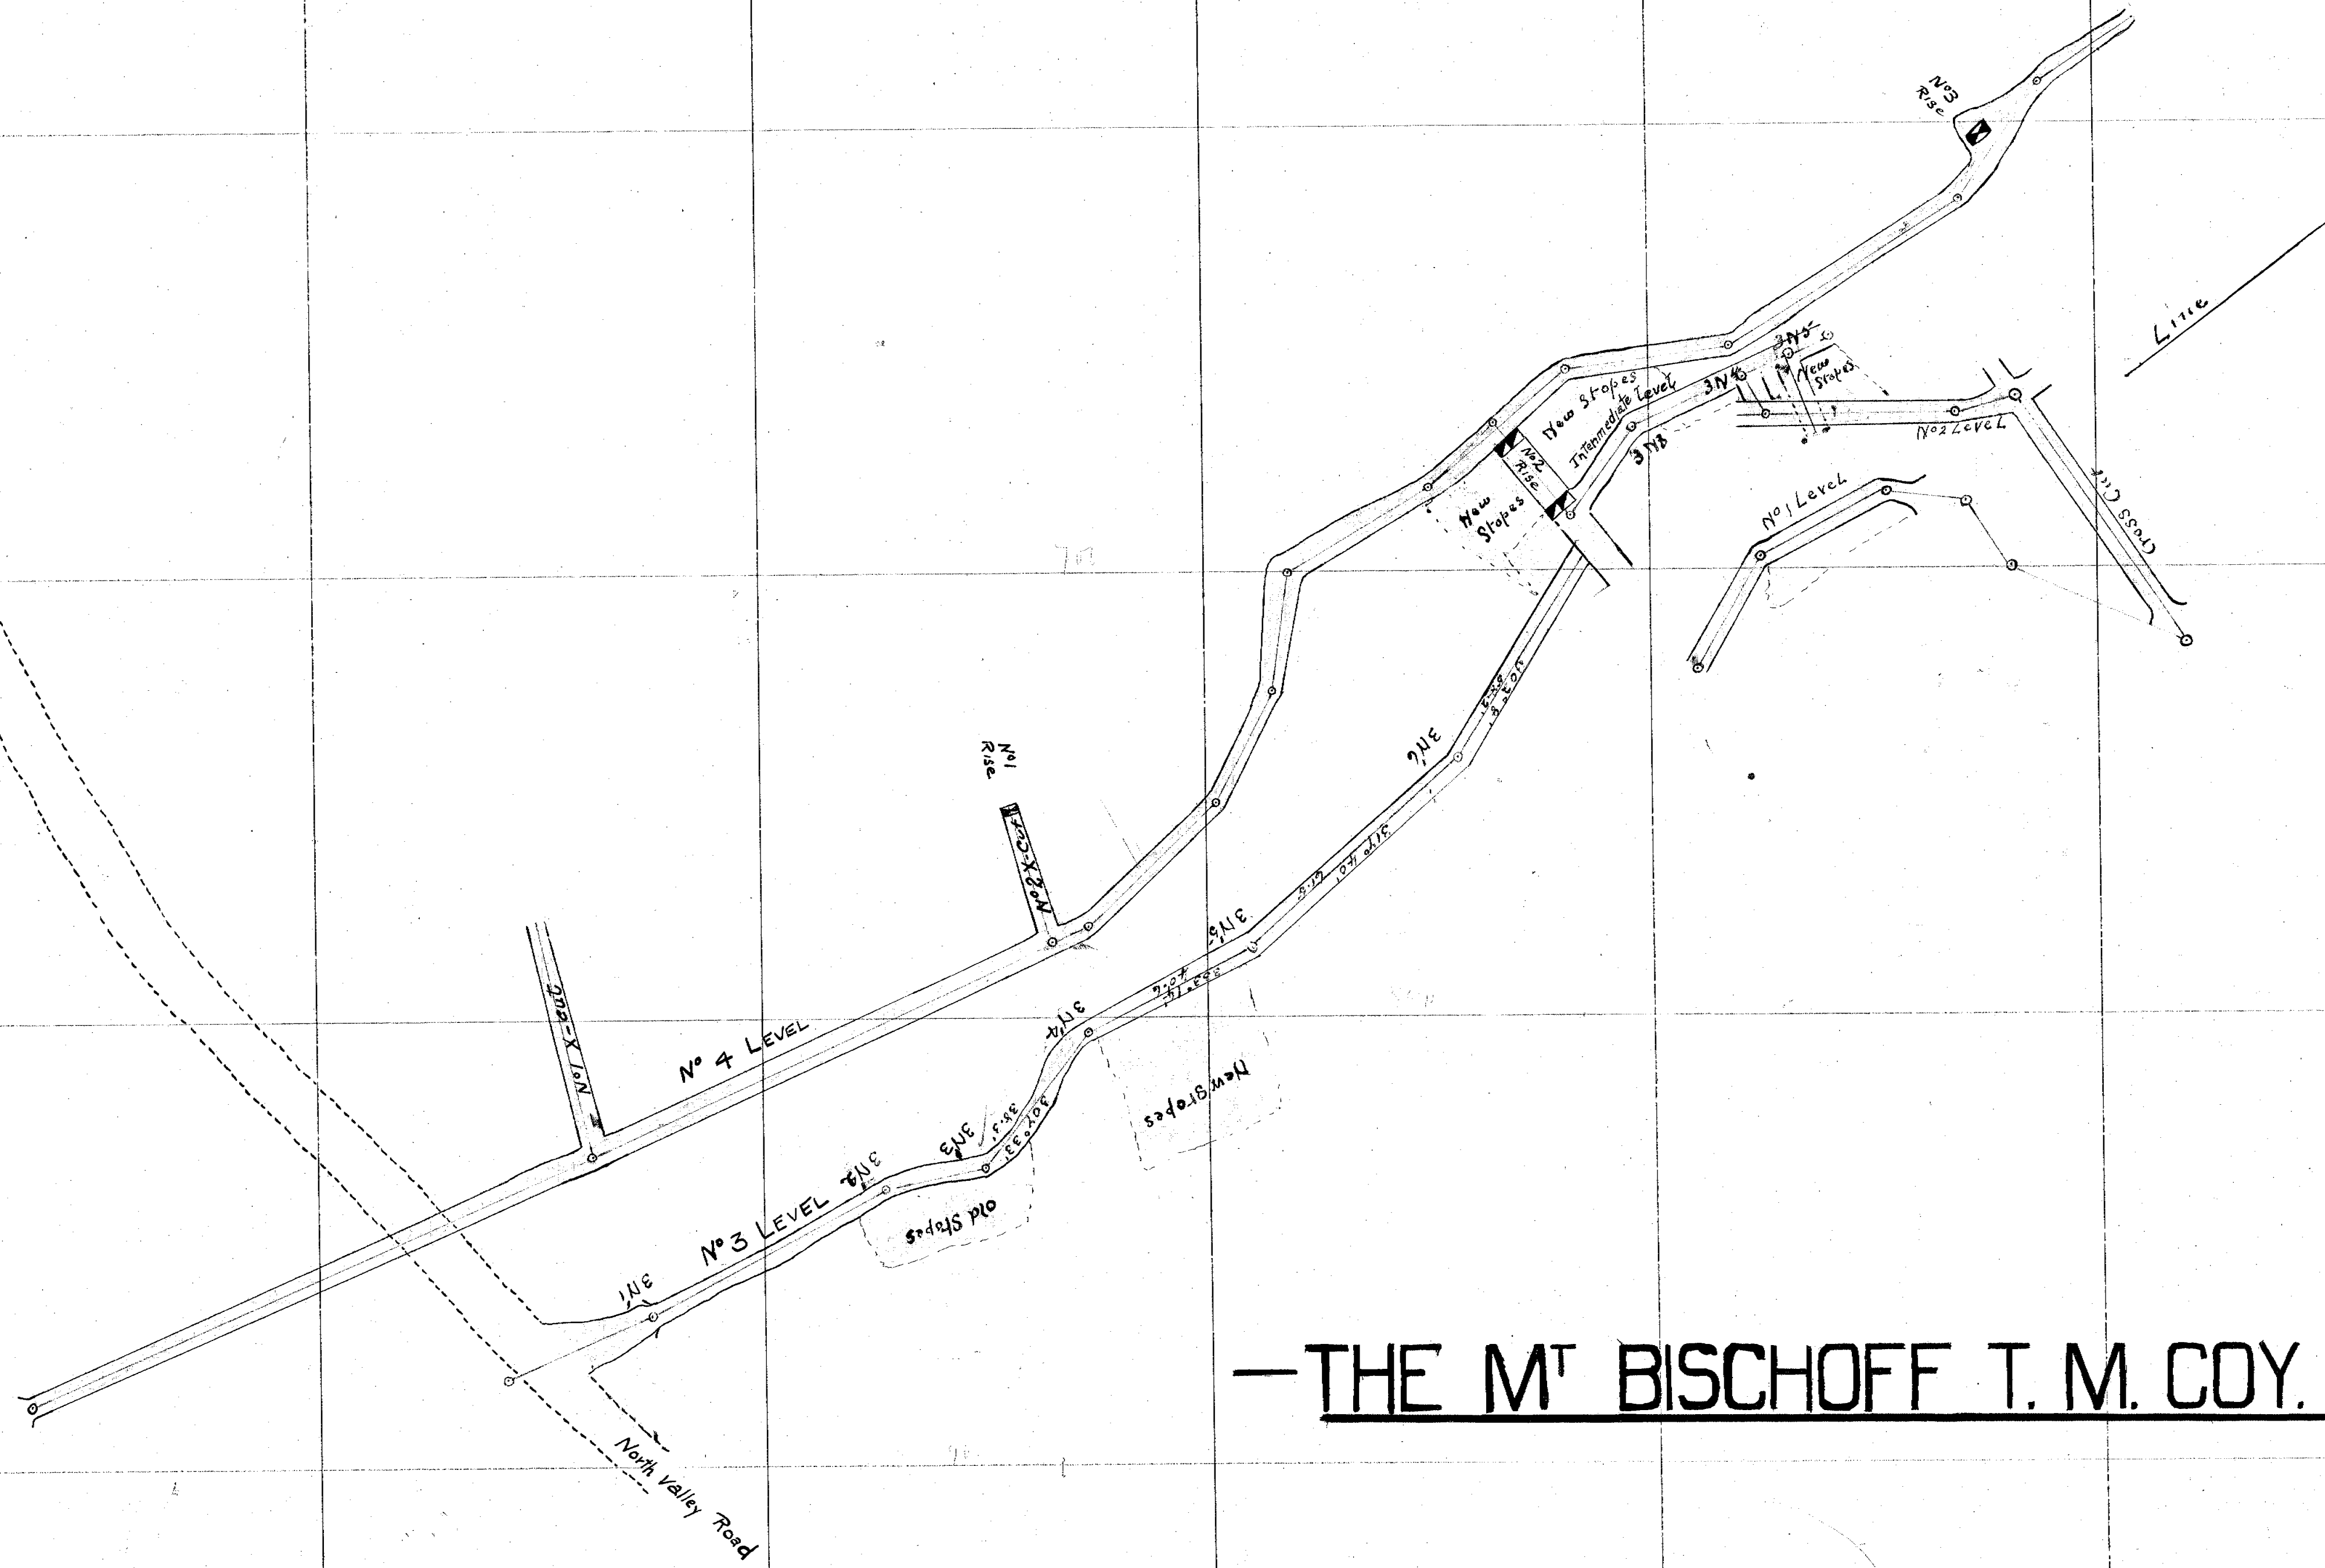

— THE MT BISCHOFF T. M. COY. REG. —

— NO 1 NORTH EAST LODGE —

— SCALE: 25 FT TO 1 INCH —

5 cm

217-131

Work 1933
Surveyor W. H. Post
Instrument used 5" theodolite

Ed
2/1/34