

217-132

MT BISCHOFF T.M.CO.REG.



NORTHEAST LODGE

LONGITUDINAL SECTION

— SCALE 25 FT TO 1 INCH —

5 cm

217-132

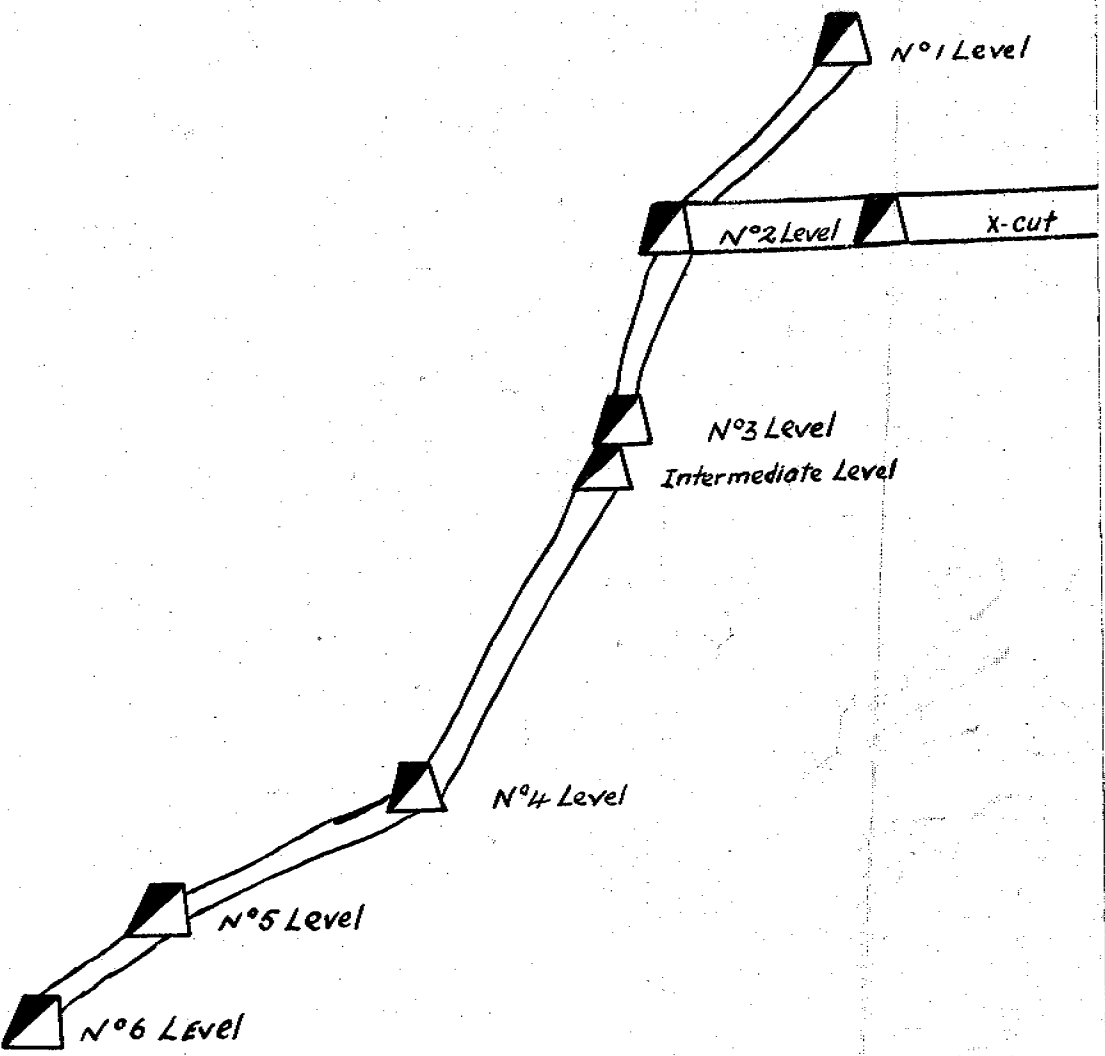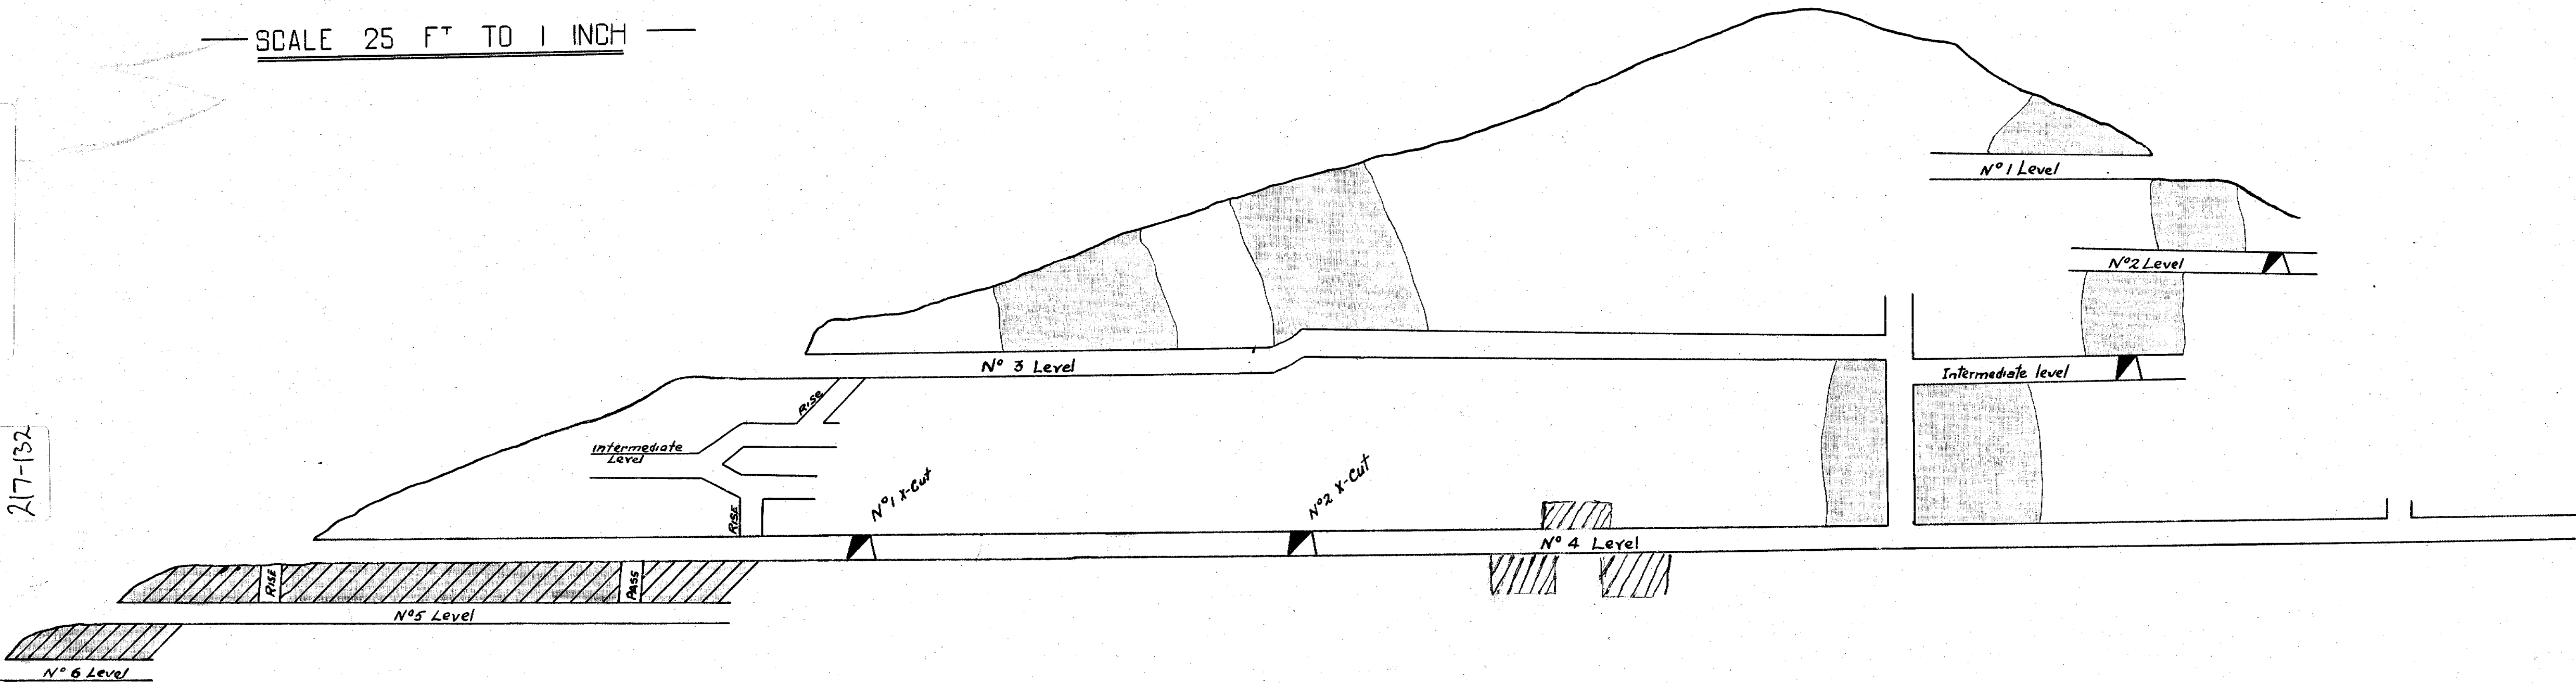

TRANSVERSE SECTION

WORK 1939
SURVEYOR A. J. PORT
INSTRUMENT USED
5" THEODOLITE

WORK 1940
SURVEYOR W. H. DOUGLAS
INSTRUMENT AND 5" THEODOLITE
WORK 1940 SHOWN