
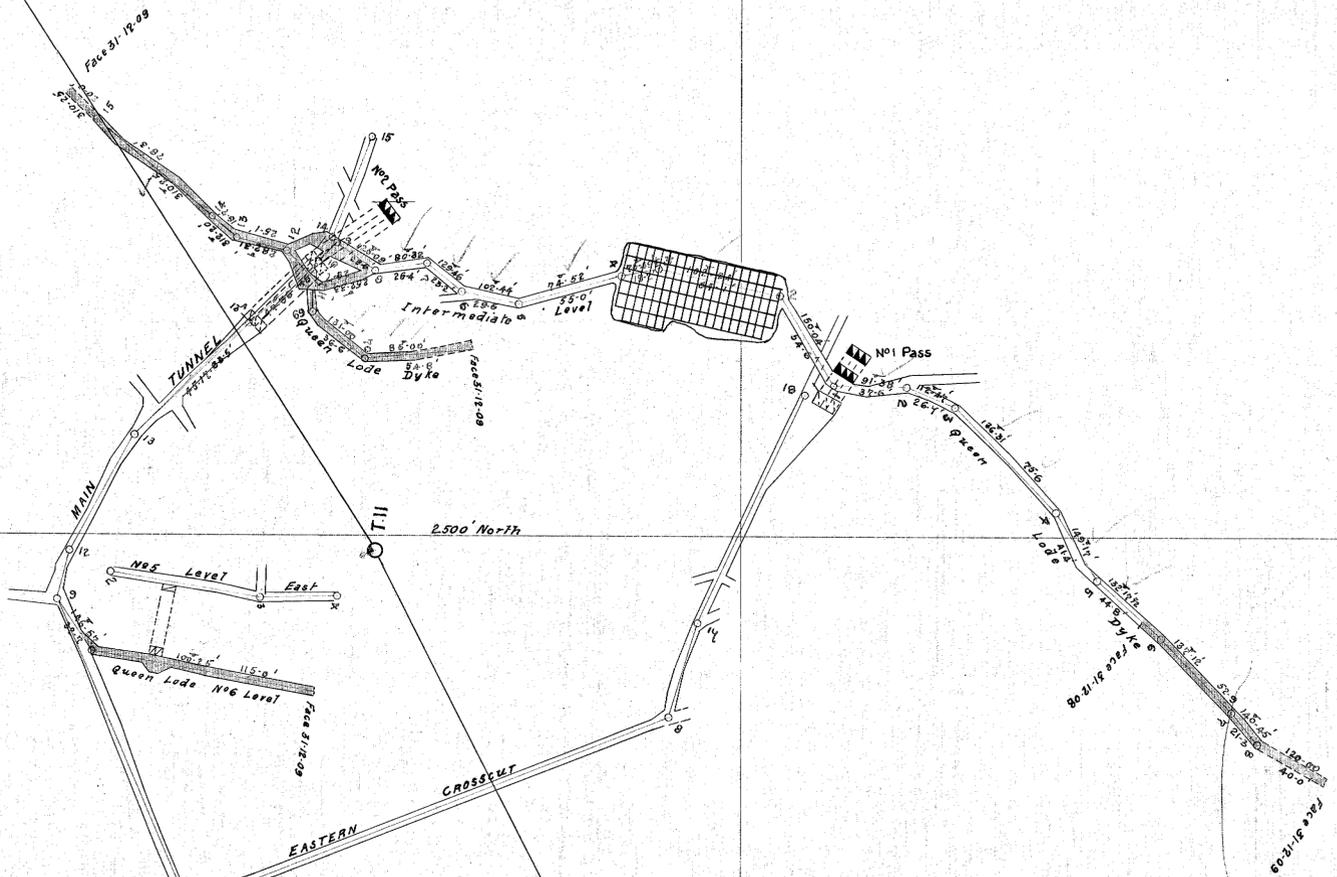


Sheet 2.

217-133



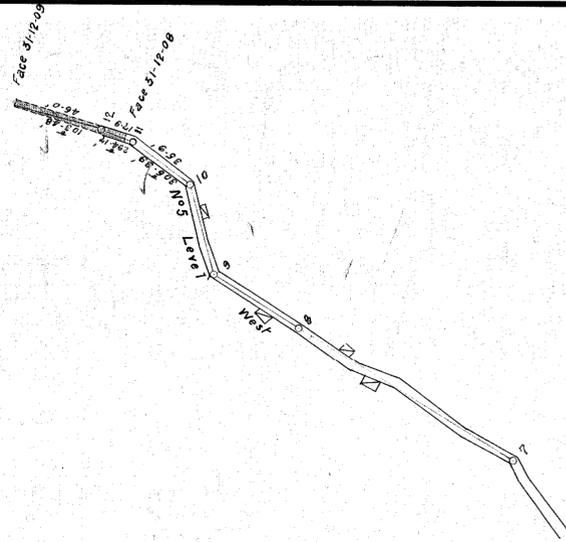


M^r BISCHOFF TIN MINING C^o REG
PLAN OF UNDERGROUND WORKINGS FOR YEAR 1909

Scale 50 FT = 1 Inch

J. D. Hillen
1909

R. L. Hales
 Mine Surveyor
 23-2-10

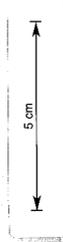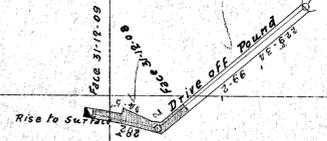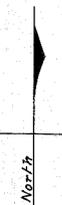

217133

