


217-135

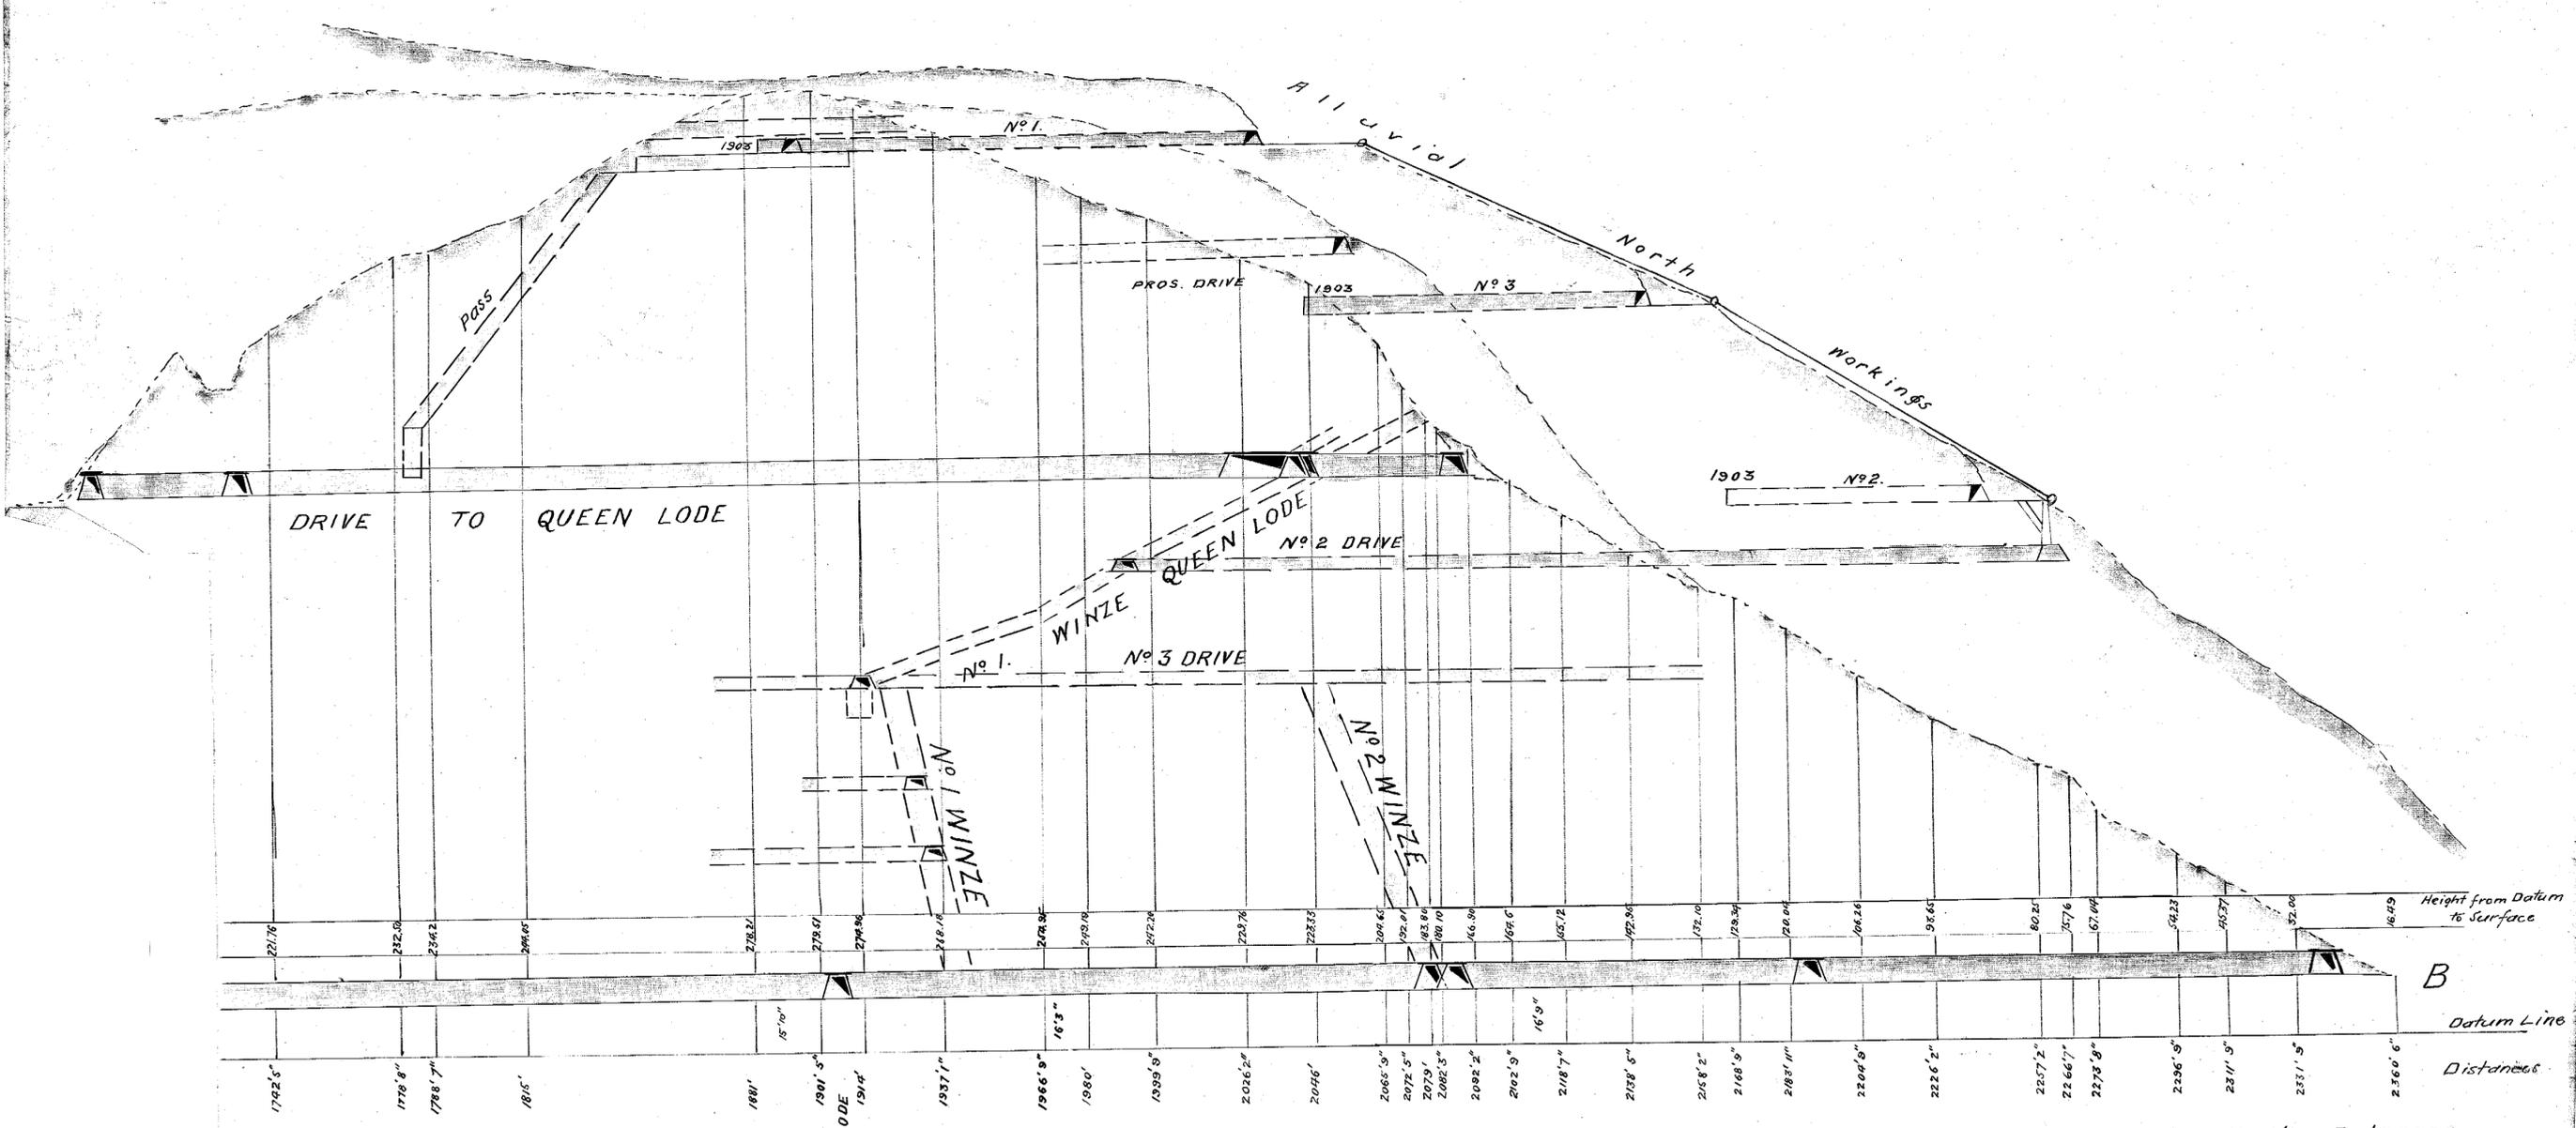

L. SECTION
 MT. BISCHOFF T. M. COMPANY
 UNDERGROUND WORKINGS
 Scale 30ft. to an Inch

I, David Jones, of Waratah, hereby
 declare this plan to be sufficiently
 correct for the purposes of the
 Mines Act of 1900.

David Jones
 District Surveyor,
 Waratah, Tas.



28: 1: 1903.

122

122