



Michael Bischoff
1881. 1/4 scale

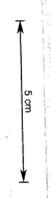


217/136

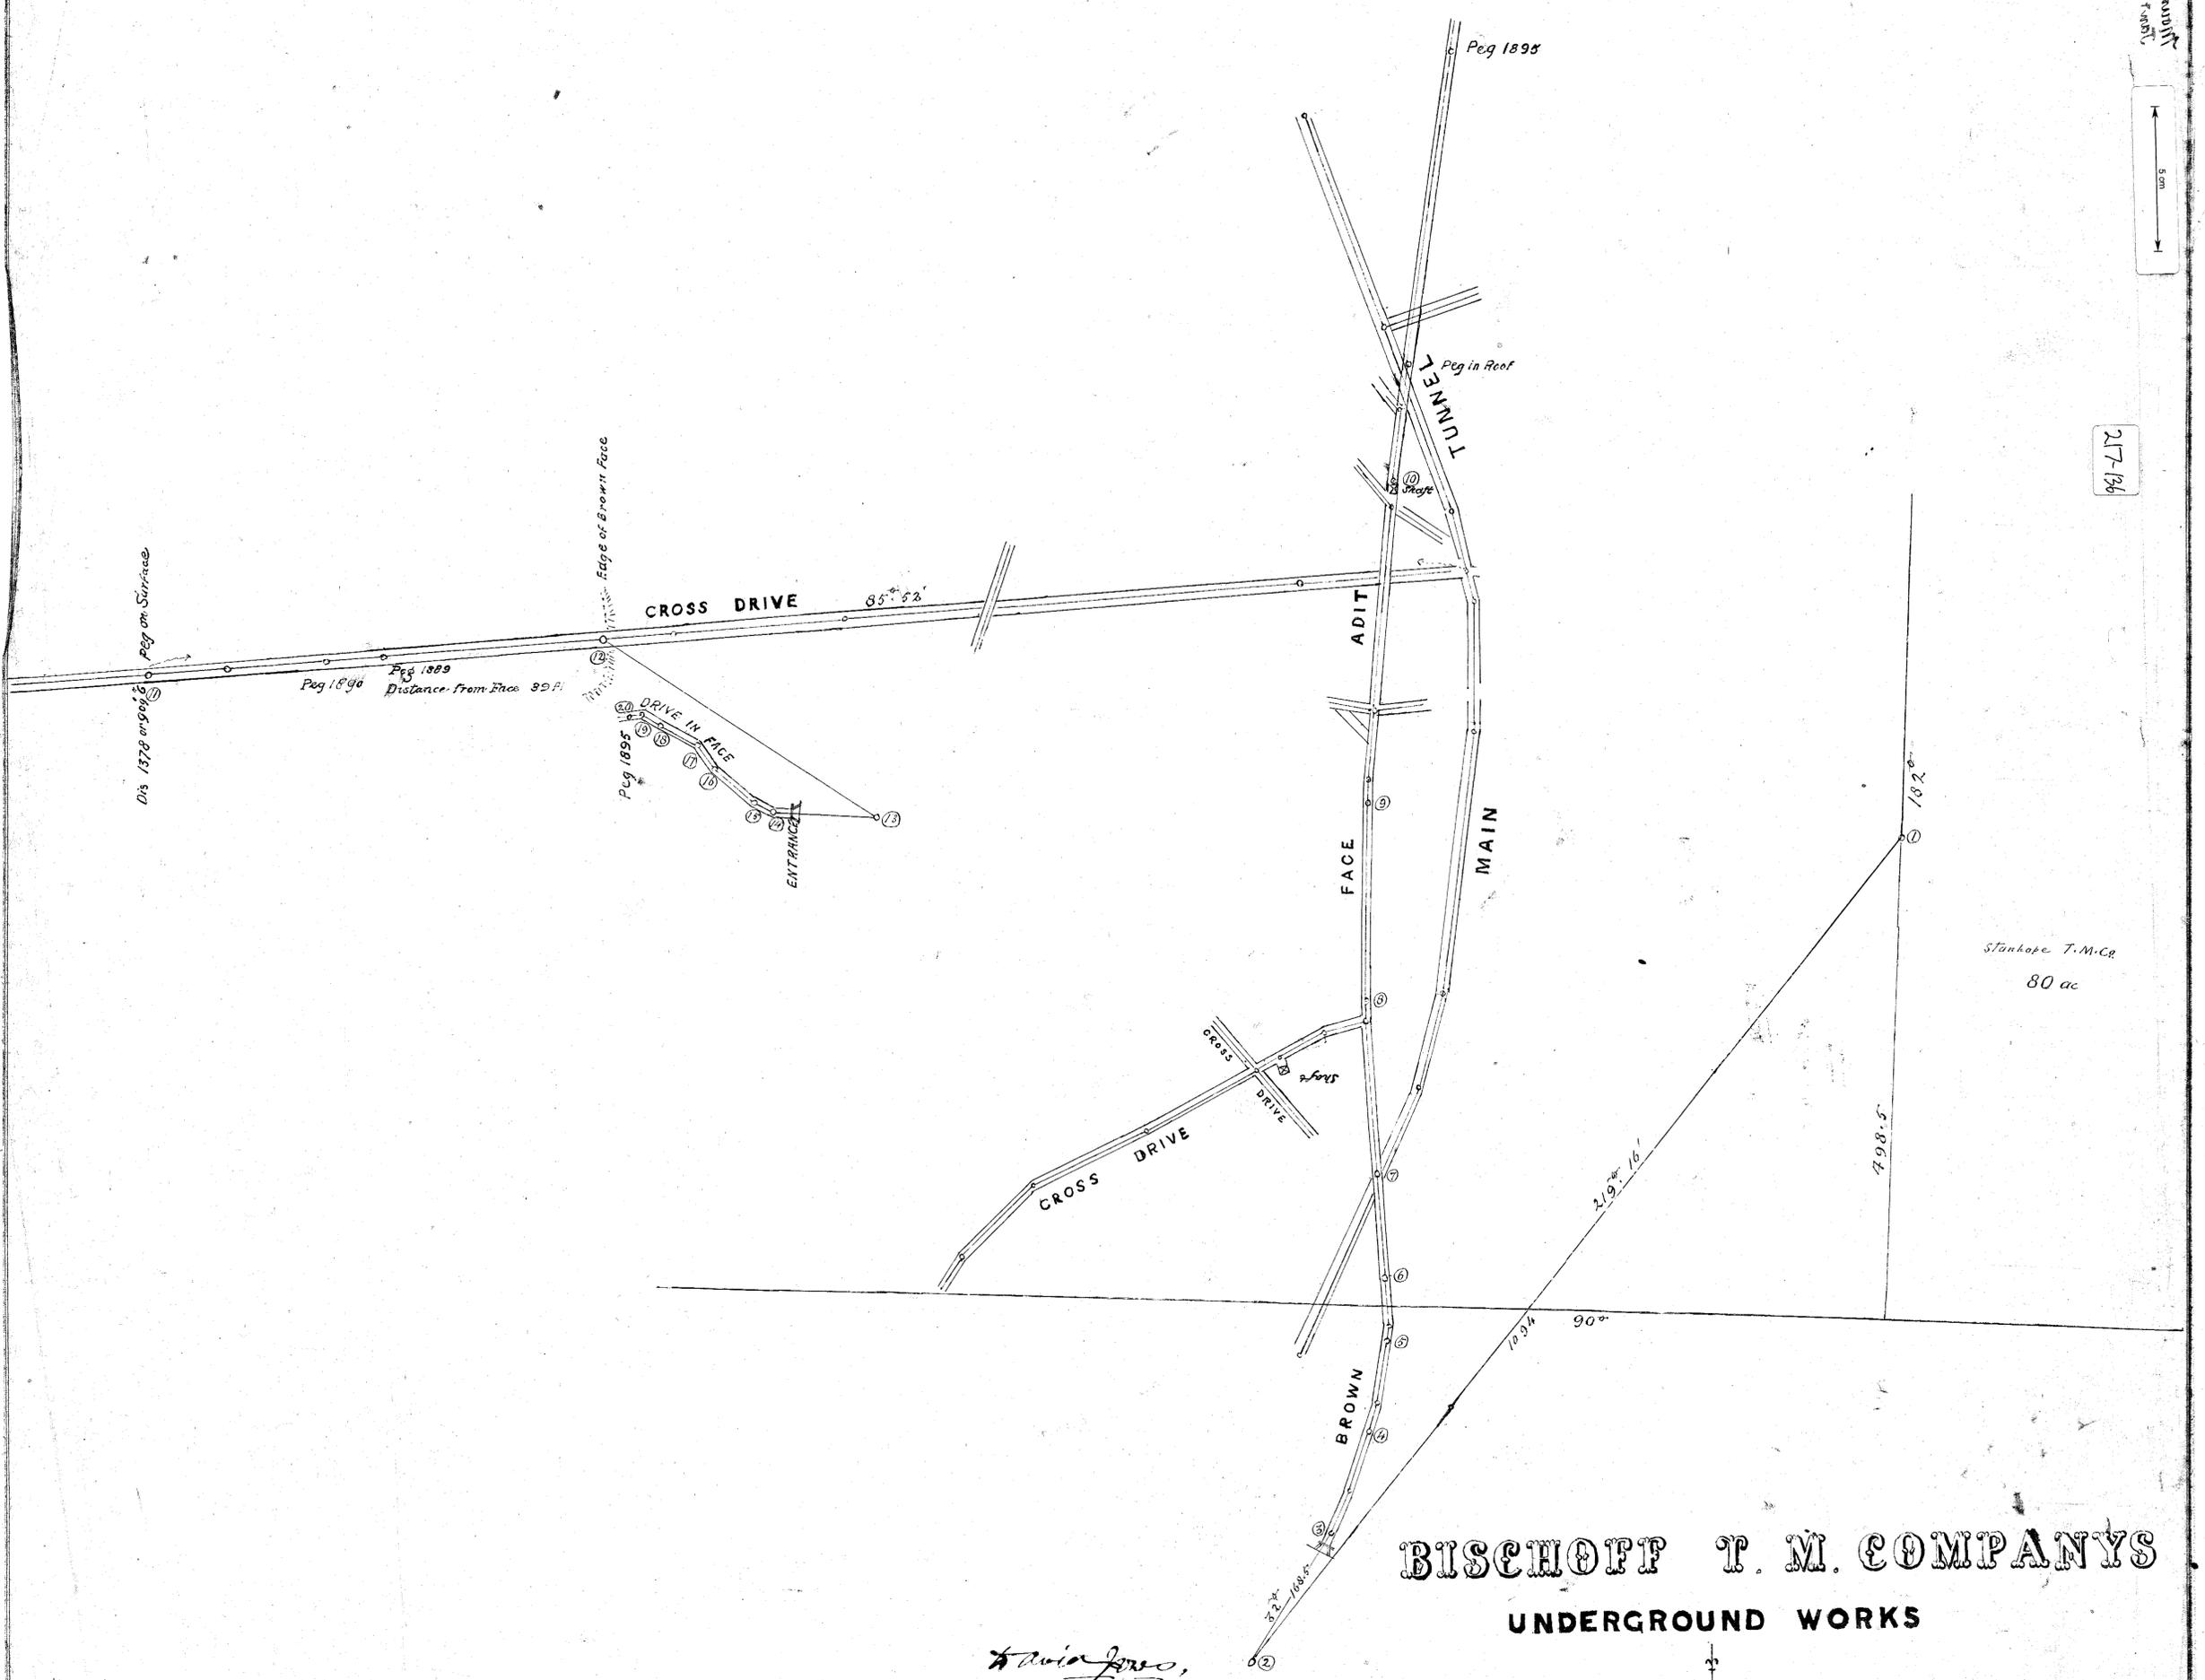

David Jones
 District Surveyor
 Waratah Jan. 30th 1895.

BISCHOFF T. M. COMPANYS
UNDERGROUND WORKS

Scale 50 Feet to one Inch

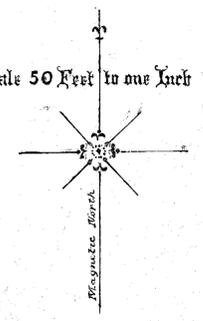

217/136

122