

— THE MT. BISCHOFF T. M. CO. REG. —

— GENERAL PLAN —


— SCALE 100 FT TO 1 INCH —



200' N12

200' N12

GIBLIN LODE

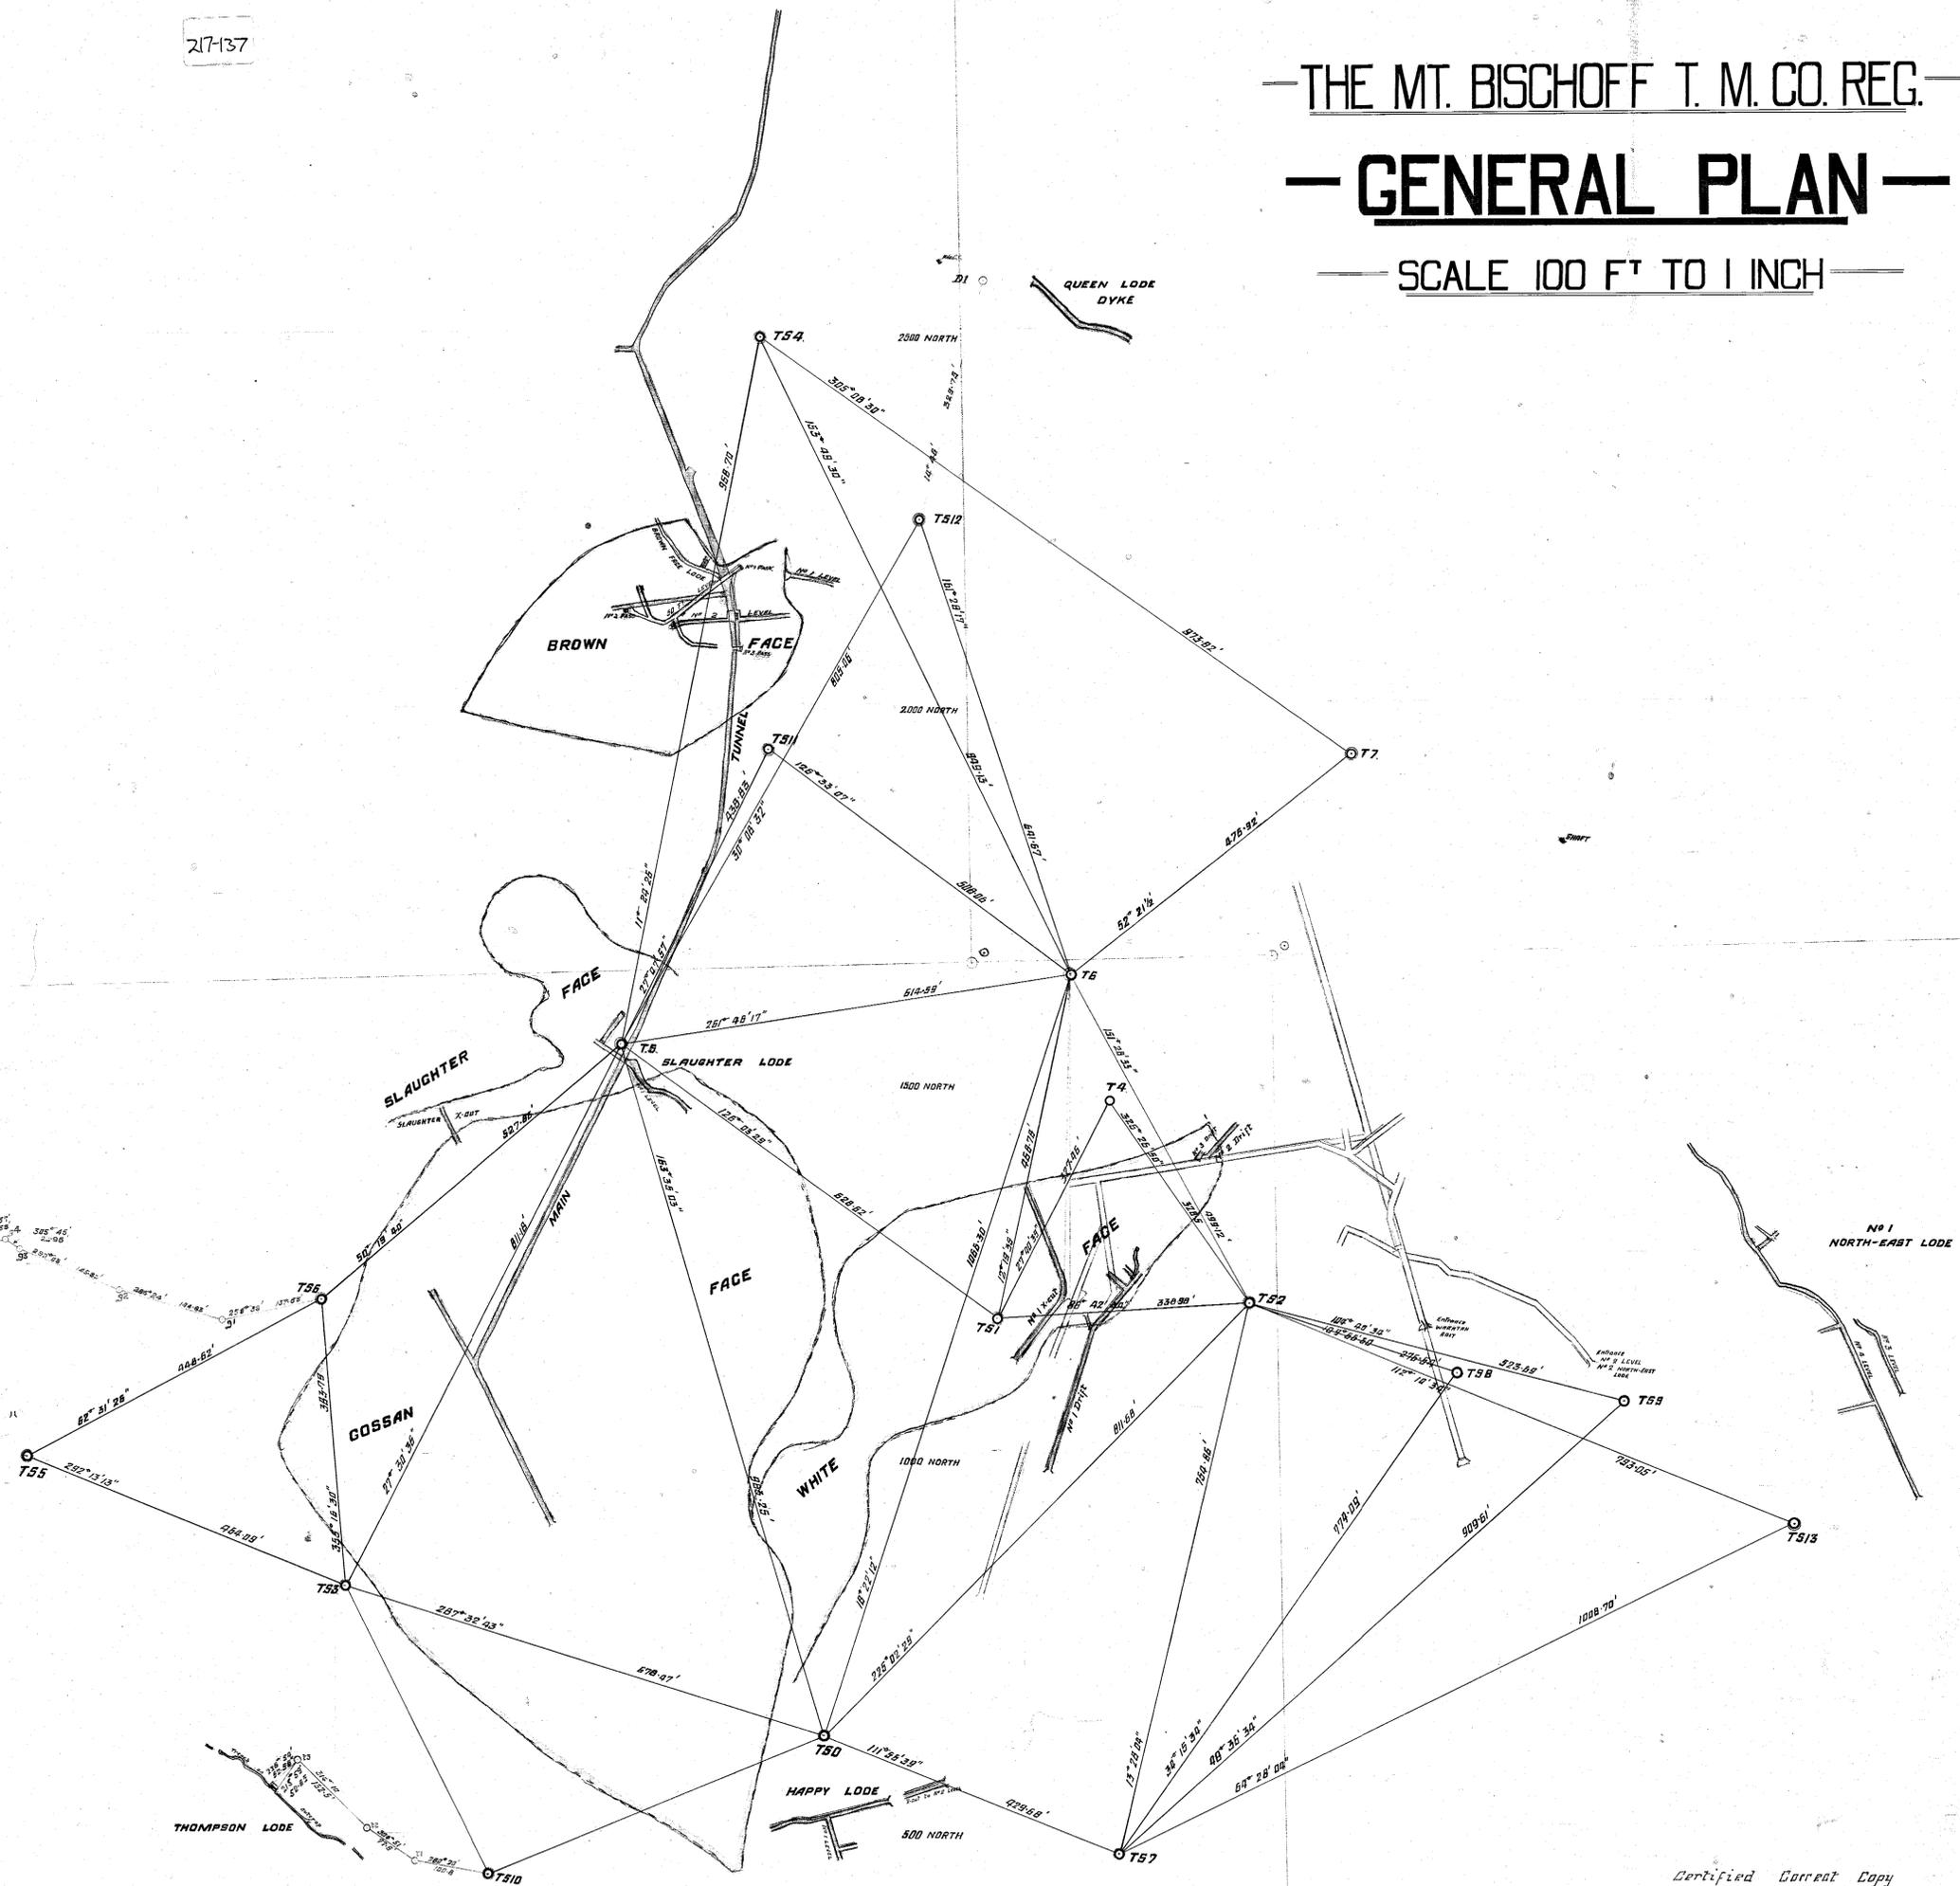

Certified Correct Copy
 Homeville
 Mine Surveyor
 E. W. Haggard General Mine Manager

2000 WEST

1500 WEST

1000 WEST

500 WEST
DATUM

DATUM

500 EAST

1000 EAST