
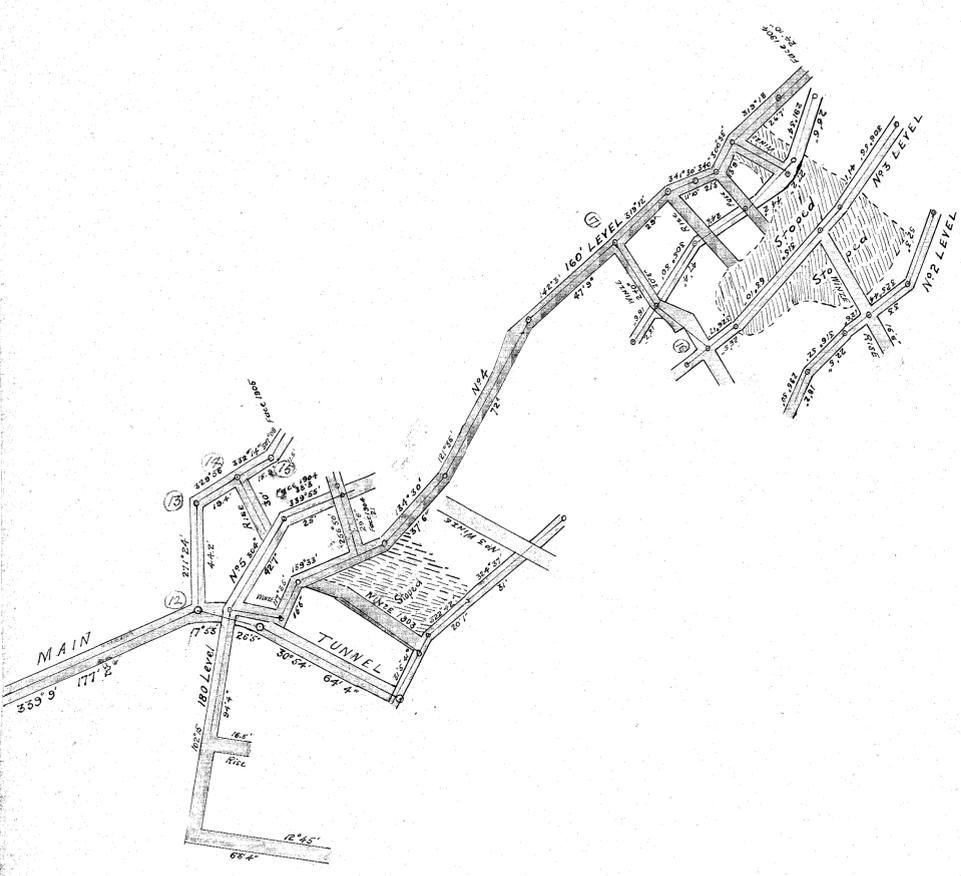


109

Mount Bischoff
1st 1902

Plan
of
Mount Bischoff T.M. Co. Reg.
Scale 30 feet to 1 inch.

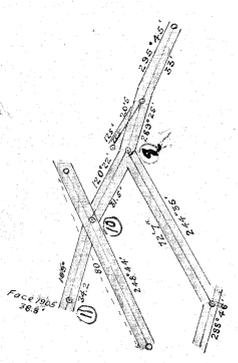

5° 18'

I, David Jones, of Waratah, hereby
declare this plan to be sufficiently
correct for the purposes of the
Mines Act of 1900


David Jones

District Surveyor,
Waratah, Tas.
30. 1. 1905



Old Stanhope Boundary
1° 32'

27-138

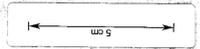

27-138