



THE WEST BISCHOFF T. M. CO'S. UNDERGROUND WORKS.

Scale 50 feet to one Inch

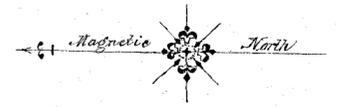


1893

217-139

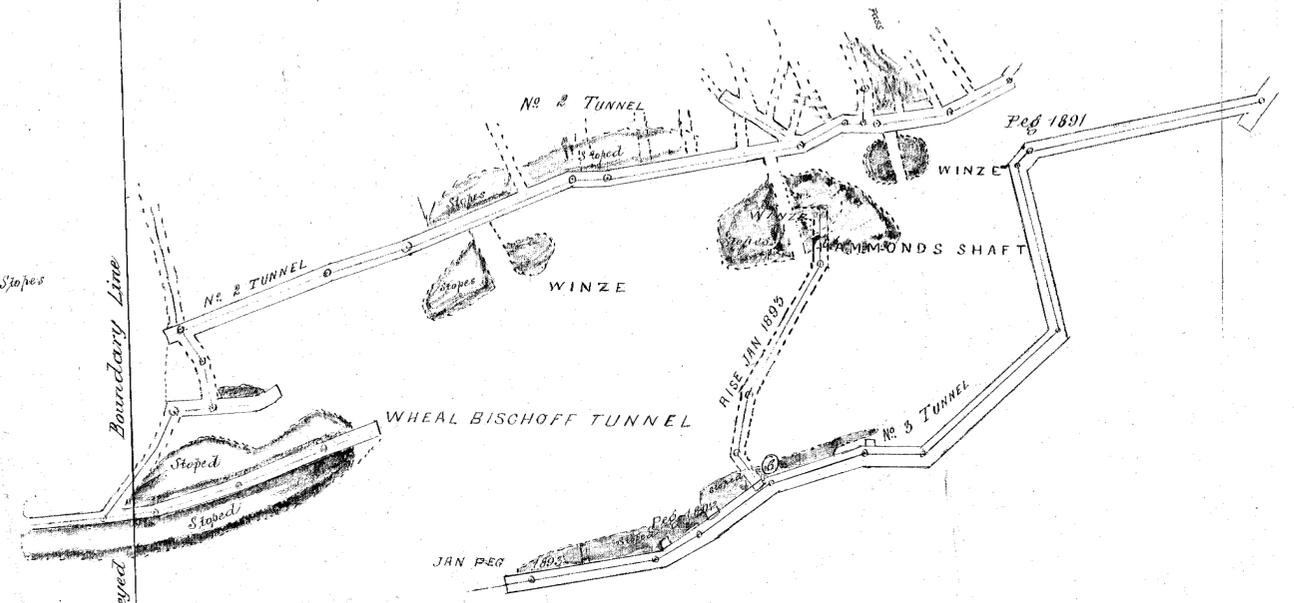

Ground Plan

L. A. Jones
District Surveyor,
Manitoba, February 9th 1893.

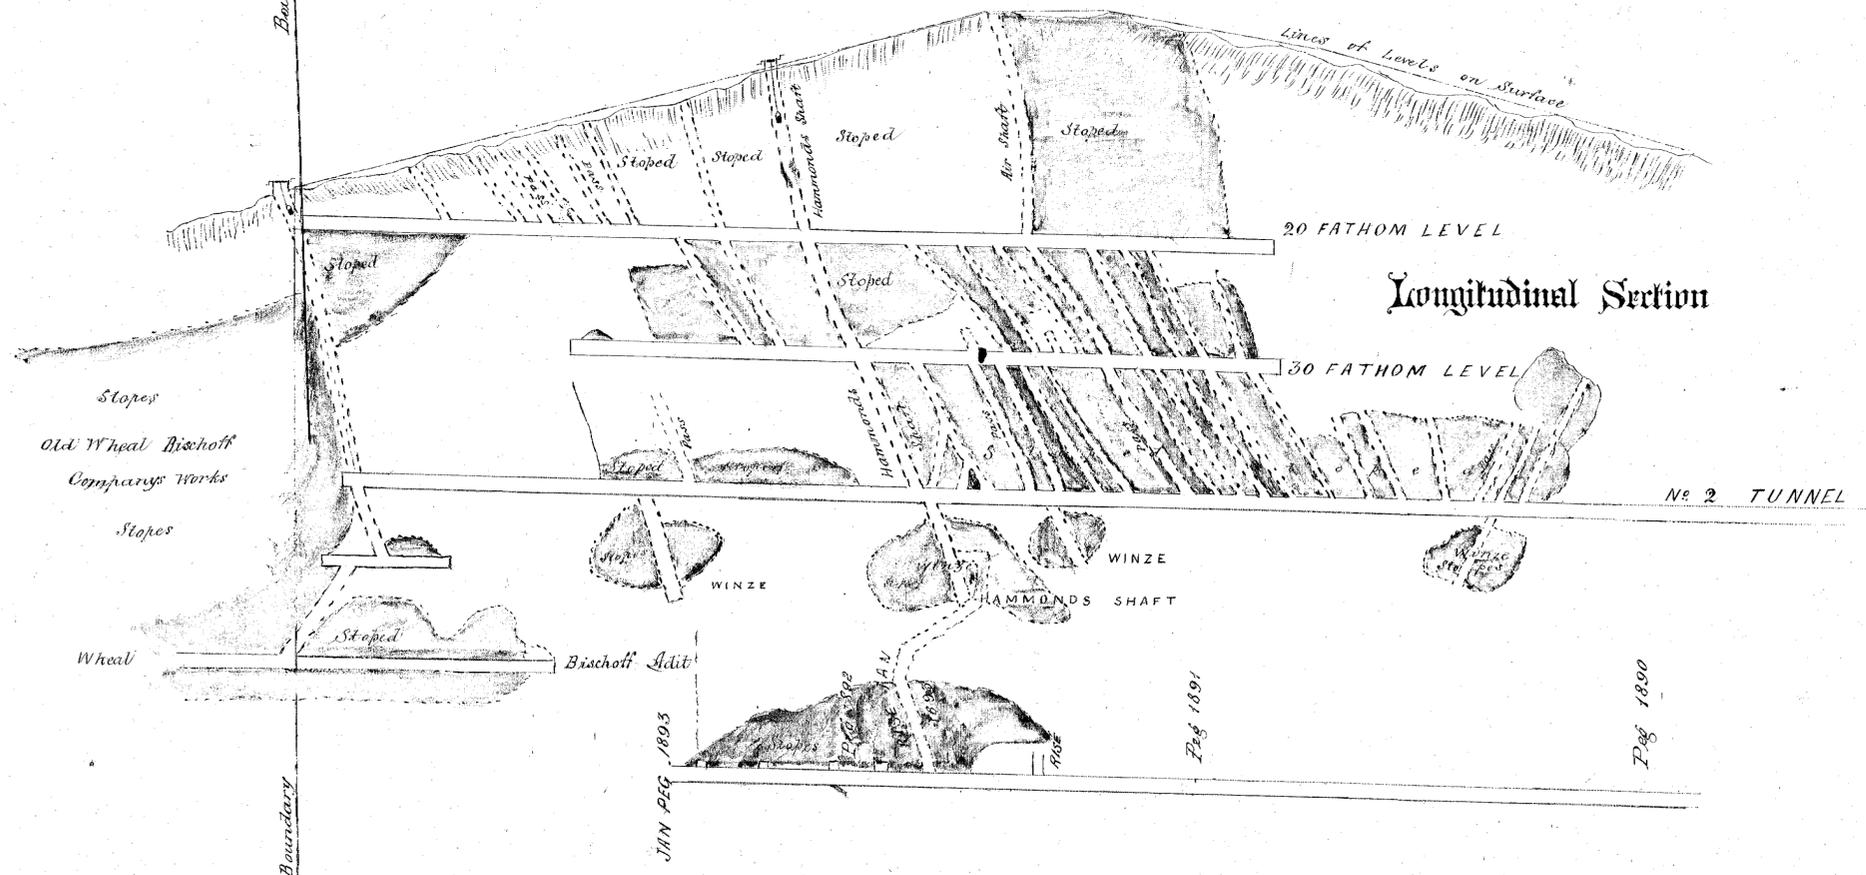

Longitudinal Section

217-139