

5 cm

217-140

# PLAN


OF

## STANHOPE T. M. COMPANYS

### UNDERGROUND WORKS

Scale 50 Feet to one Inch

1893

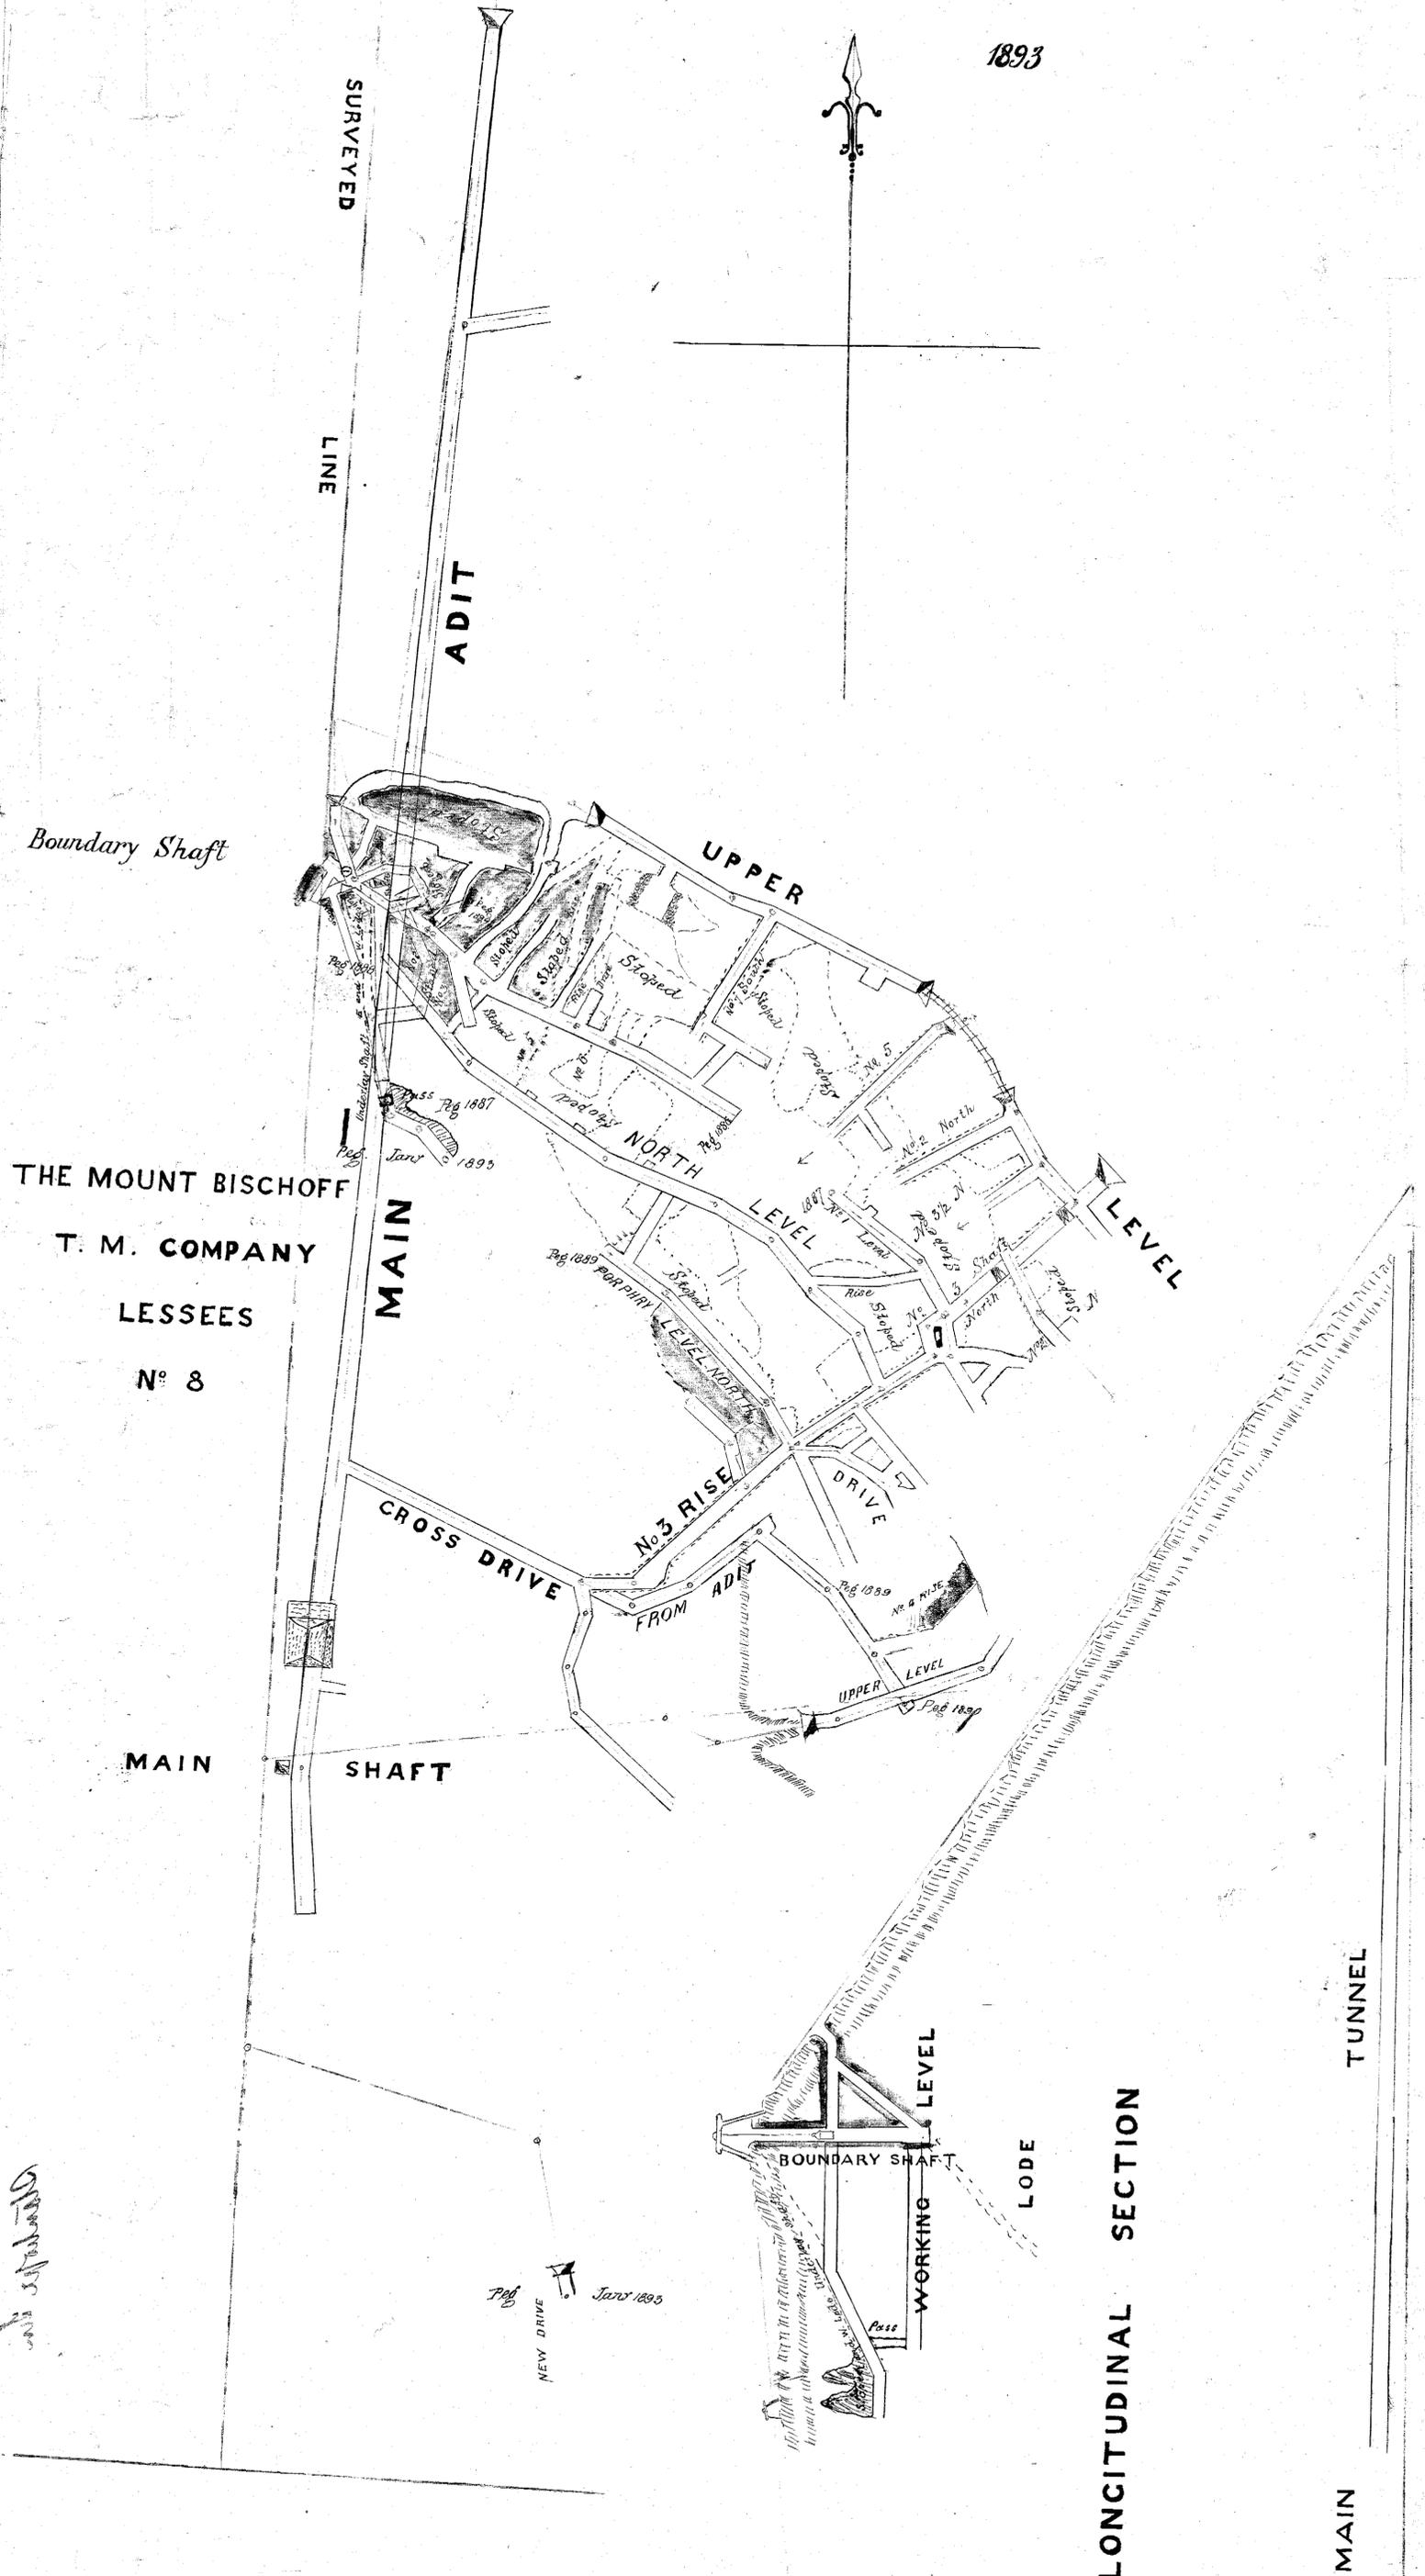

THE MOUNT BISCHOFF  
 T. M. COMPANY  
 LESSEES  
 No 8

LONGITUDINAL SECTION

TUNNEL

MAIN

*and shafts*