

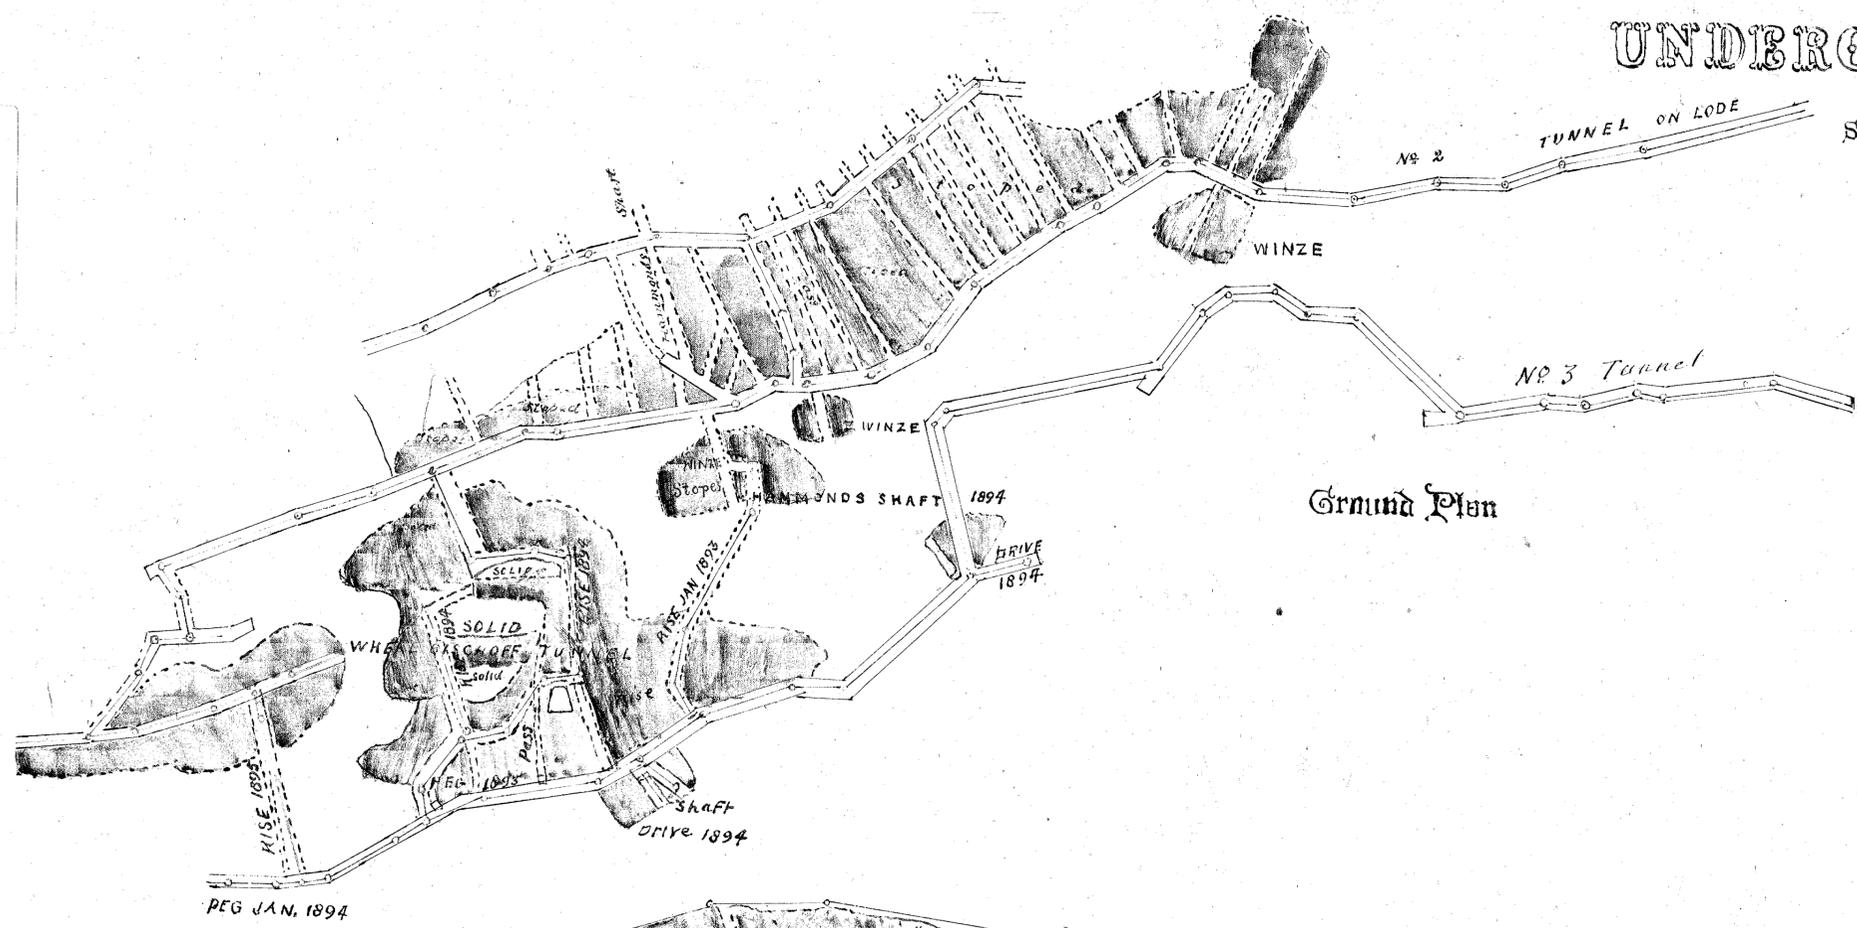


# THE WEST BISCHOFF T. M. CO'S. UNDERGROUND WORKS.

217-14

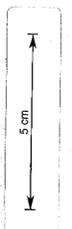


Scale 50 Feet to one Inch

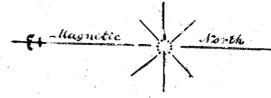

Ground Plan

217-14

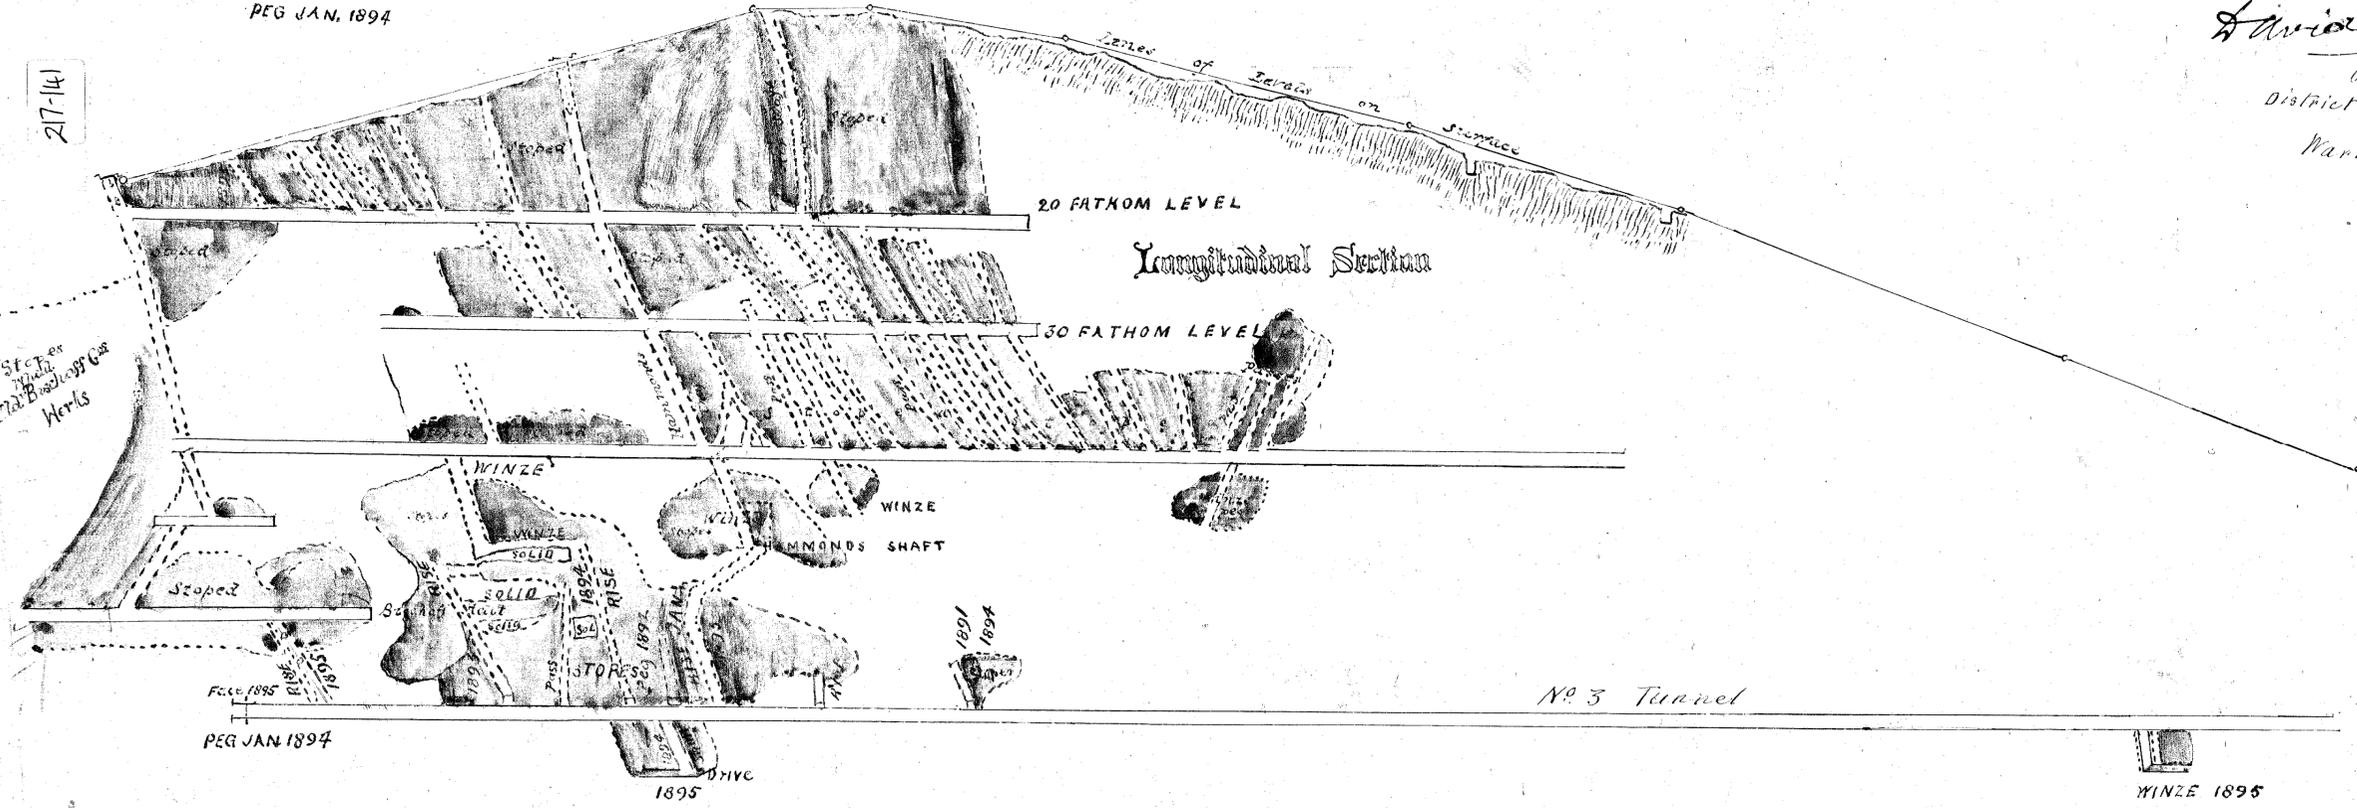

Longitudinal Section

*David Jones*  
District Surveyor  
Natal Jan. 1895

West Bischoff T.M. Co's.