


# THE WEST BISCHOFF T. M. CO's. UNDERGROUND WORKS.

Scale 50 Feet to one Inch.



1885 1886 1888

27-142

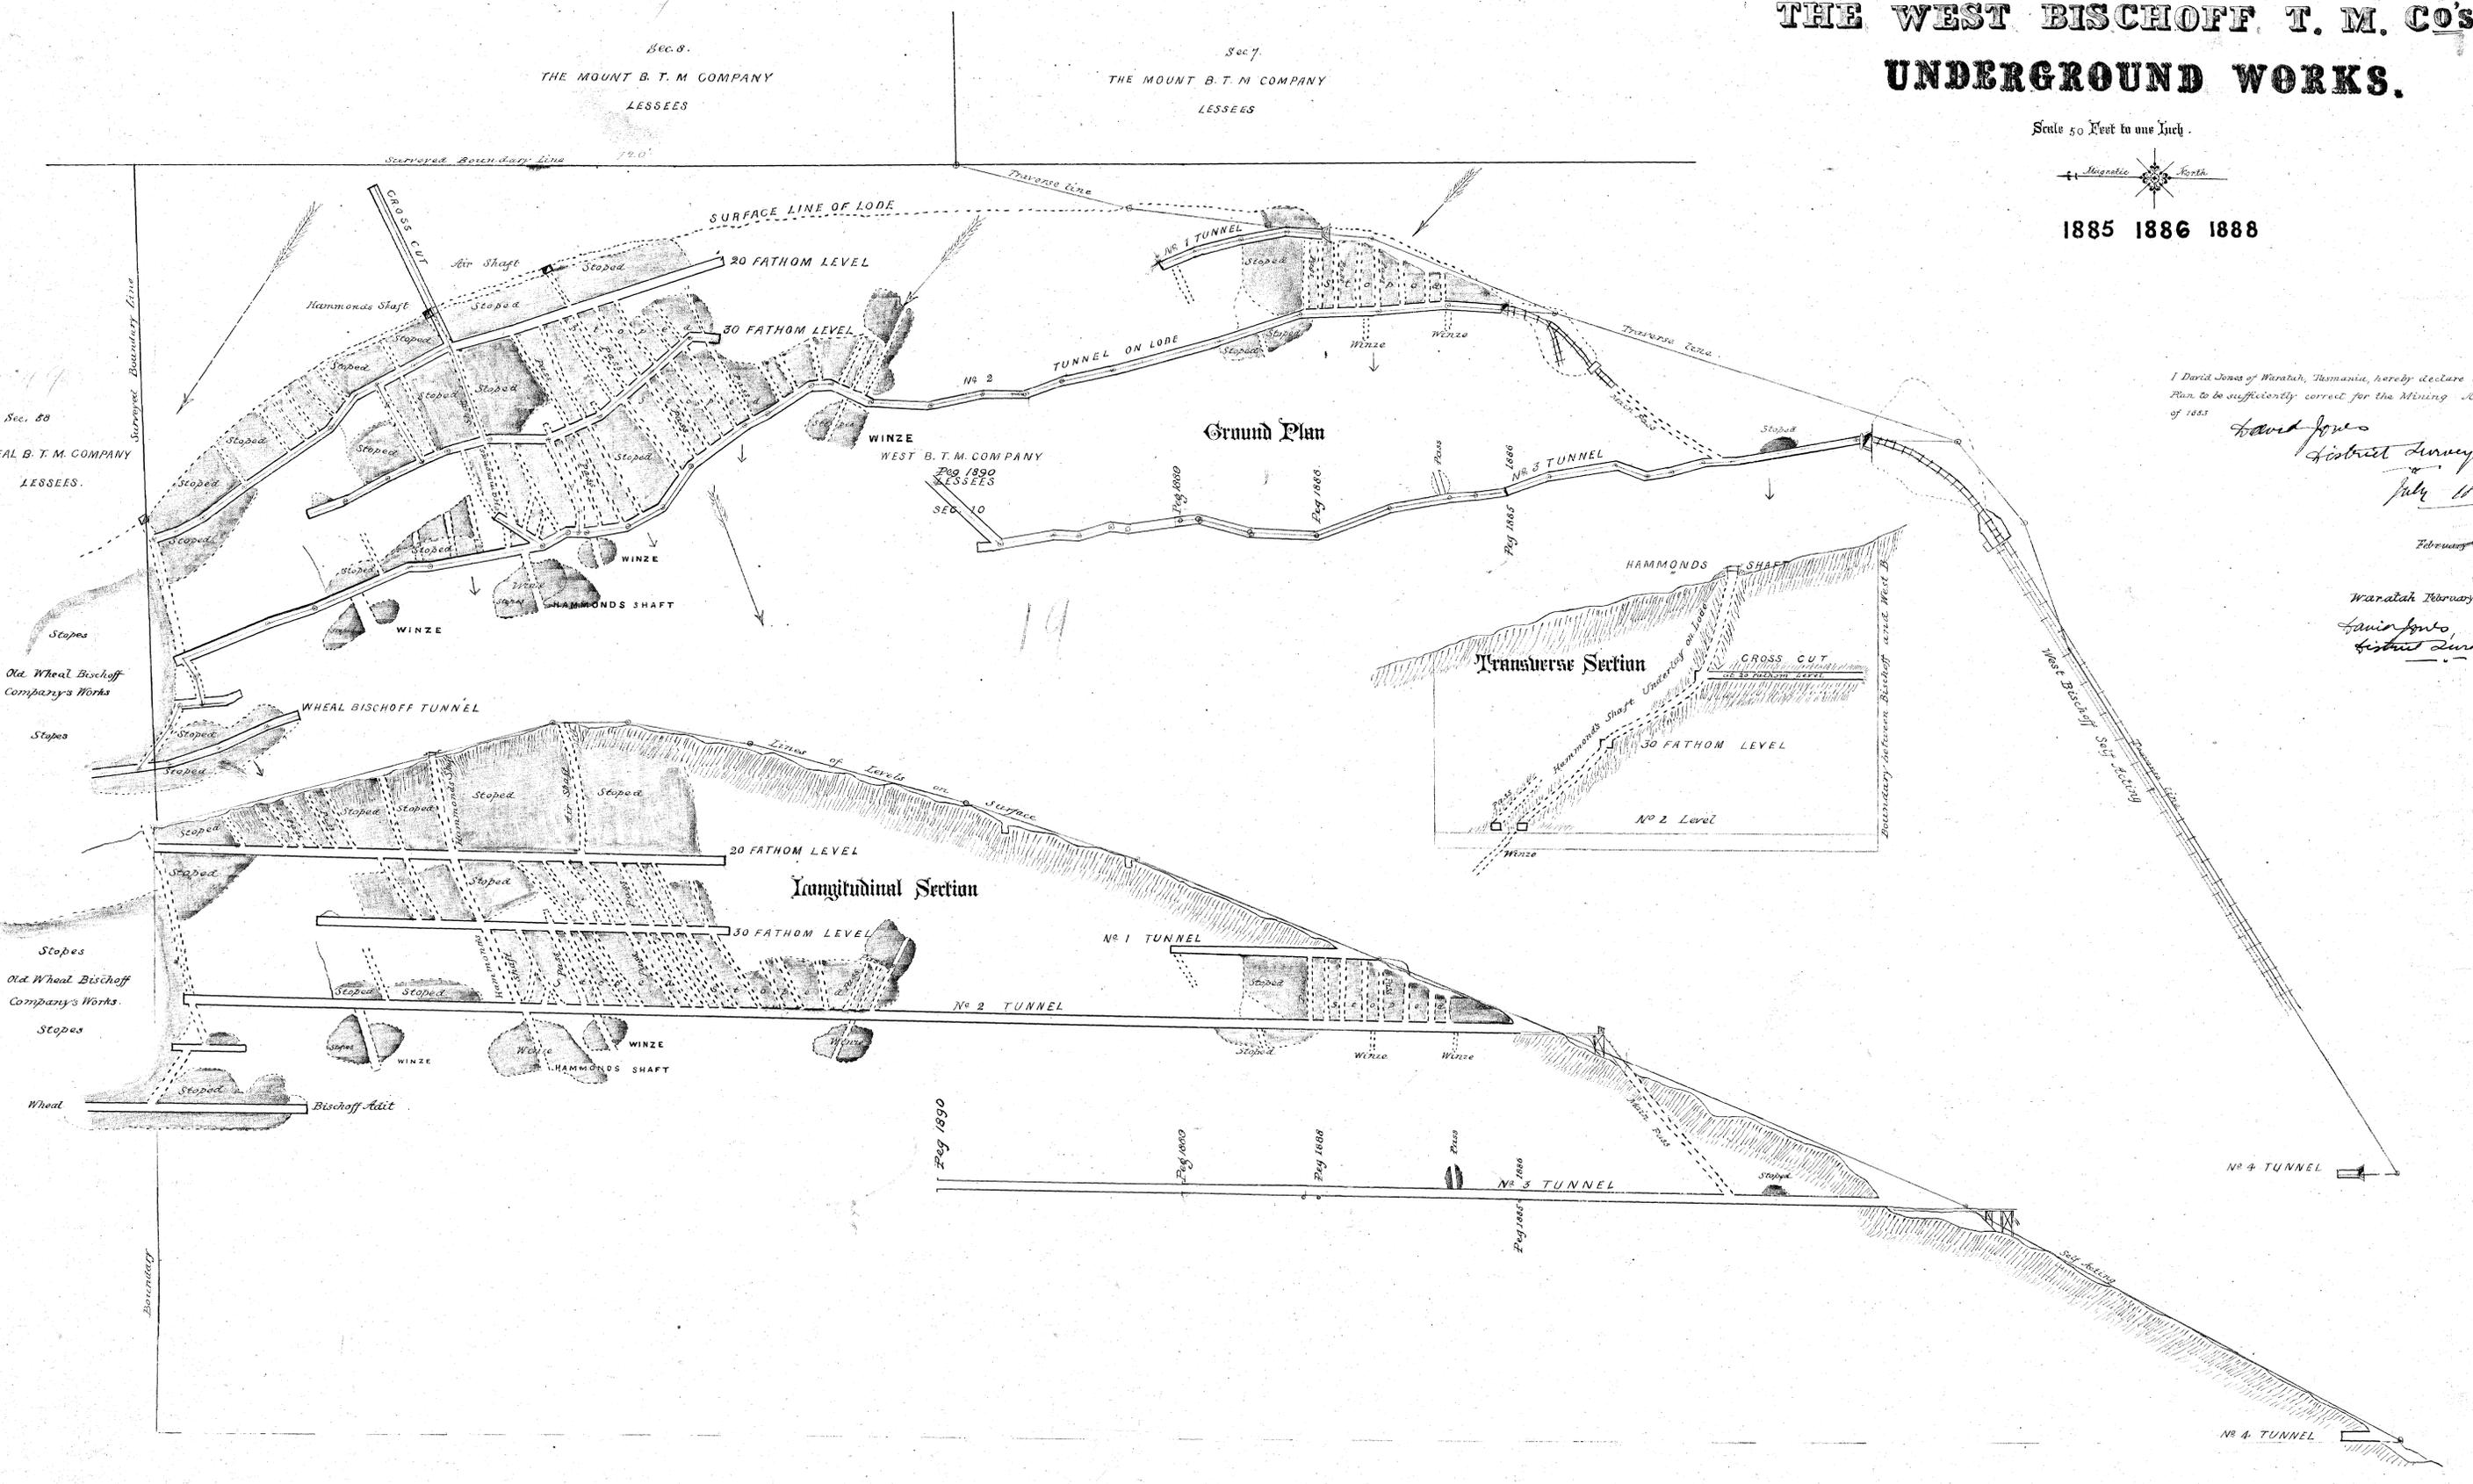

I David Jones of Waratah, Tasmania, hereby declare this Plan to be sufficiently correct for the Mining Act of 1885.  
David Jones  
District Surveyor  
July 1885.  
February 1888.

Waratah February 1890  
David Jones  
District Surveyor

19

27-142