

217-143


THE MOUNT BISCHOFF T. M. COMPANYS UNDERGROUND WORKS.

Scale 50 Feet to one Inch



TRANSVERSE SECTION


3

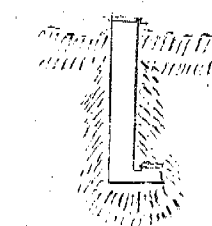

LONGITUDINAL SECTION

TRANSVERSE SECTION

1

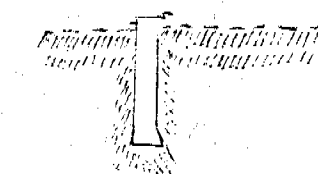

LONGITUDINAL SECTION

LEVEL OF BROWN FACE

1

BROWN FACE DRIVE

WARATAH 1895


W. J. J. J.

District Surveyor
Jan 30th 1895

Face 1895

NORTH ENTRANCE

MAIN TUNNEL THROUGH MOUNT

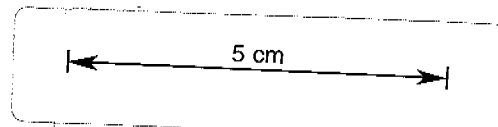

Dls-1378 10

Peg 1890

WESTERN CROSS CUT

MAIN TUNNEL