




Section

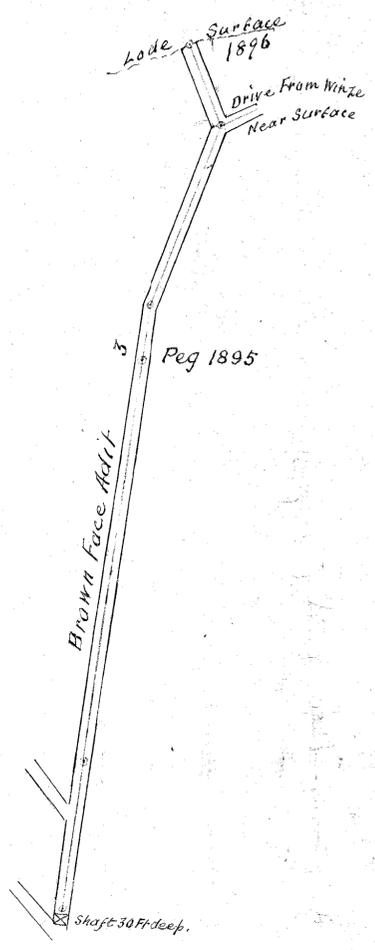



Extension of
 Mt Bischoff Underground Works
 For 1896

Wm J. Jones
 District Surveyor,
 25: 1: 96.


217-144

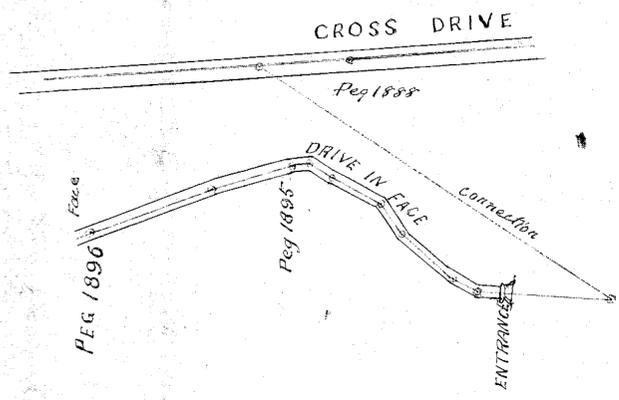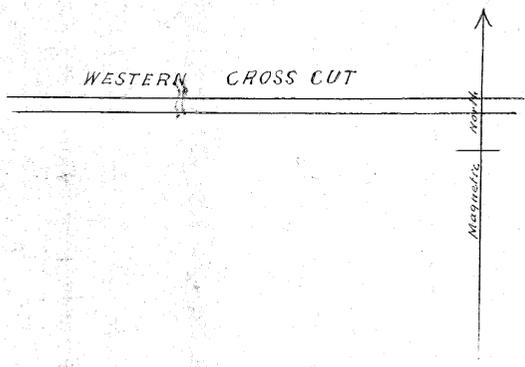

217-144

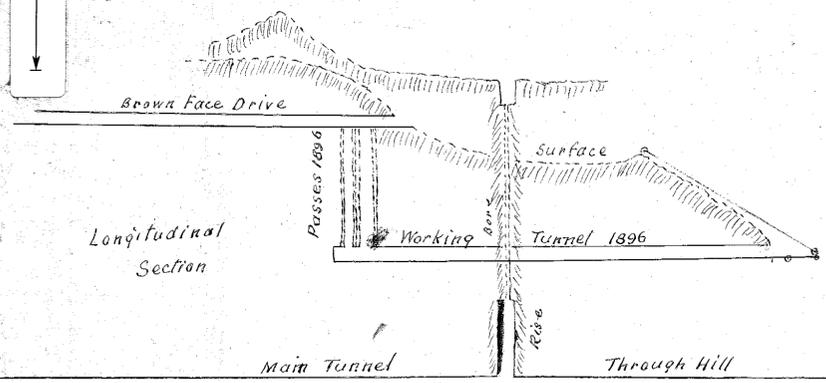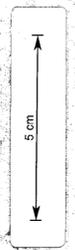

Longitudinal Section

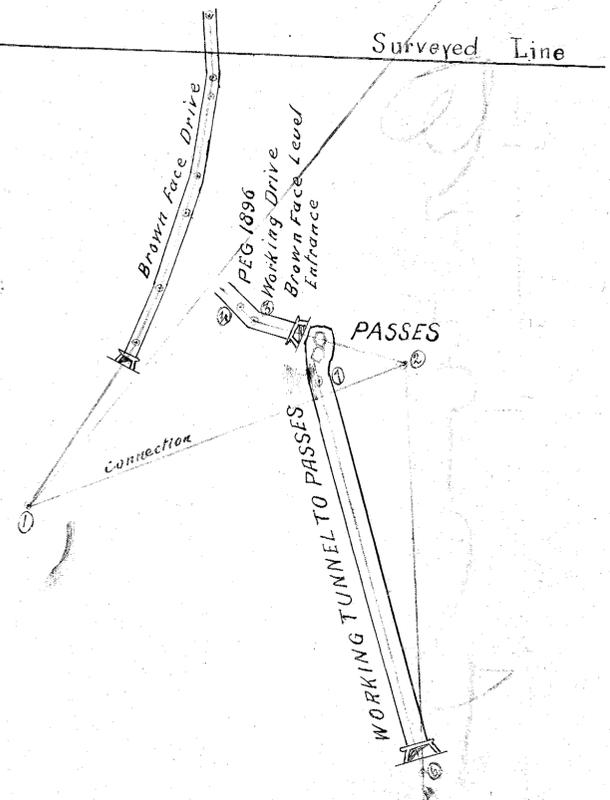

Wm J. Jones
 25: 1: 96