



# PLAN OF THE MT BISCHOFF T. M. COMPANY'S UNDERGROUND WORKS

Scale 50 Feet to one Inch

18 97

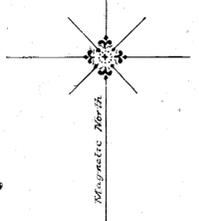

*Harold Jones  
District Surveyor  
Promoter,  
25: 1: 97*

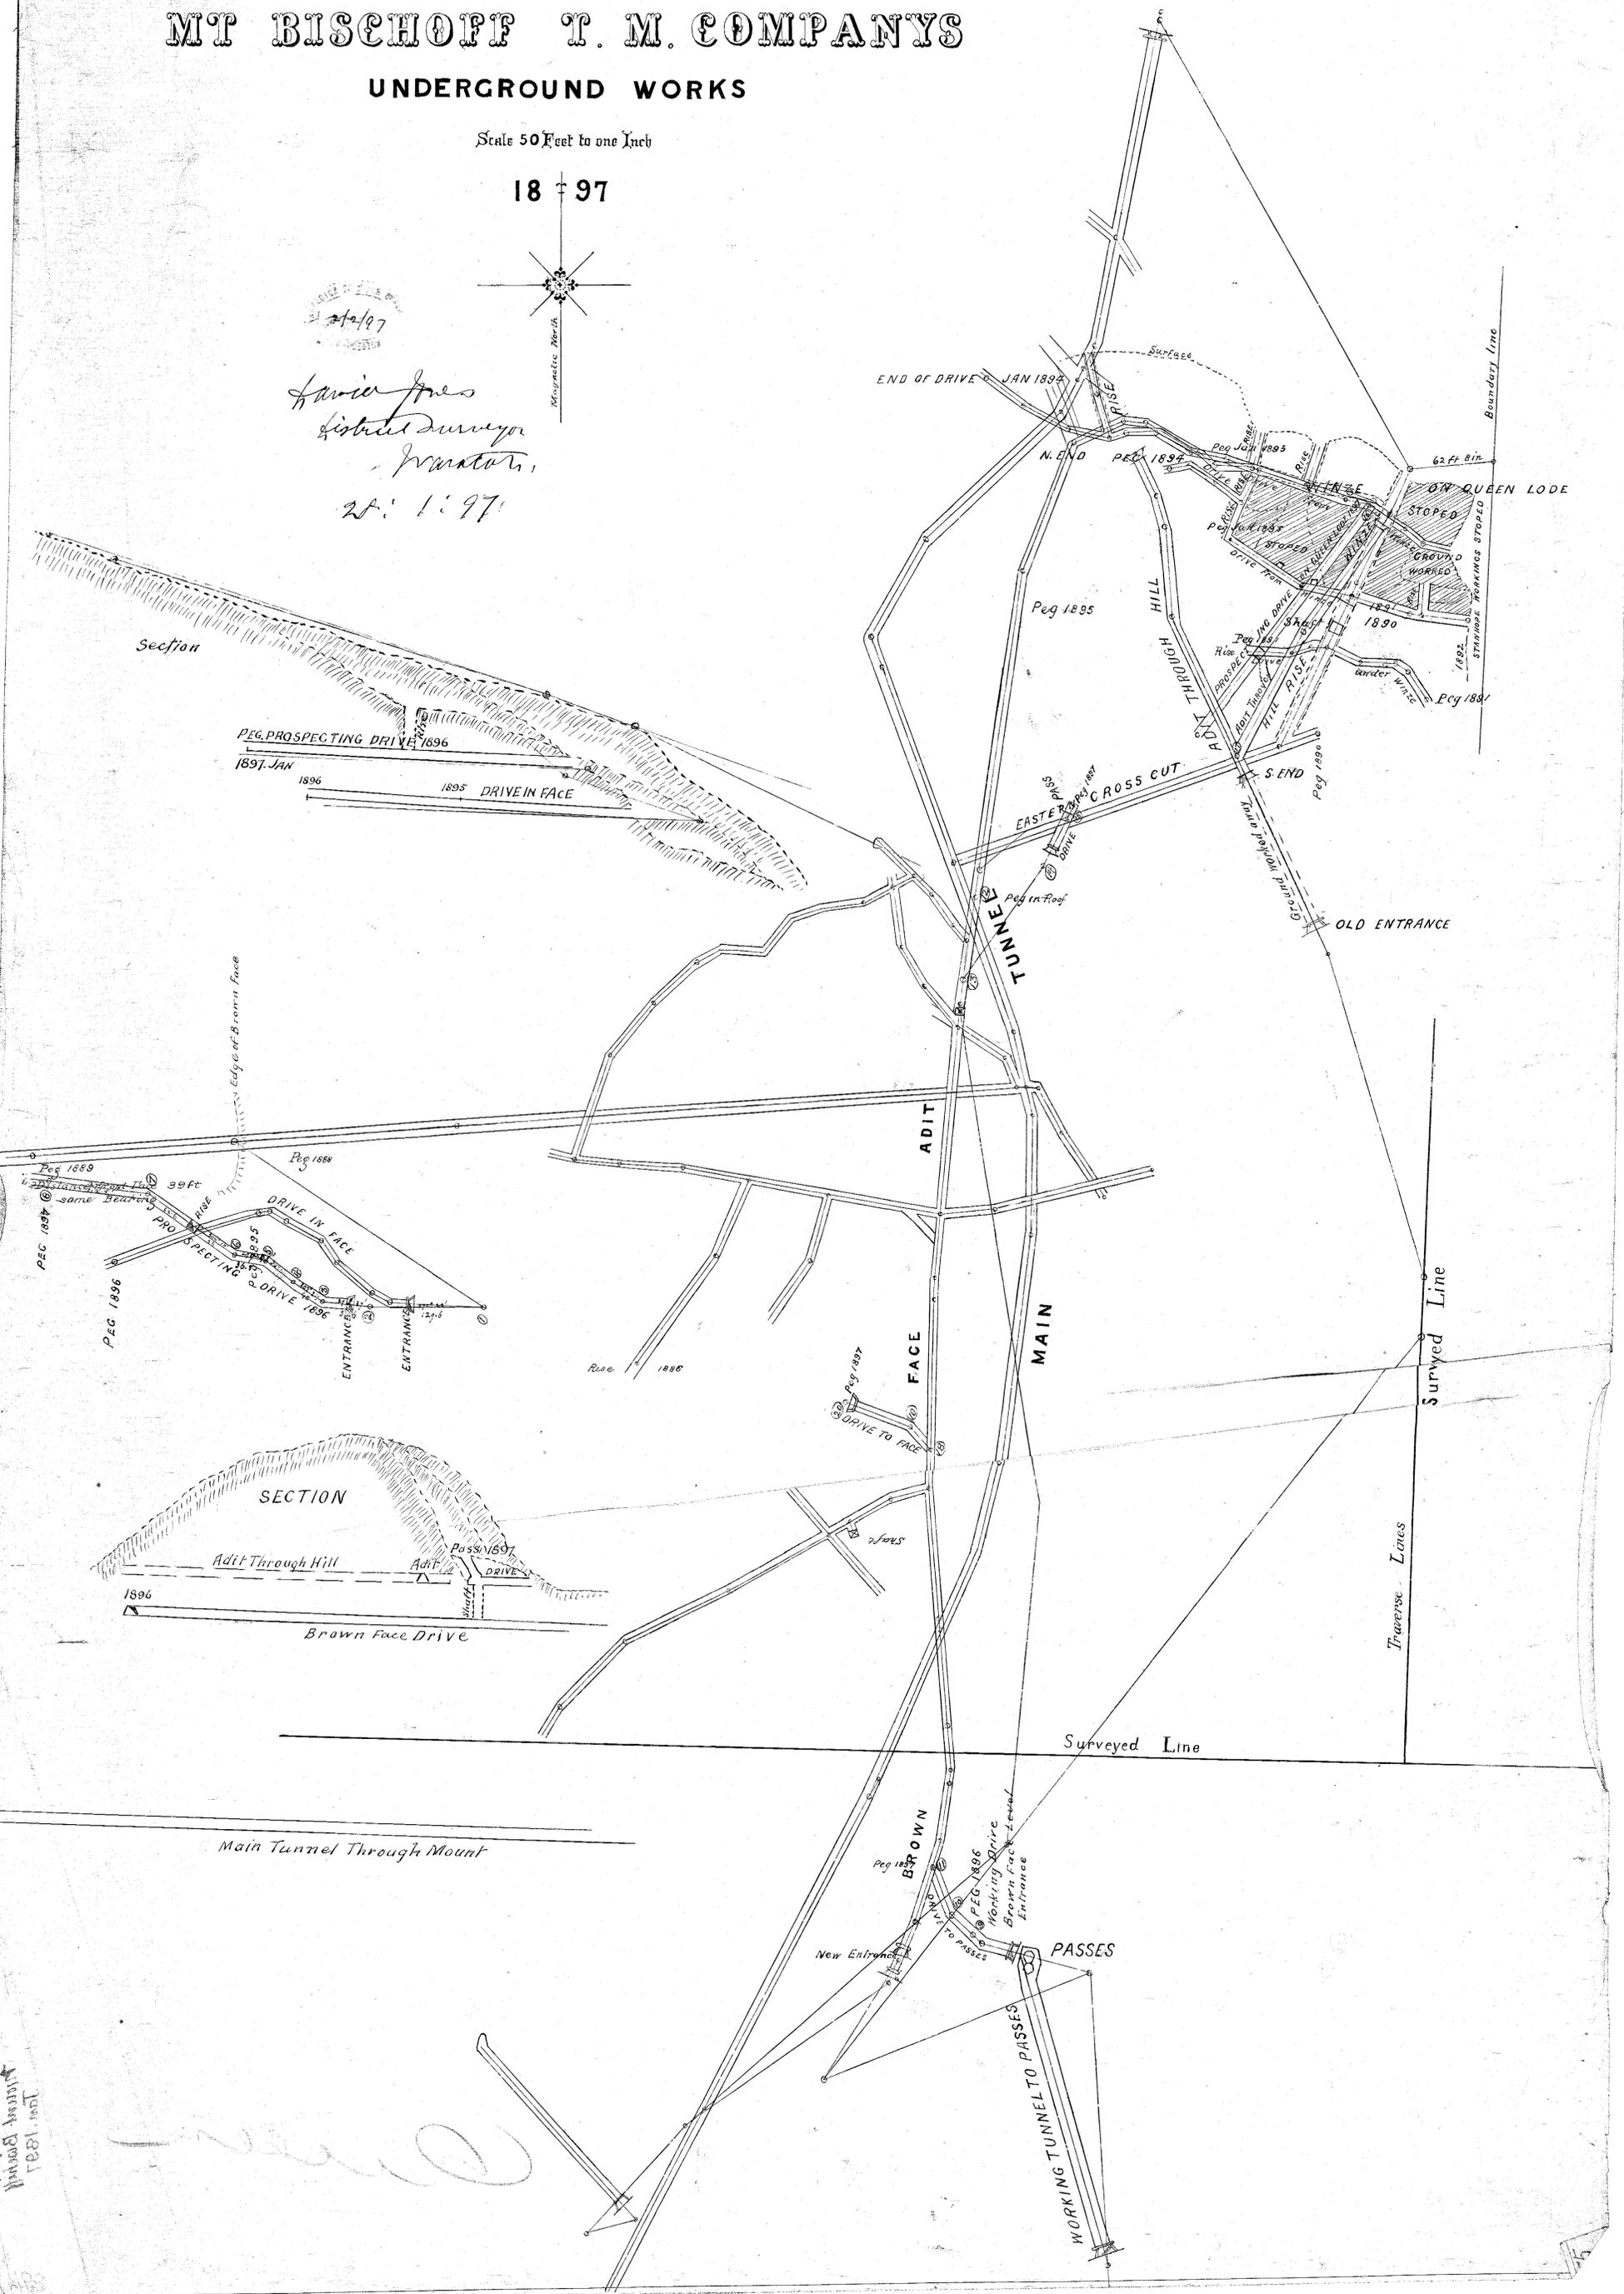

*Harold Jones  
Jan 1897*

*[Handwritten signature]*